


**LEGEND**

- PROPOSED ROW
- PROPOSED STORM DRAIN
- DRAINAGE EASEMENT
- TEMP SLOPE EASEMENT
- INLET

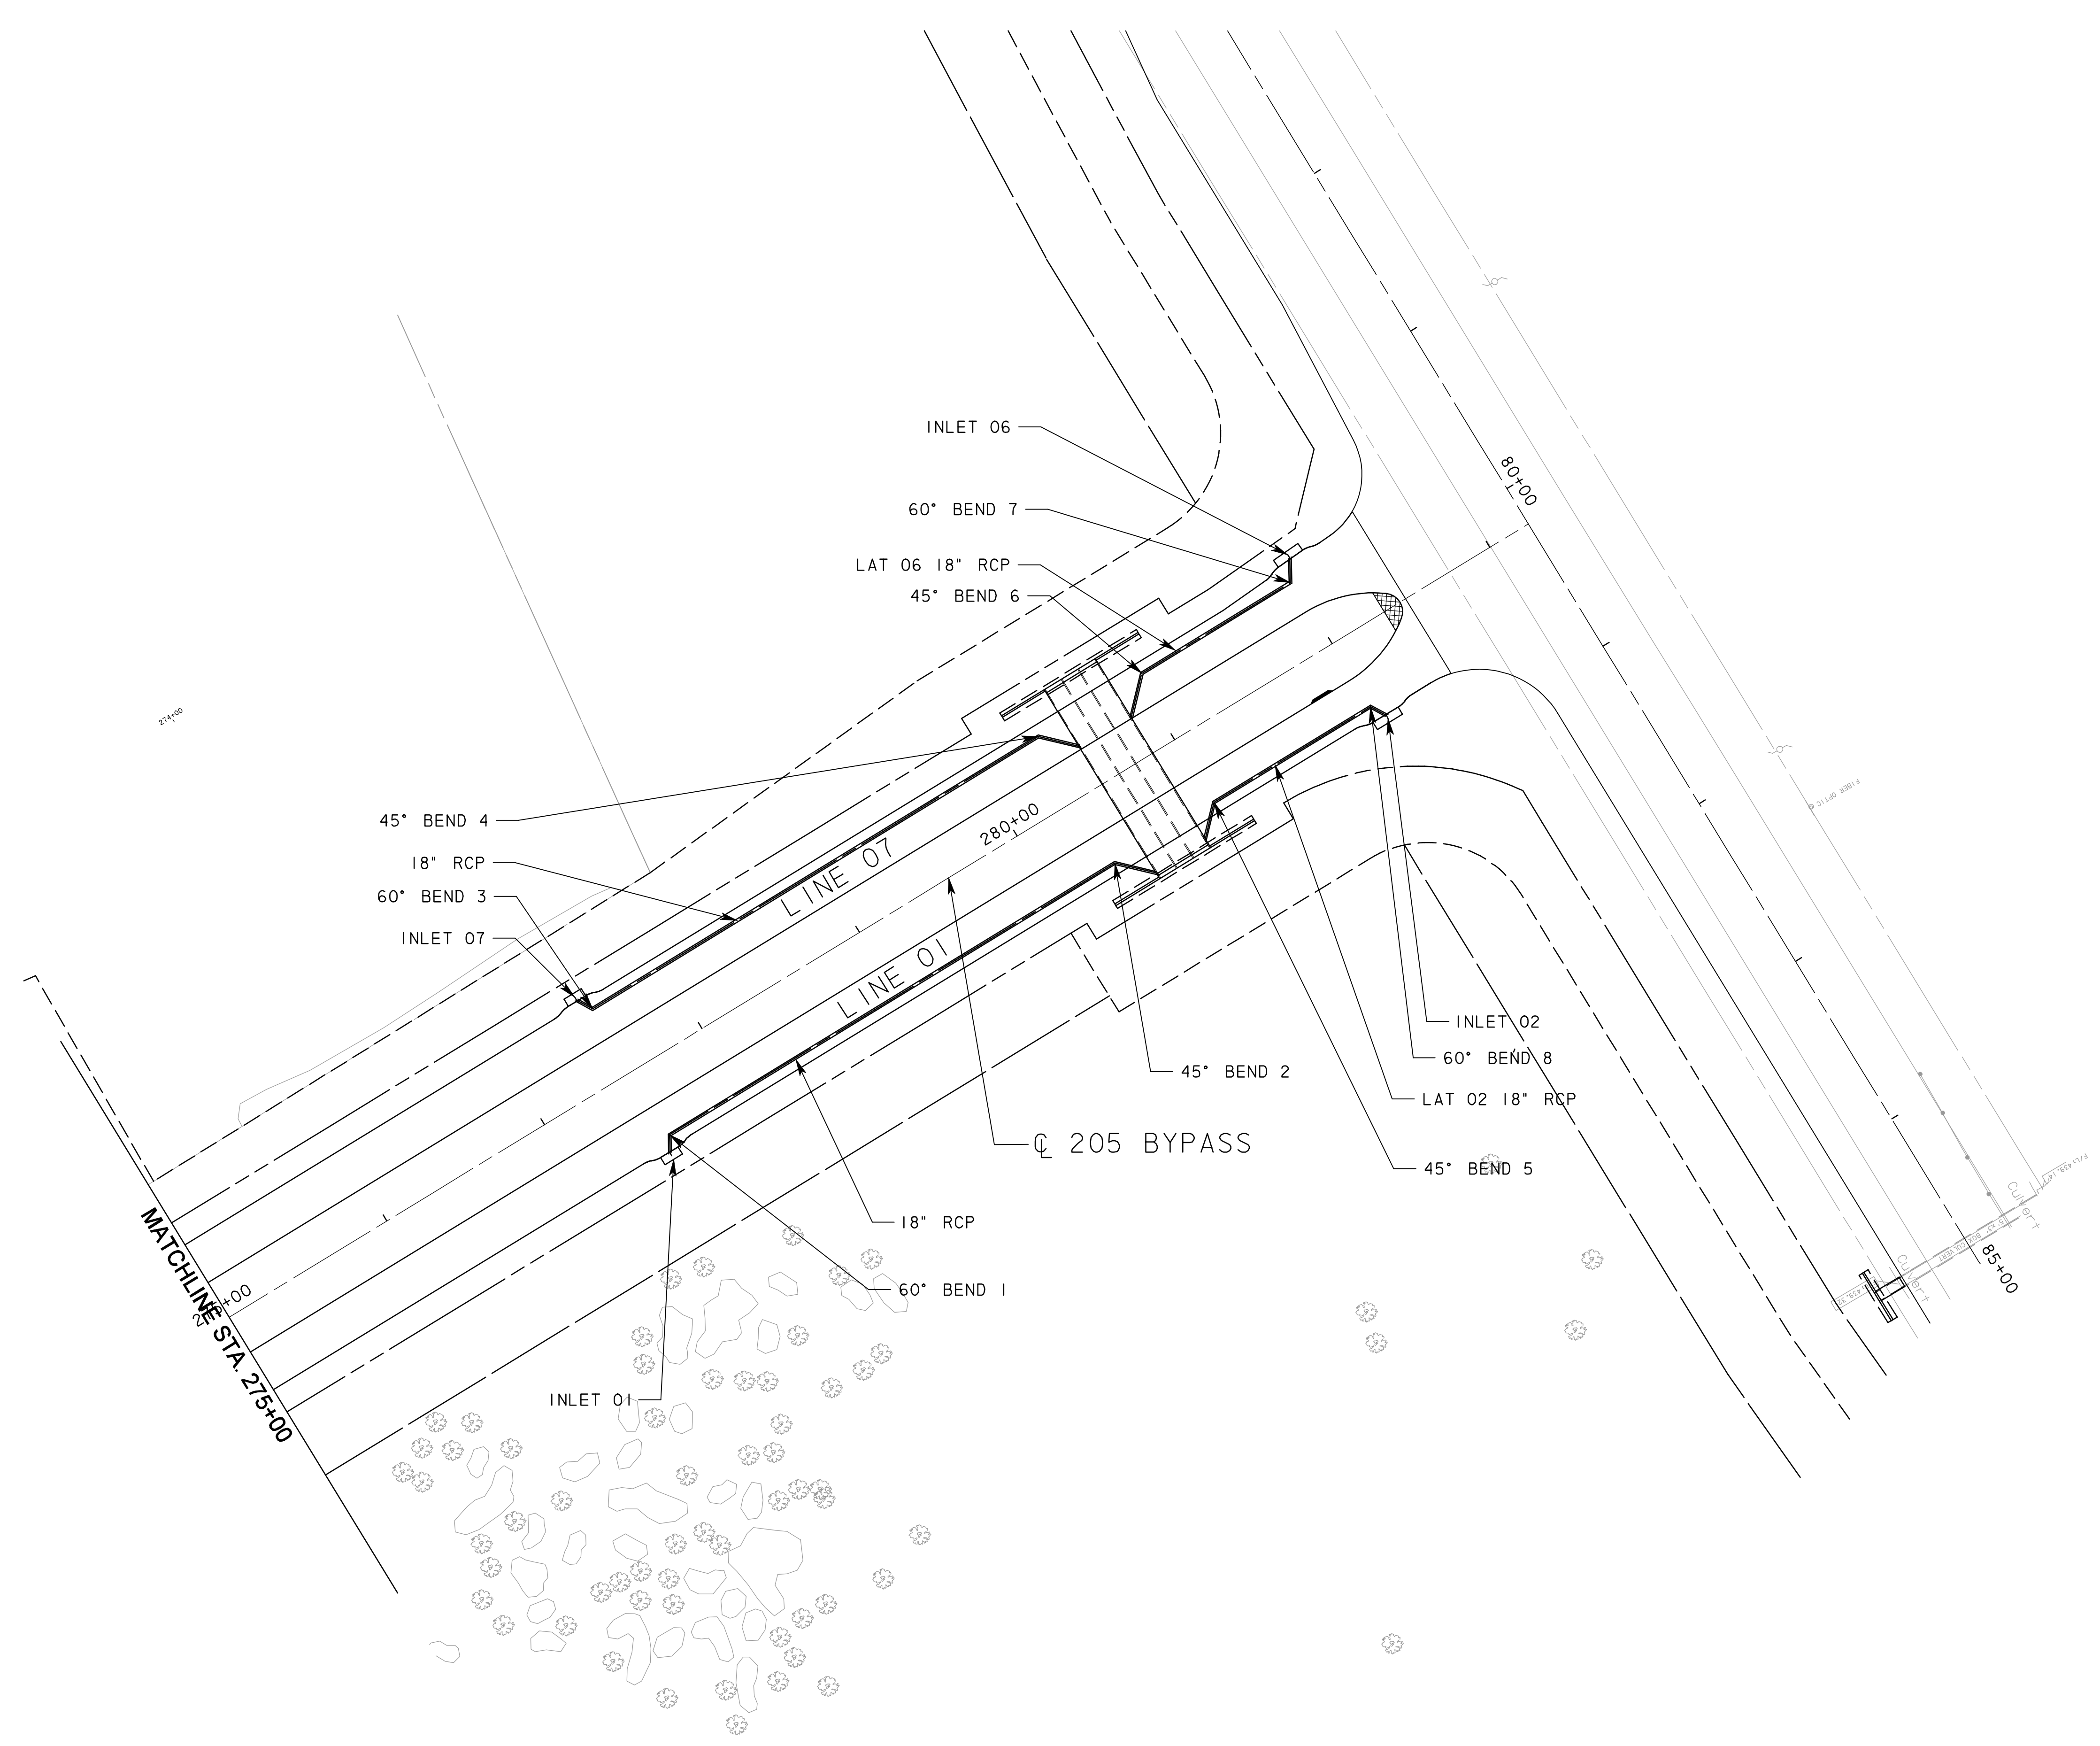

**RECORD DRAWING**

This drawing is a compilation of the original sealed engineering drawing and modifications by addenda, change orders and information furnished by the contractor. Information shown that was provided by the contractor and others not associated with the design engineer cannot be verified for accuracy or completeness. Original sealed drawing is on file at the office of AECOM USA Group, Inc., TBPE REG. NO. F-3082

ORIGINAL DRAWING  
SEALED & SIGNED BY  
T.H. Gaertner, P.E.  
TX NO. 37124

NO.	REVISION	BY	DATE
1	LATERAL 02 AND LATERAL 06	THG	07/02/08

**City of Rockwall, Texas**  
**205 BYPASS**  
**PHASE 6**  
**STORM PLAN**  
**STA. 275+00 TO STA. 285+00**

TCB INC.  
 WWW.TCB.AECOM.COM  
 17300 DALLAS PARKWAY, SUITE 1010  
 DALLAS, TEXAS 75248

Unit	PW-DAL-FW	Scale	Horz: AS SHOWN Vert: AS SHOWN	Date	11/24/2009
Designed	SB/US	Checked	TCB	Project No.	60004153
Drawn	FG	Approved	TCB	Sheet	98A of 216

P:\328\60004153-205bypass\cadd\sheet6\phase 6 - fm52 to 205\record drawing 10\_7\_09\08BASform.Plan-08.dgn  
 11/24/2009