

NOTES:

1. FLOWLINE ELEVATIONS AND GRADES ARE CALCULATED FROM CENTER TO CENTER OF PROPOSED DRAINAGE STRUCTURES. PIPE LENGTHS ON PLANS ARE ACTUAL LENGTHS USED IN QUANTITY TAKEOFFS.
2. ALL UTILITIES SHOWN ARE APPROXIMATE AND SHOULD BE FIELD VERIFIED AS TO THE LOCATION AND DEPTH PRIOR TO CONSTRUCTION.
3. ALL STORM DRAIN PIPE IS CLASS III UNLESS OTHERWISE NOTED.
4. THE CONTROL POINT FOR RECESSED CURB INLETS IS AT THE CENTER OF THE OUTSIDE FACE OF THE INLET.
5. FOR RECESSED CURB INLETS, VARIABLE DIMENSION "W," AS SHOWN ON THE NCTCOG STANDARDS, SHALL BE 3.5-FT.
6. CONTRACTOR TO INSTALL CEMENT TREATED BACKFILL TO THE SPRINGLINE OF THE DRAINAGE PIPE FOR SLOPES GREATER THAN 10%.

**RECORD DRAWING**

This drawing is a compilation of the original sealed engineering drawing and modifications by addenda, change orders and information furnished by the contractor. Information shown that was provided by the contractor and others not associated with the design engineer cannot be verified for accuracy or completeness. Original sealed drawing is on file at the office of AECOM USA Group, Inc., TBPE REG. NO. F-3082

ORIGINAL DRAWING SEALED & SIGNED BY  
Matthew L. Abbe, P.E.  
TX NO. 92715

NO.	REVISION	BY	DATE



City of Rockwall, Texas




205 BYPASS  
PHASE 6

STORM DRAIN PROFILE  
LINES K4, M10, K8, and L9

2 OF 4

TCB AECOM  
TCB INC.  
WWW.TCB.AECOM.COM  
17300 DALLAS PARKWAY, SUITE 1010  
DALLAS, TEXAS 75248

Unit	PW-DAL-FW	Scale	Horz: AS SHOWN Vert: AS SHOWN	Date	11/24/2009
Designed	RI/AR	Checked	TCB	Project No.	60004153
Drawn	FG	Approved	TCB	Sheet	101 of 216

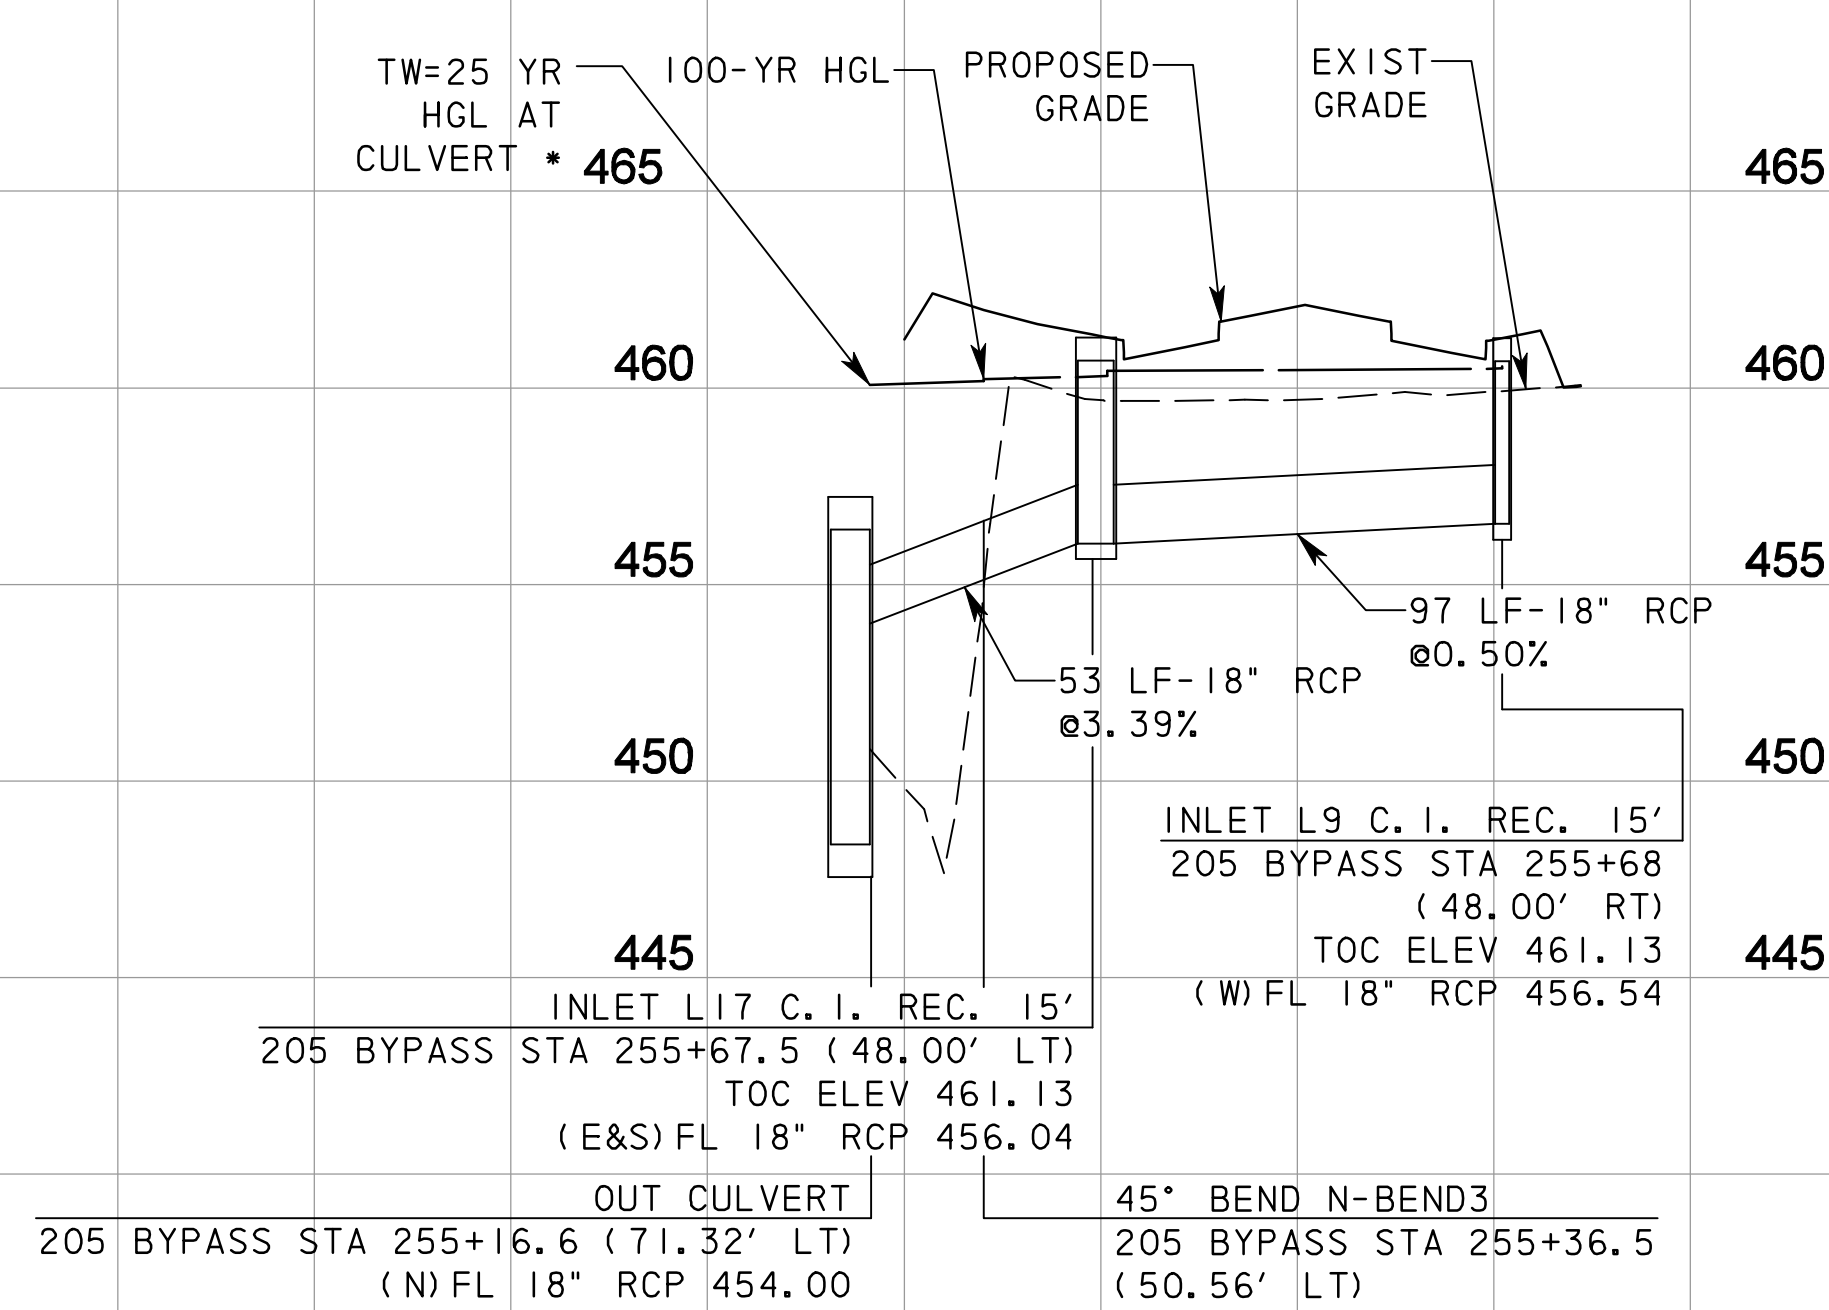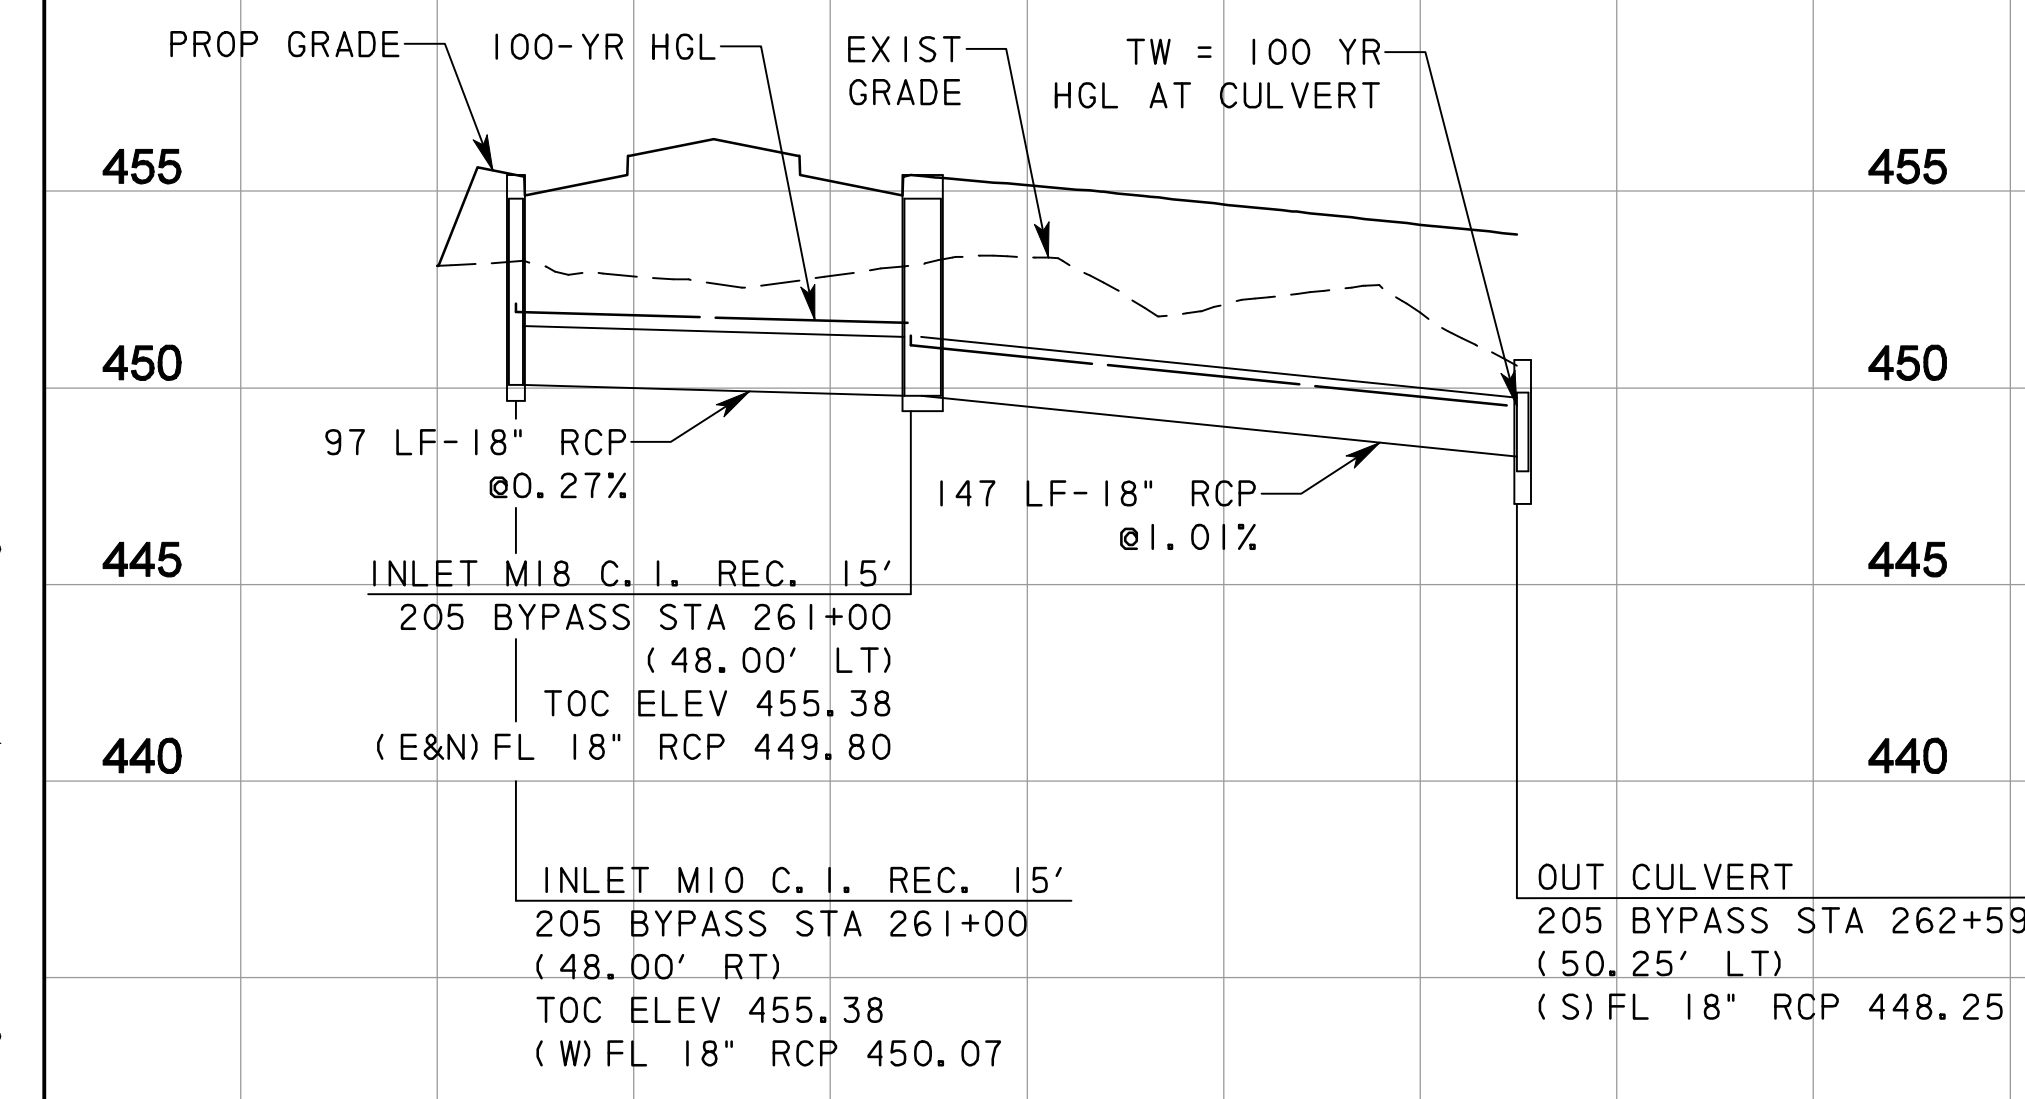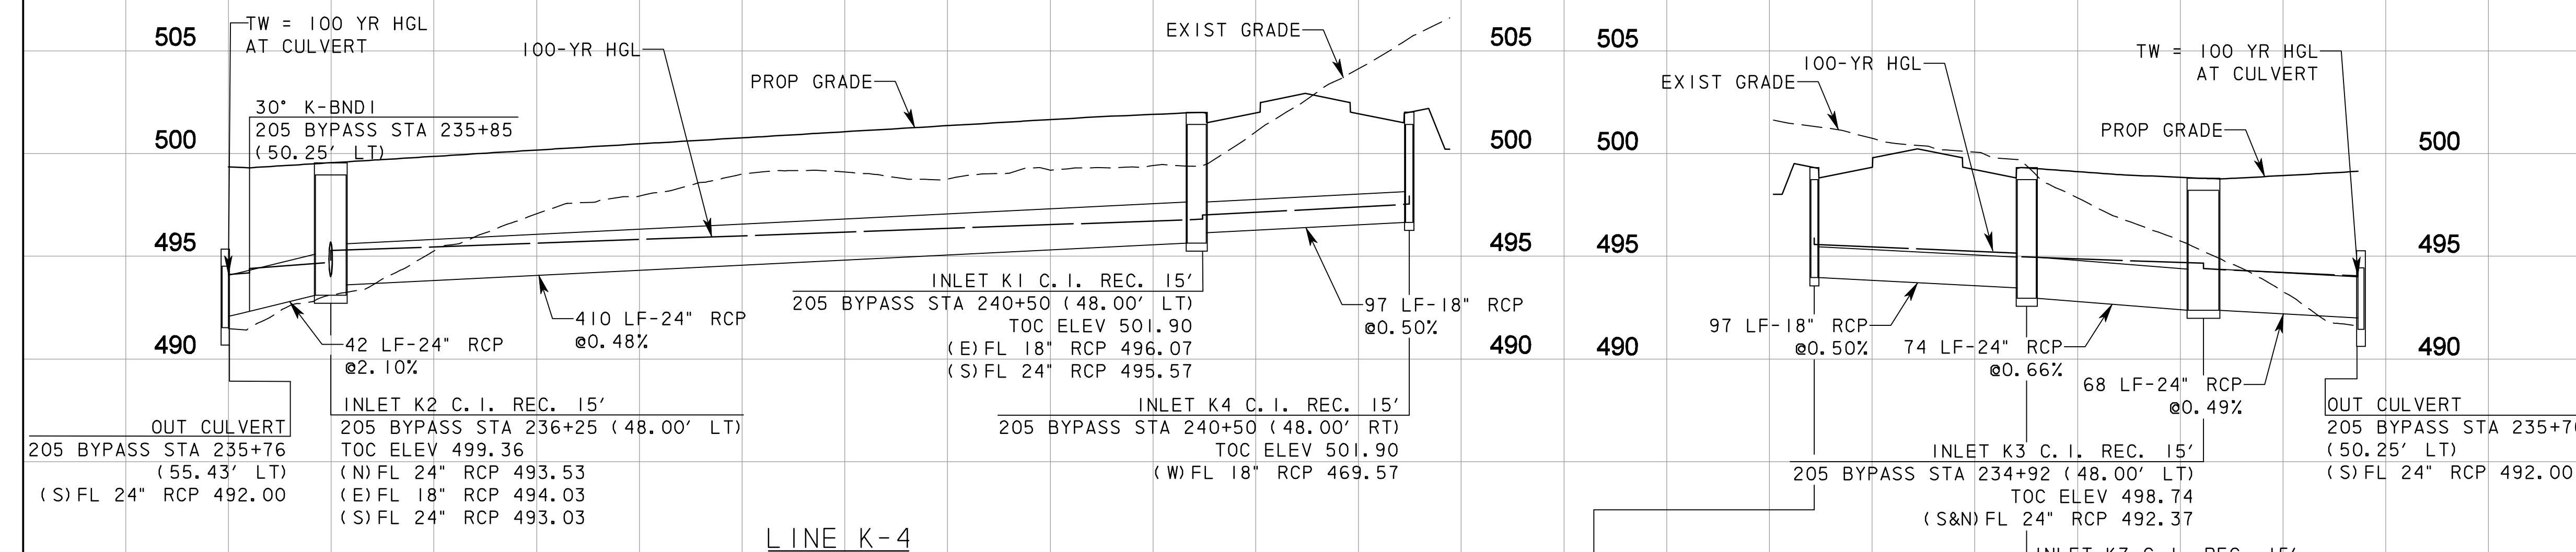

\*25-YR STORM THROUGH THIS CULVERT WAS USED AS THE COINCIDENT FLOW TO THE 100-YR STORM FOR SYSTEM L-9.

P:\328\60004153-205bypass\cadd\sheet6\phase 6 - fms2 to 205\record drawing 10\_7\_09\101storm\_profile-02.dgn 11/24/2009