




P:\328\60004153-205bypass\cadd\sheet\phase 6 - fm52 to 205\record drawing 10_7_09\106\existing\ng\uf1s-01.dgn
11/24/2009

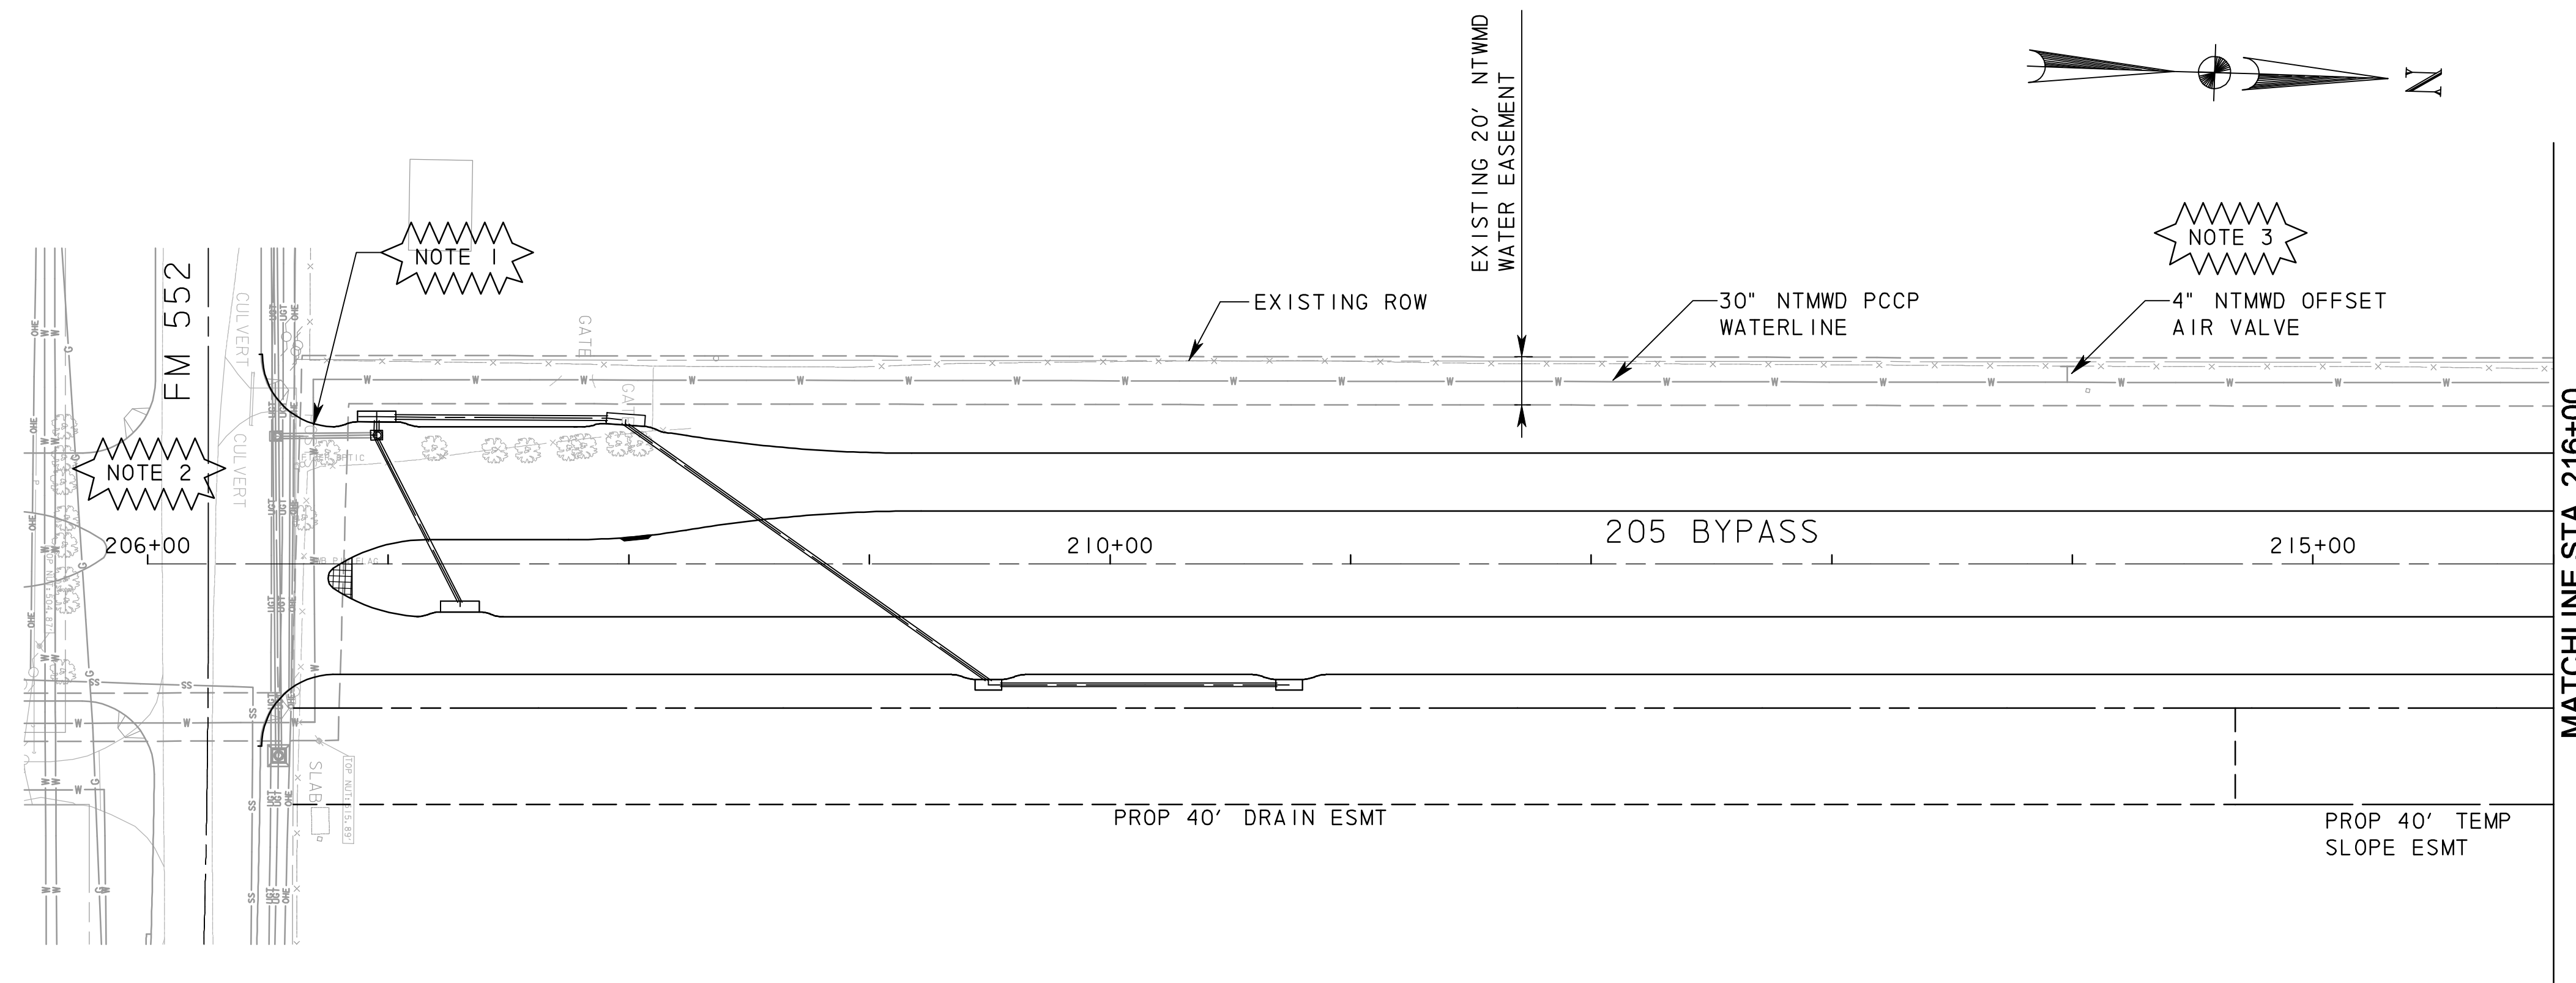

UNDERGROUND UTILITIES
THE LOCATION OF EXISTING UTILITIES SHOWN ON THESE PLANS ARE APPROXIMATE AND BASED ON DATA FURNISHED BY THE CITY OF ROCKWALL. IT IS THE RESPONSIBILITY OF THE CONTRACTOR TO LOCATE AND VERIFY ON-SITE THE UTILITIES THAT MAY CONFLICT WITH THE CONSTRUCTION.

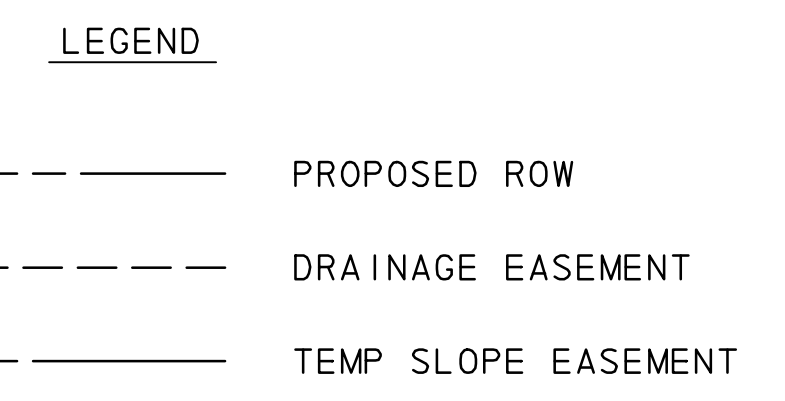

- UTILITY ADJUSTMENT NOTES:**
1. MAINTAIN A MINIMUM OF 3.5 FT CLEARANCE BETWEEN TOP OF WATER PIPES AND SUBGRADE.
 2. UTILITY POLE RELOCATION ALONG FM 552 IS BEING PERFORMED AS PART OF THE ADJACENT PHASE OF 205 BYPASS BY OTHERS. COORDINATE WITH FARMERS ELECTRIC CORP AT 903-455-1715 (TIM MACKEY) FOR ANY ADDITIONAL RELOCATIONS.
 3. PROTECT A/V RELEASE VALVE ASSEMBLY. SEE DETAIL 1 ON SHEET 9.
 4. PROTECT BLOWOFF ASSEMBLY. RAISE TO ADJUST AS NEEDED PER DETAIL 2, SHEET 9.
 5. SEE CULVERT SHEETS FOR EXISTING AND PROPOSED CULVERT CROSSING UNDER NTMWD WATERLINE AND ROADWAY.
 6. MAINTAIN A MINIMUM OF 1.0 FOOT VERTICAL CLEARANCE BETWEEN NTMWD AND DRAINAGE PIPING.
 7. REMOVE AND DISPOSE OF EXISTING 48" CMP.

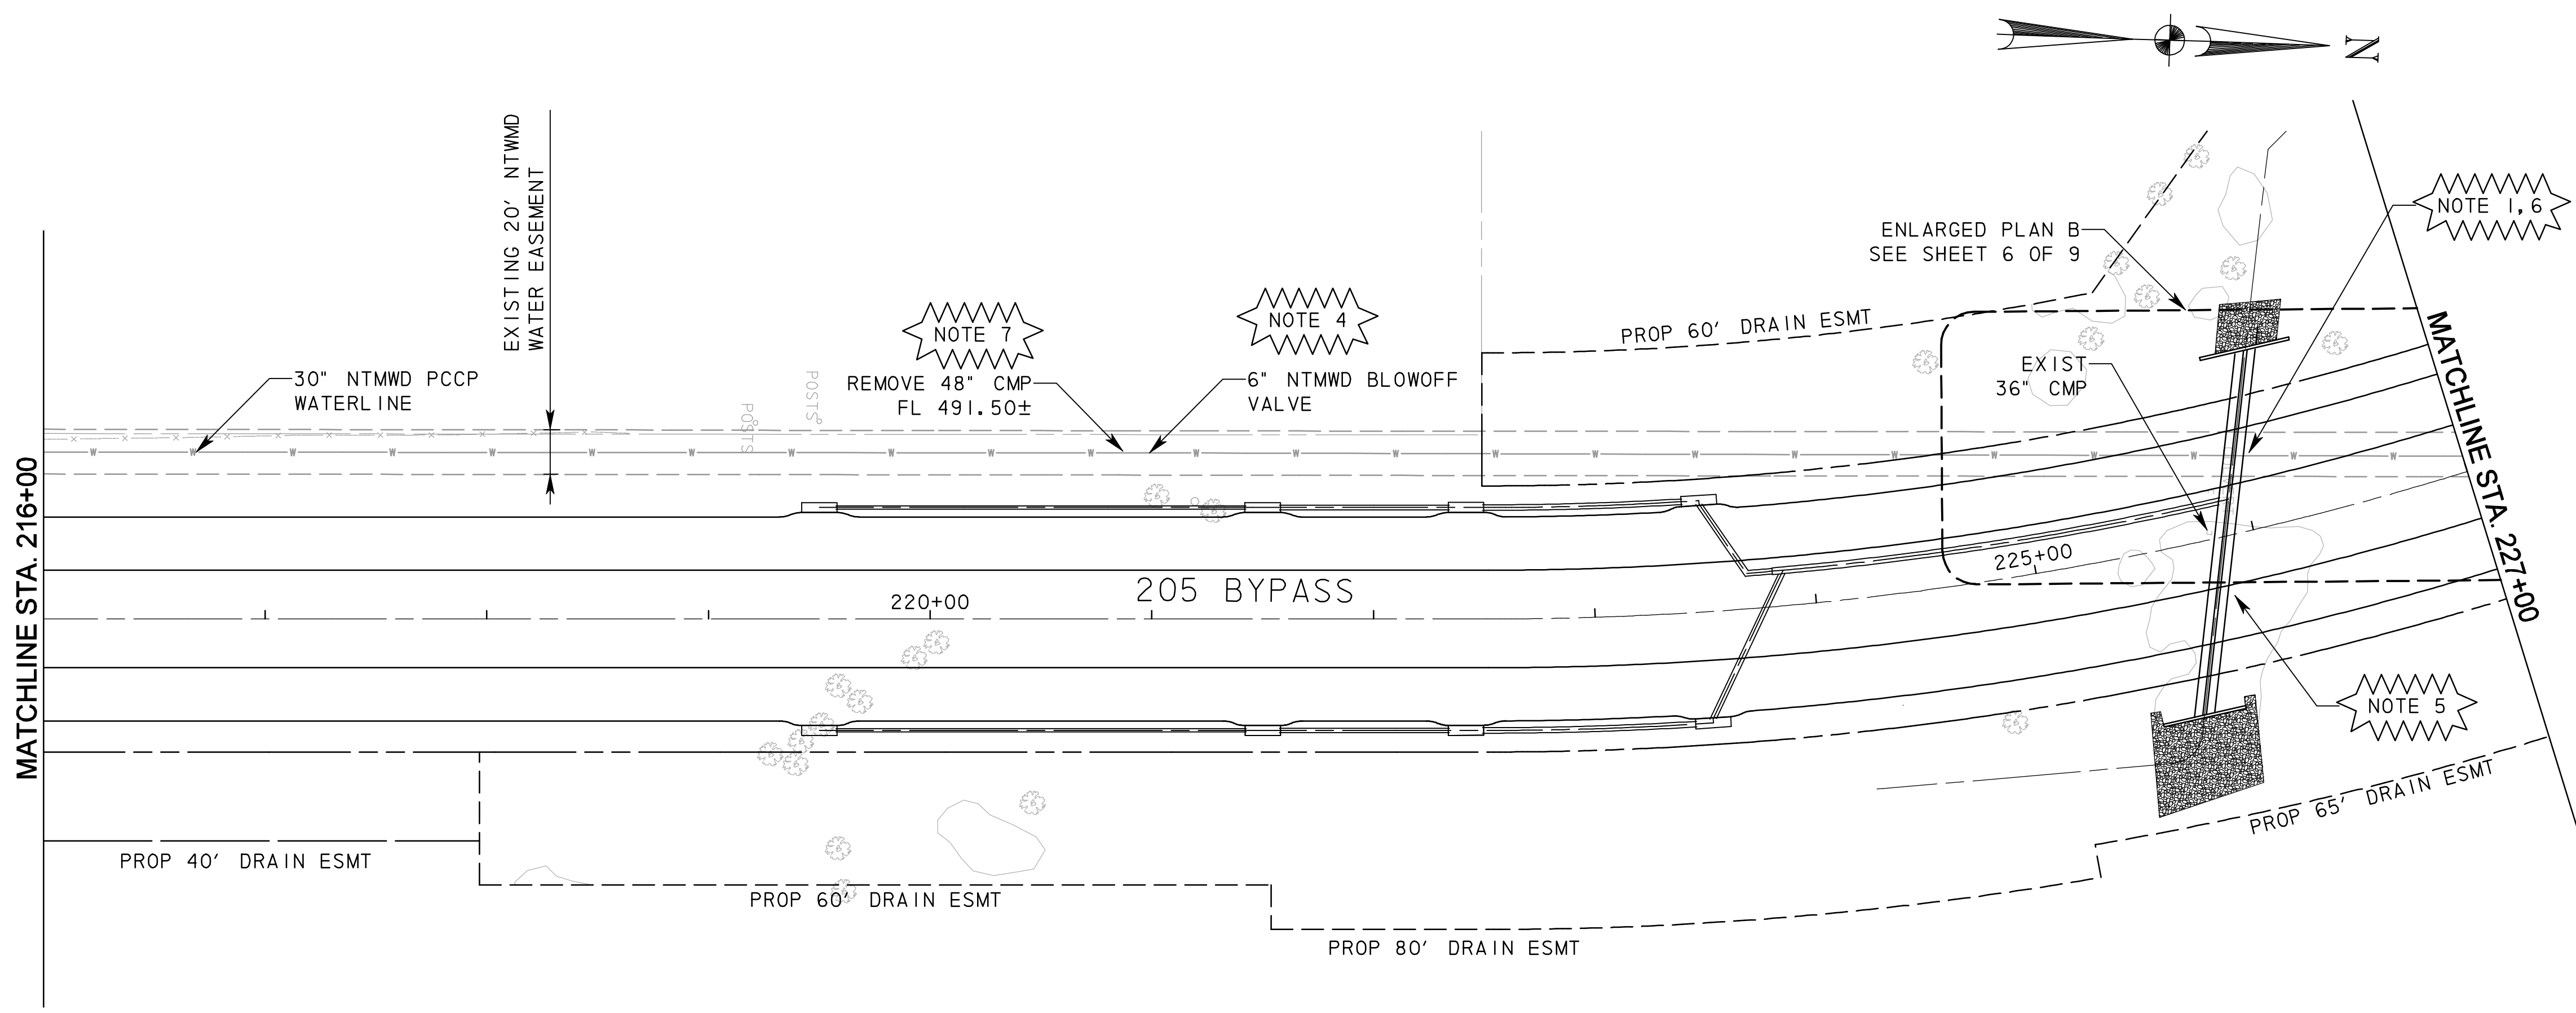

RECORD DRAWING
This drawing is a compilation of the original sealed engineering drawing and modifications by addenda, change orders and information furnished by the contractor. Information shown that was provided by the contractor and others not associated with the design engineer cannot be verified for accuracy or completeness. Original sealed drawing is on file at the office of AECOM USA Group, Inc., TBPE REG. NO. F-3082

ORIGINAL DRAWING SEALED & SIGNED BY
John W. Lacy, P.E.
TX NO. 90202

| NO. | REVISION | BY | DATE |
|-----|----------|----|------|
| | | | |
| | | | |
| | | | |

City of Rockwall, Texas

205 BYPASS PHASE 6

UTILITIES LAYOUT

1 OF 9

| | | | | | |
|----------|-----------|----------|----------------------------------|-------------|------------|
| Unit | PW-DAL-FW | Scale | Horz: AS SHOWN Vert: AS SHOWN | Date | 11/24/2009 |
| Designed | SRR/SDB | Checked | TCB | Project No. | 60004153 |
| Drawn | FG | Approved | TCB | Sheet | 106 of 216 |

TCB INC. WWW.TCB.AECOM.COM
17300 DALLAS PARKWAY, SUITE 1010
DALLAS, TEXAS 75248