
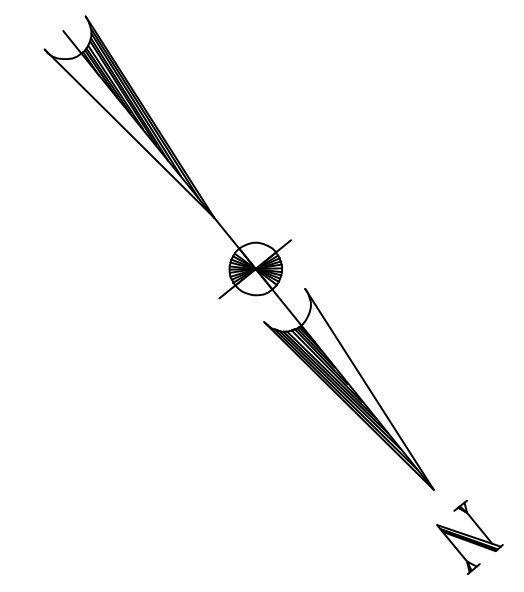


- LEGEND**
- (A) 4" WHITE SOLID
 - (B) 4" X4" CLEAR BUTTONS W/ 4" WHITE NON REFLECTIVE ROUND BUTTONS SEE MISC. ROADWAY DETAIL SHEET FOR MORE INFORMATION.
 - (E) 4" DOUBLE YELLOW SOLID
 - (F) 24" WHITE STOP BAR
 - (G) "ONLY" WHITE
 - (H) WHITE LEFT TURN ARROW
 - (I) WHITE RIGHT TURN ARROW
 - (J) 12" WHITE SOLID
 - (K) 12" YELLOW SOLID
 - (L) WHITE MERGE ARROW
 - * DENOTES TEMPORARY MARKING

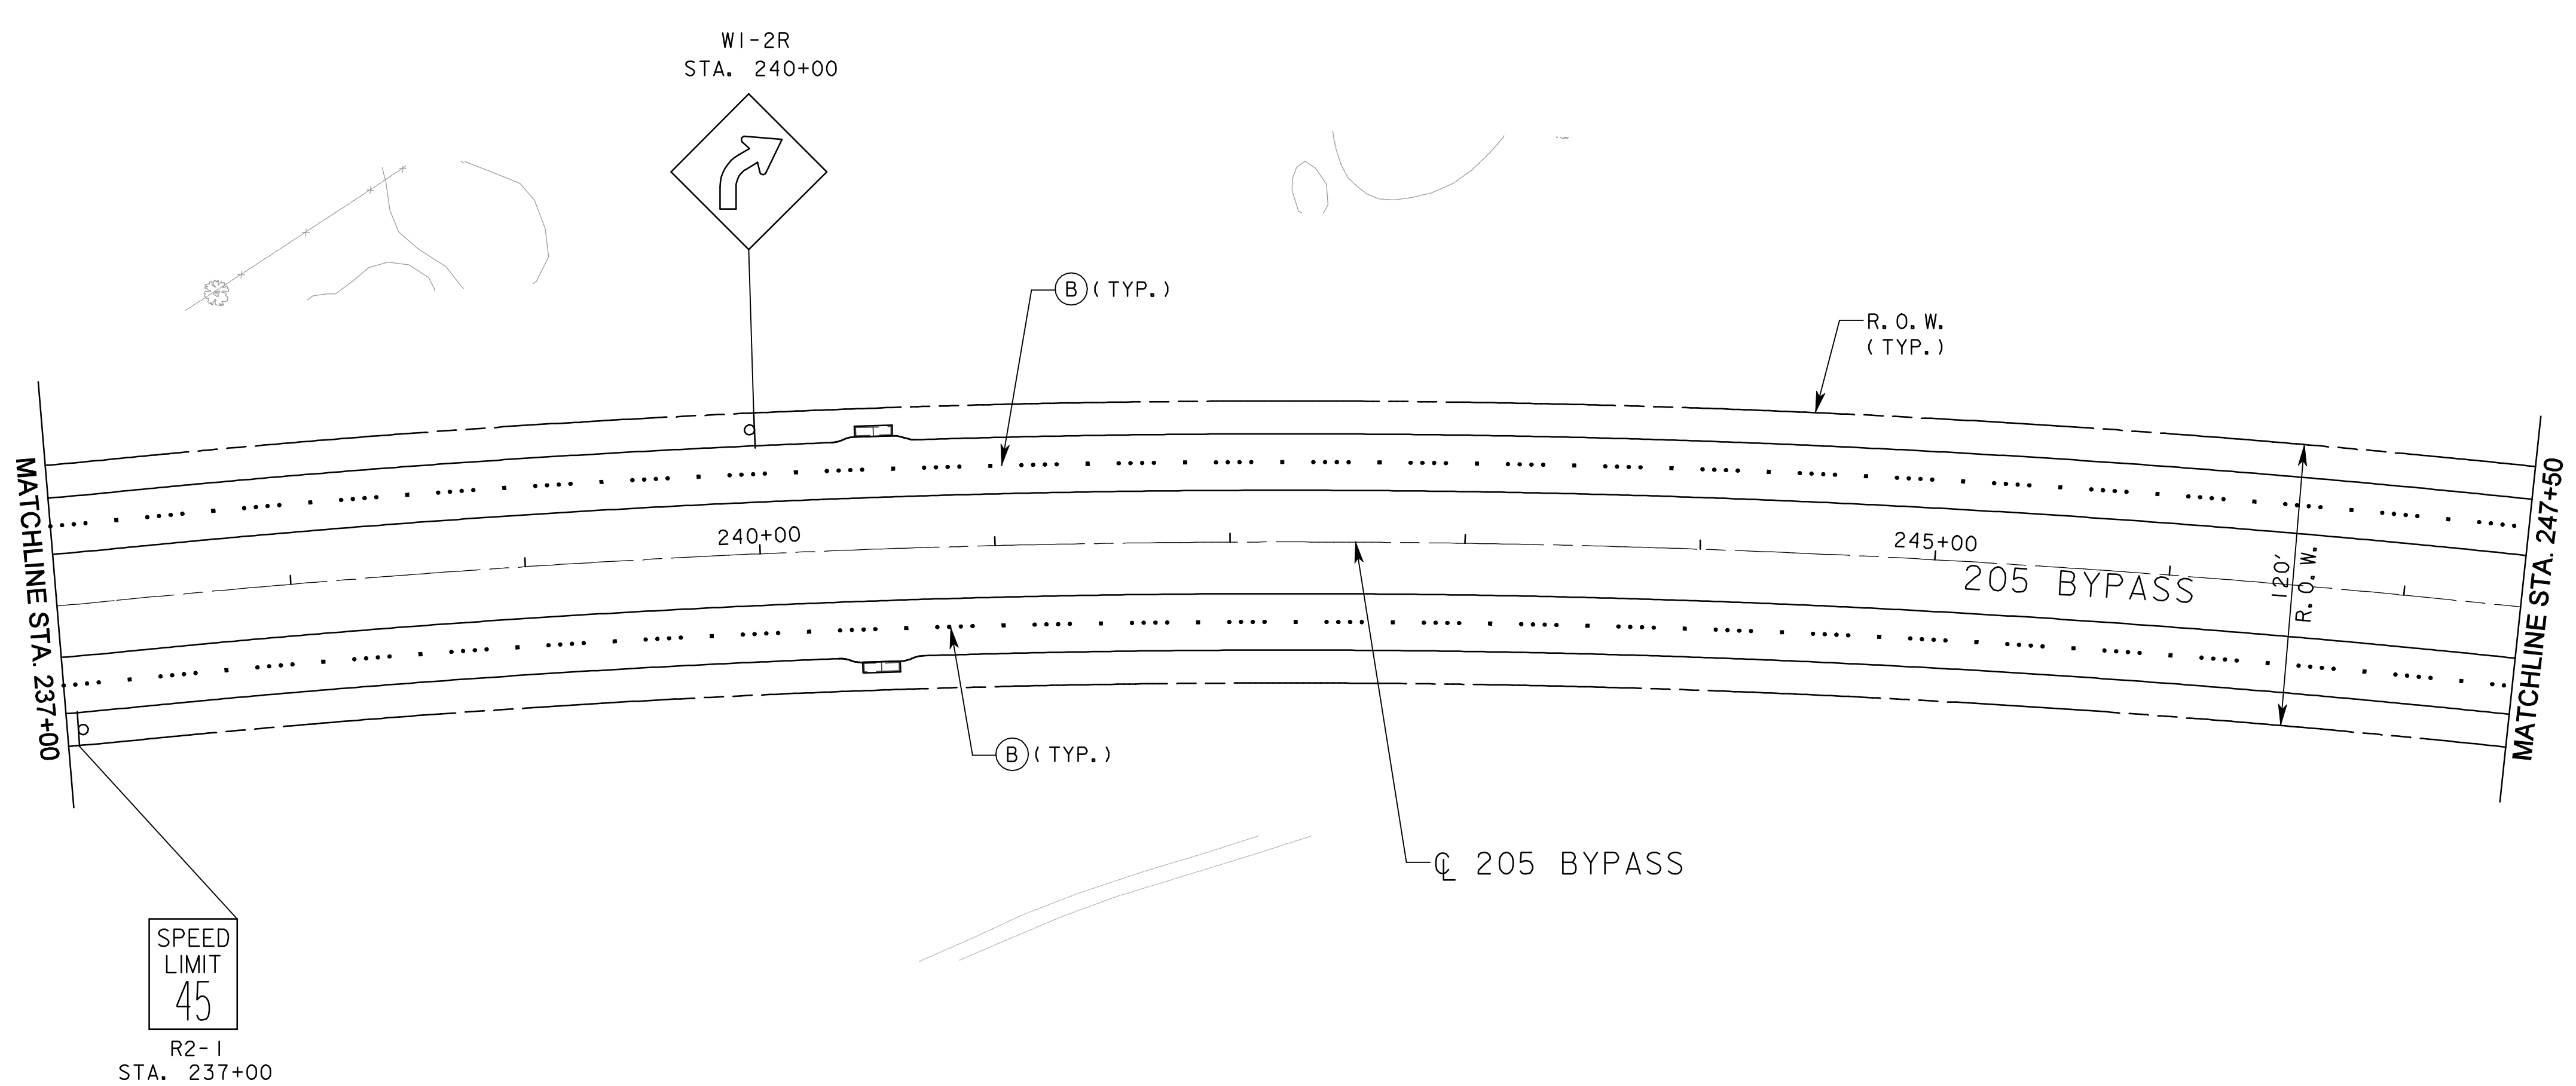

RECORD DRAWING
 This drawing is a compilation of the original sealed engineering drawing and modifications by addenda, change orders and information furnished by the contractor. Information shown that was provided by the contractor and others not associated with the design engineer cannot be verified for accuracy or completeness. Original sealed drawing is on file at the office of AECOM USA Group, Inc., TBPE REG. NO. F-3082

ORIGINAL DRAWING SEALED & SIGNED BY
 Matthew L. Abbe, P.E.
 TX NO. 92715

| NO. | REVISION | BY | DATE |
|-----|----------|----|------|
| | | | |
| | | | |
| | | | |

2 OF 5

City of Rockwall, Texas

**205 BYPASS
PHASE 6**

SIGNING & PAVEMENT MARKING LAYOUT

TCB | AECOM

TCB INC.
WWW.TCB.AECOM.COM
17300 DALLAS PARKWAY, SUITE 1010
DALLAS, TEXAS 75248

| | | | | | |
|----------|-----------|----------|----------------------------------|-------------|------------|
| Unit | PW-DAL-FW | Scale | Horz: AS SHOWN Vert: AS SHOWN | Date | 11/24/2009 |
| Designed | SDB | Checked | TCB | Project No. | 60004153 |
| Drawn | TCB | Approved | TCB | Sheet | 121 of 216 |

P:\328\60004153-205bypass\cadd\sheet6\phase 6 - fm52 to 205\record drawing 10_7_09\121PvmMkKg-02.dgn
 11/24/2009