
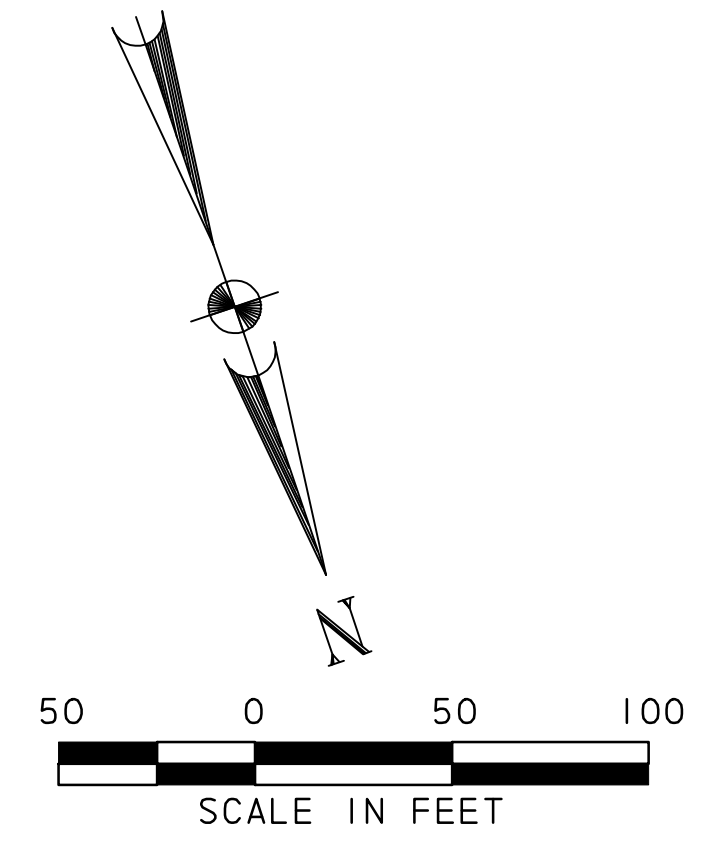


P:\328\60004153-205bypass\cadd\sheet\phase 6 - fm52 to 205\record drawing 10_7_09\123A\mMk-g-04.dgn
11/24/2009

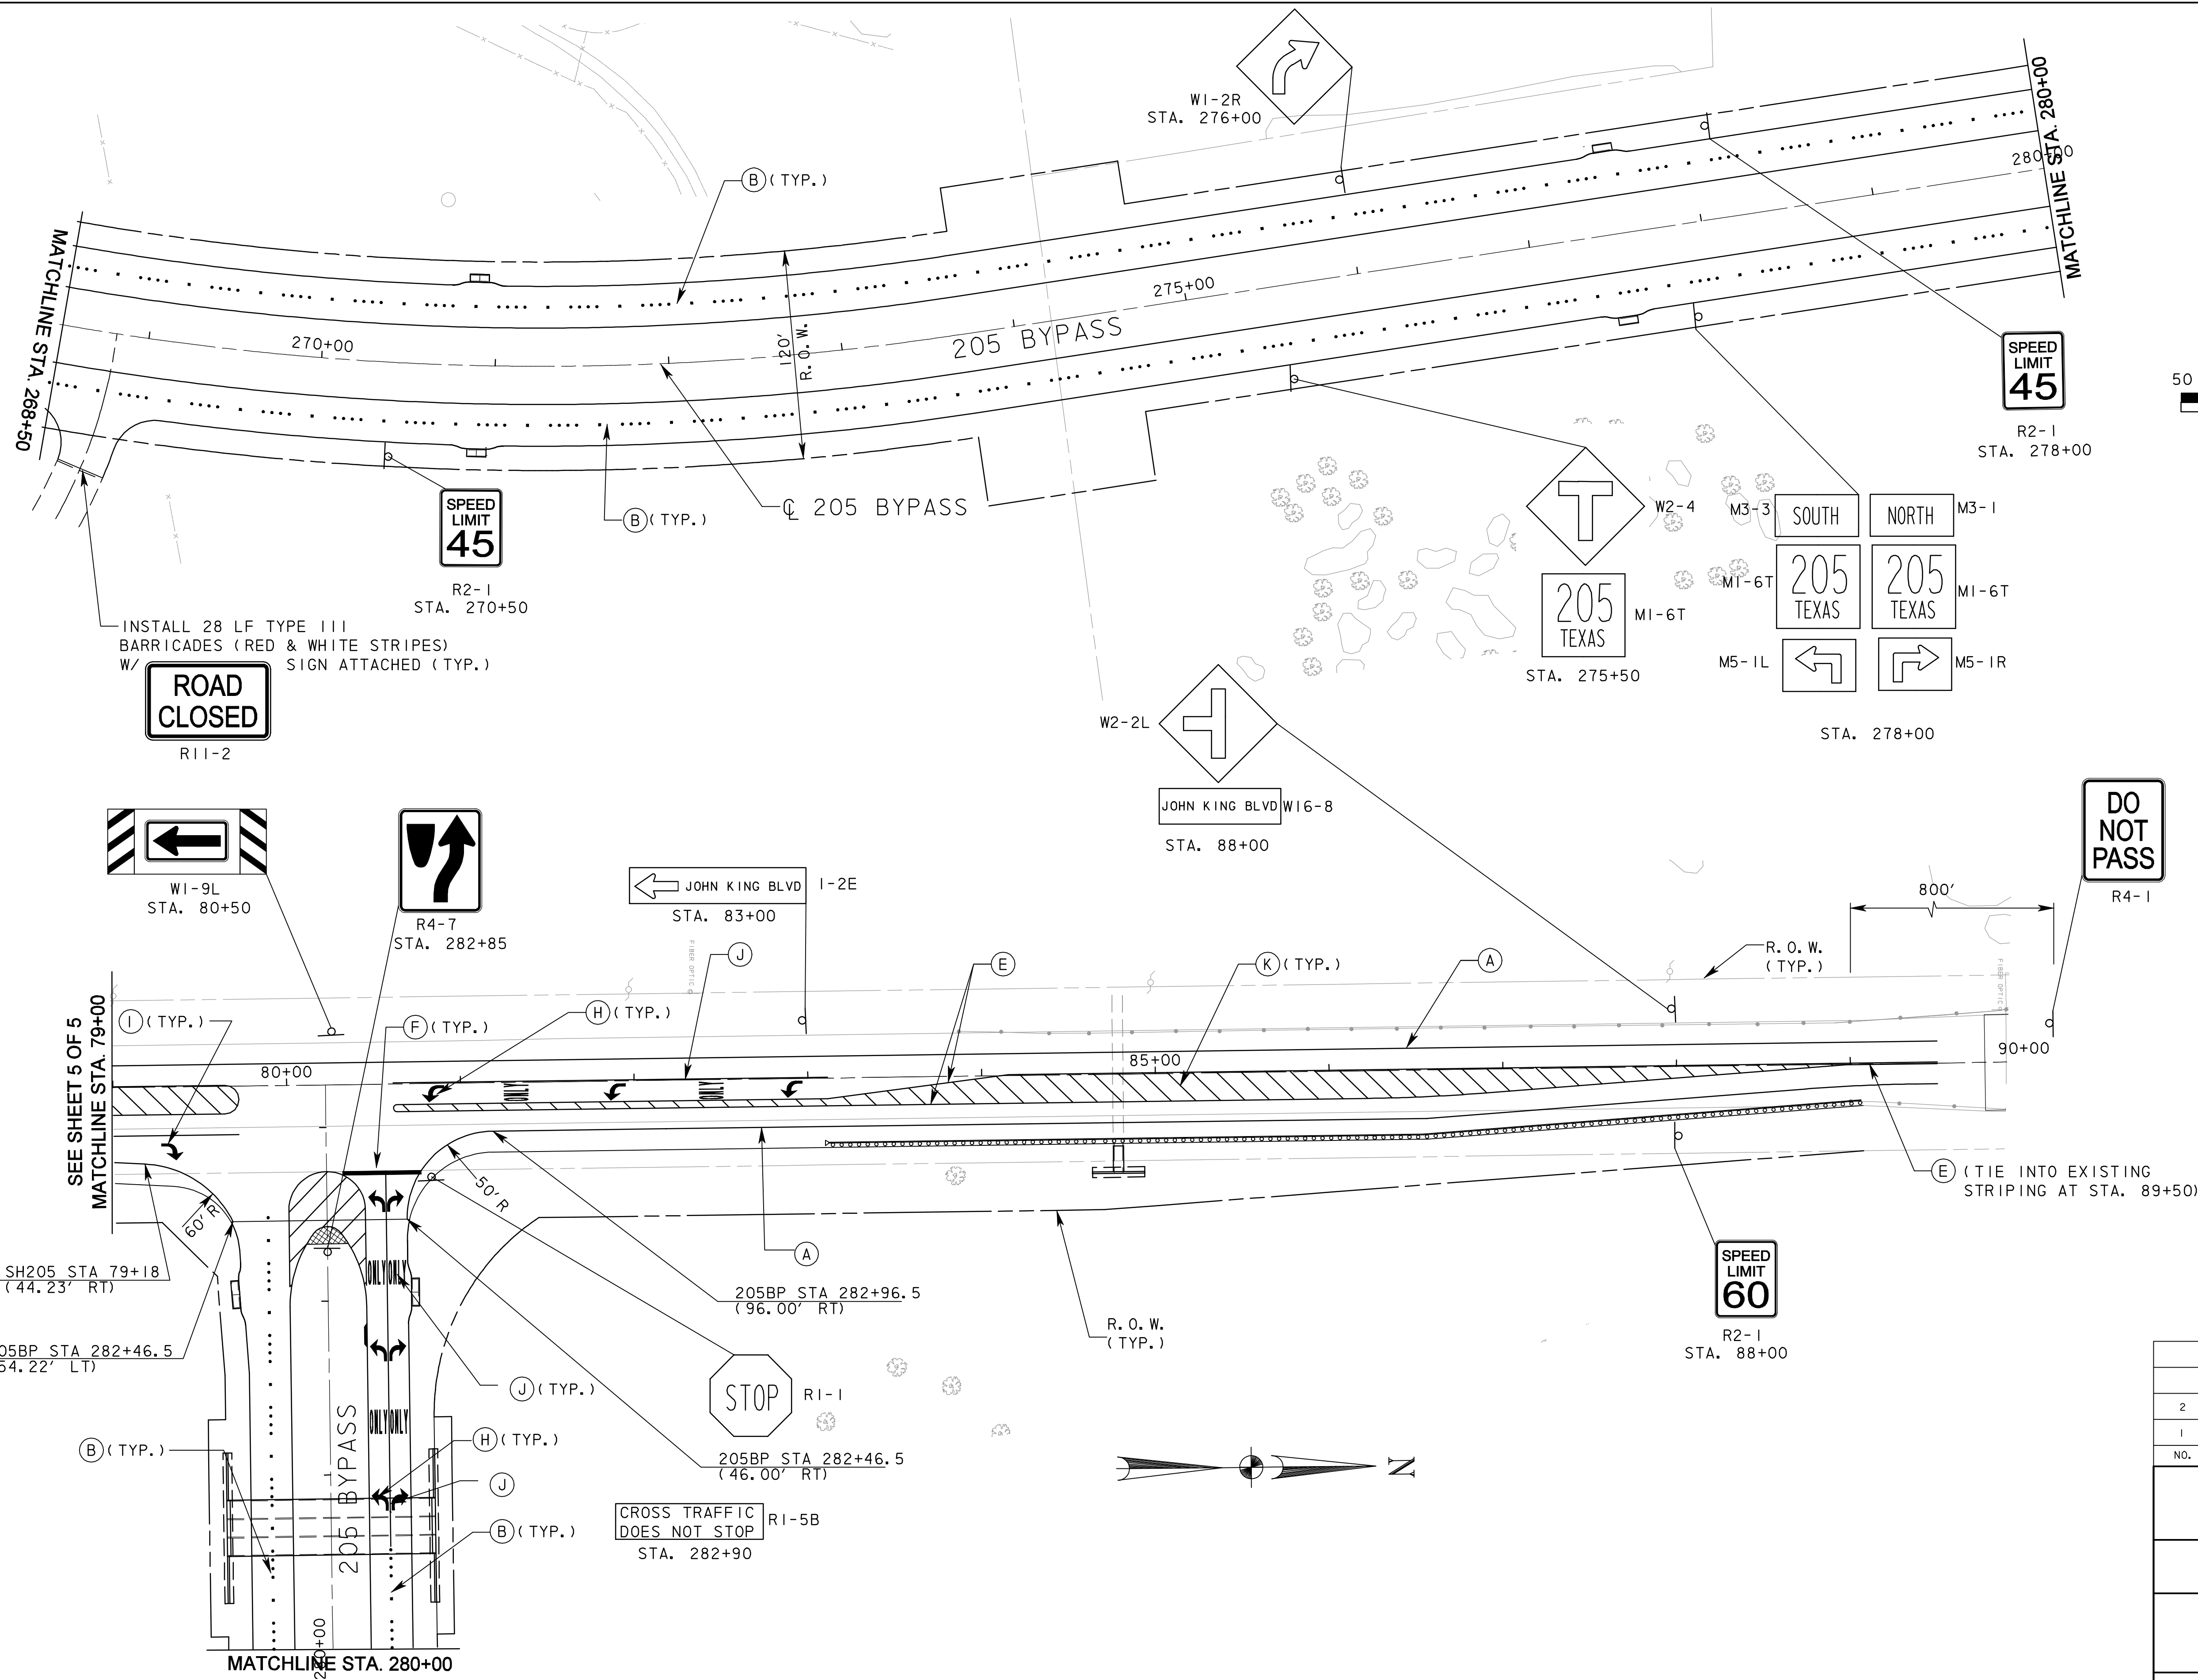

- LEGEND**
- (A) 4" WHITE SOLID
 - (B) WHITE BUTTON TYPE LANE LINE
SEE MISC. ROADWAY DETAIL SHEET
2 OF 2 FOR MORE INFORMATION.
 - (C) WHITE BUTTON TURN BAY LINE.
SEE MISC. ROADWAY DETAIL SHEET
2 OF 2 FOR MORE INFORMATION.
 - (D) 4" YELLOW SOLID
 - (E) 4" DOUBLE YELLOW SOLID
 - (F) 24" WHITE STOP BAR
 - (G) "ONLY" WHITE
 - (H) WHITE LEFT TURN ARROW
 - (I) WHITE RIGHT TURN ARROW
 - (J) 12" WHITE SOLID
 - (K) 12" YELLOW SOLID
 - (L) WHITE ARROW

RECORD DRAWING
This drawing is a compilation of the original sealed engineering drawing and modifications by addenda, change orders and information furnished by the contractor. Information shown that was provided by the contractor and others not associated with the design engineer cannot be verified for accuracy or completeness. Original sealed drawing is on file at the office of AECOM USA Group, Inc., TBPE REG. NO. F-3082

ORIGINAL DRAWING SEALED & SIGNED BY
T.H. Gaertner, P.E.
TX NO. 37124

NO.	REVISION	BY	DATE
2	REVISED PAVEMENT MARKINGS	THG	7/14/08
1	REVISED PAVEMENT MARKINGS	THG	7/02/08

City of Rockwall, Texas

**205 BYPASS
PHASE 6**

SIGNING & PAVEMENT MARKING LAYOUT

4 OF 5

TCB | AECOM
TCB INC.
WWW.TCB.AECOM.COM
17300 DALLAS PARKWAY, SUITE 1010
DALLAS, TEXAS 75248

Unit	PW-DAL-FW	Scale	Horz: AS SHOWN Vert: AS SHOWN	Date	11/24/2009
Designed	SDB	Checked	TCB	Project No.	60004153
Drawn	TCB	Approved	TCB	Sheet	123A of 216