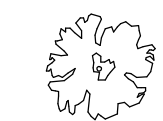

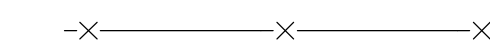

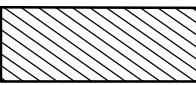


LEGEND

-  EXIST. TREE TO REMAIN
-  EXIST. TREE TO BE REMOVED
-  EXIST. FENCE TO REMAIN
-  EXIST. FENCE TO BE REMOVED
-  EXIST. BRUSH & SMALL DIAMETER TREES TO BE REMOVED

NOTES:

1. CONTRACTOR SHALL PAY FOR REMOVALS IN ACCORDANCE WITH PREPARING ROW, ITEM NO. 100. REMOVALS FOR ITEM 105 SHALL BE MEASURED & PAID FOR SEPERATLY.
2. QUANTITIES SHOWN ARE FOR CONTRACTOR'S INFORMATION ONLY.
3. FOR UTILITY ADJUSTMENTS, SEE THE UTILITY LAYOUT SHEETS.

RECORD DRAWING

This drawing is a compilation of the original sealed engineering drawing and modifications by addenda, change orders and information furnished by the contractor. Information shown that was provided by the contractor and others not associated with the design engineer cannot be verified for accuracy or completeness. Original sealed drawing is on file at the office of AECOM USA Group, Inc., TBPE REG. NO. F-3082

ORIGINAL DRAWING SEALED & SIGNED BY

Matthew L. Abbe, P.E.
TX NO. 92715

| NO. | REVISION | BY | DATE |
|-----|----------|----|------|
| | | | |
| | | | |
| | | | |



City of Rockwall, Texas


205 BYPASS
PHASE 6

DEMOLITION PLAN
STA. 229+00 TO STA. 233+50

4 OF 15

TCB AECOM
TCB INC. WWW.TCB.AECOM.COM
17300 DALLAS PARKWAY, SUITE 1010
DALLAS, TEXAS 75248

| | | | | | |
|----------|-----------|----------|----------------------------------|-------------|------------|
| Unit | PW-DAL-FW | Scale | Horz: AS SHOWN Vert: AS SHOWN | Date | 11/24/2009 |
| Designed | SKW/MLA | Checked | TCB | Project No. | 60004153 |
| Drawn | TCB | Approved | TCB | Sheet | 20 of 216 |

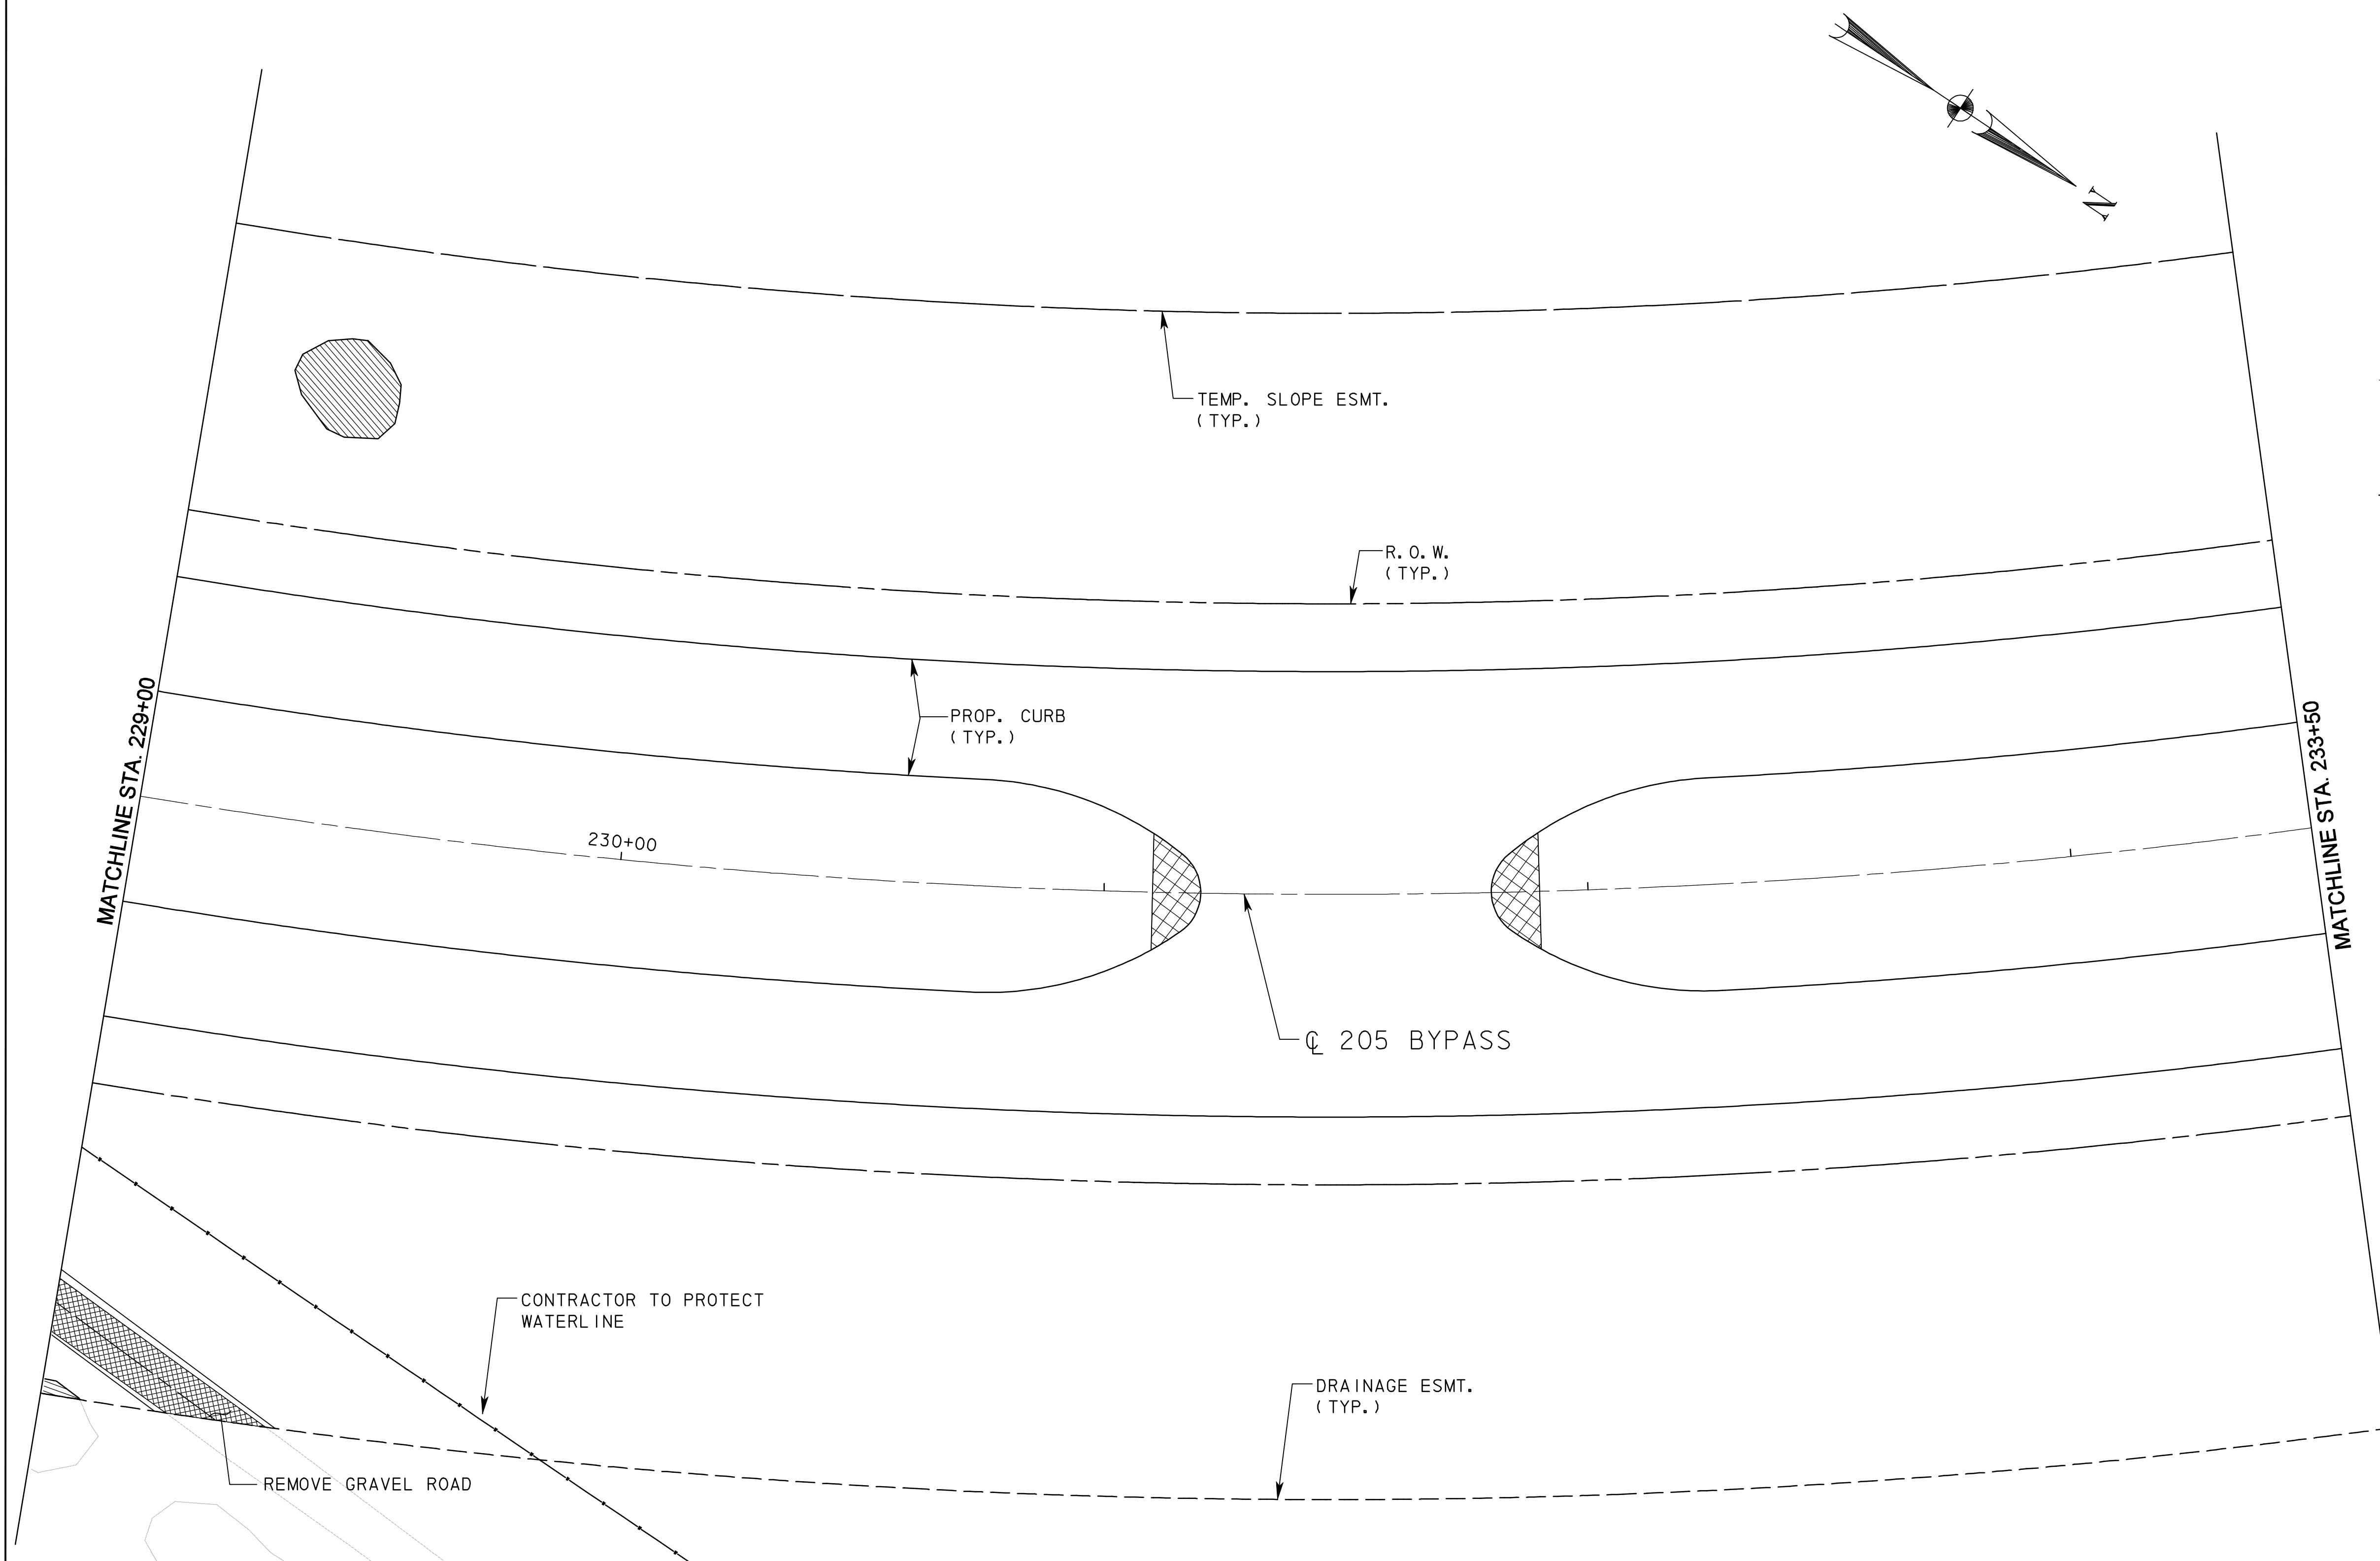

| ITEM SPEC NO. | DESCRIPTION | UNIT | QUANTITY |
|---------------|--|------|----------|
| * 100 | PREP ROW (STORM DRAIN STRUCTURE REMOVAL) | LF | 0 |
| * 104 | REMOVING CONCRETE (CONCRETE PVMT) | SY | 0 |
| * 100 | PREP ROW (FENCE REMOVAL) | LF | 0 |
| * 100 | REMOVE GRAVEL ROAD | SY | 0 |

* THESE ITEMS ARE SUBSIDIARY TO ITEM 100, PREP. ROW.
NOTE: ALL QUANTITIES SHOWN ARE FOR CONTRACTORS INFORMATION ONLY.