


SECTION A-A

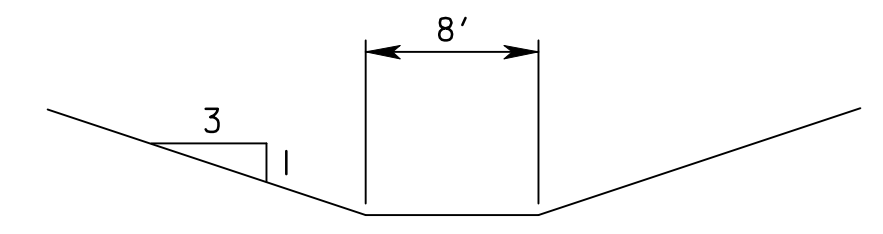


SECTION B-B

4" MANUFACTURED TOPSOIL (B05) (TYP)

**RECORD DRAWING**  
 This drawing is a compilation of the original sealed engineering drawing and modifications by addenda, change orders and information furnished by the contractor. Information shown that was provided by the contractor and others not associated with the design engineer cannot be verified for accuracy or completeness. Original sealed drawing is on file at the office of AECOM USA Group, Inc., TBPE REG. NO. F-3082

**ORIGINAL DRAWING SEALED & SIGNED BY**  
 T.H. Gaertner, P.E.  
 TX NO. 37124

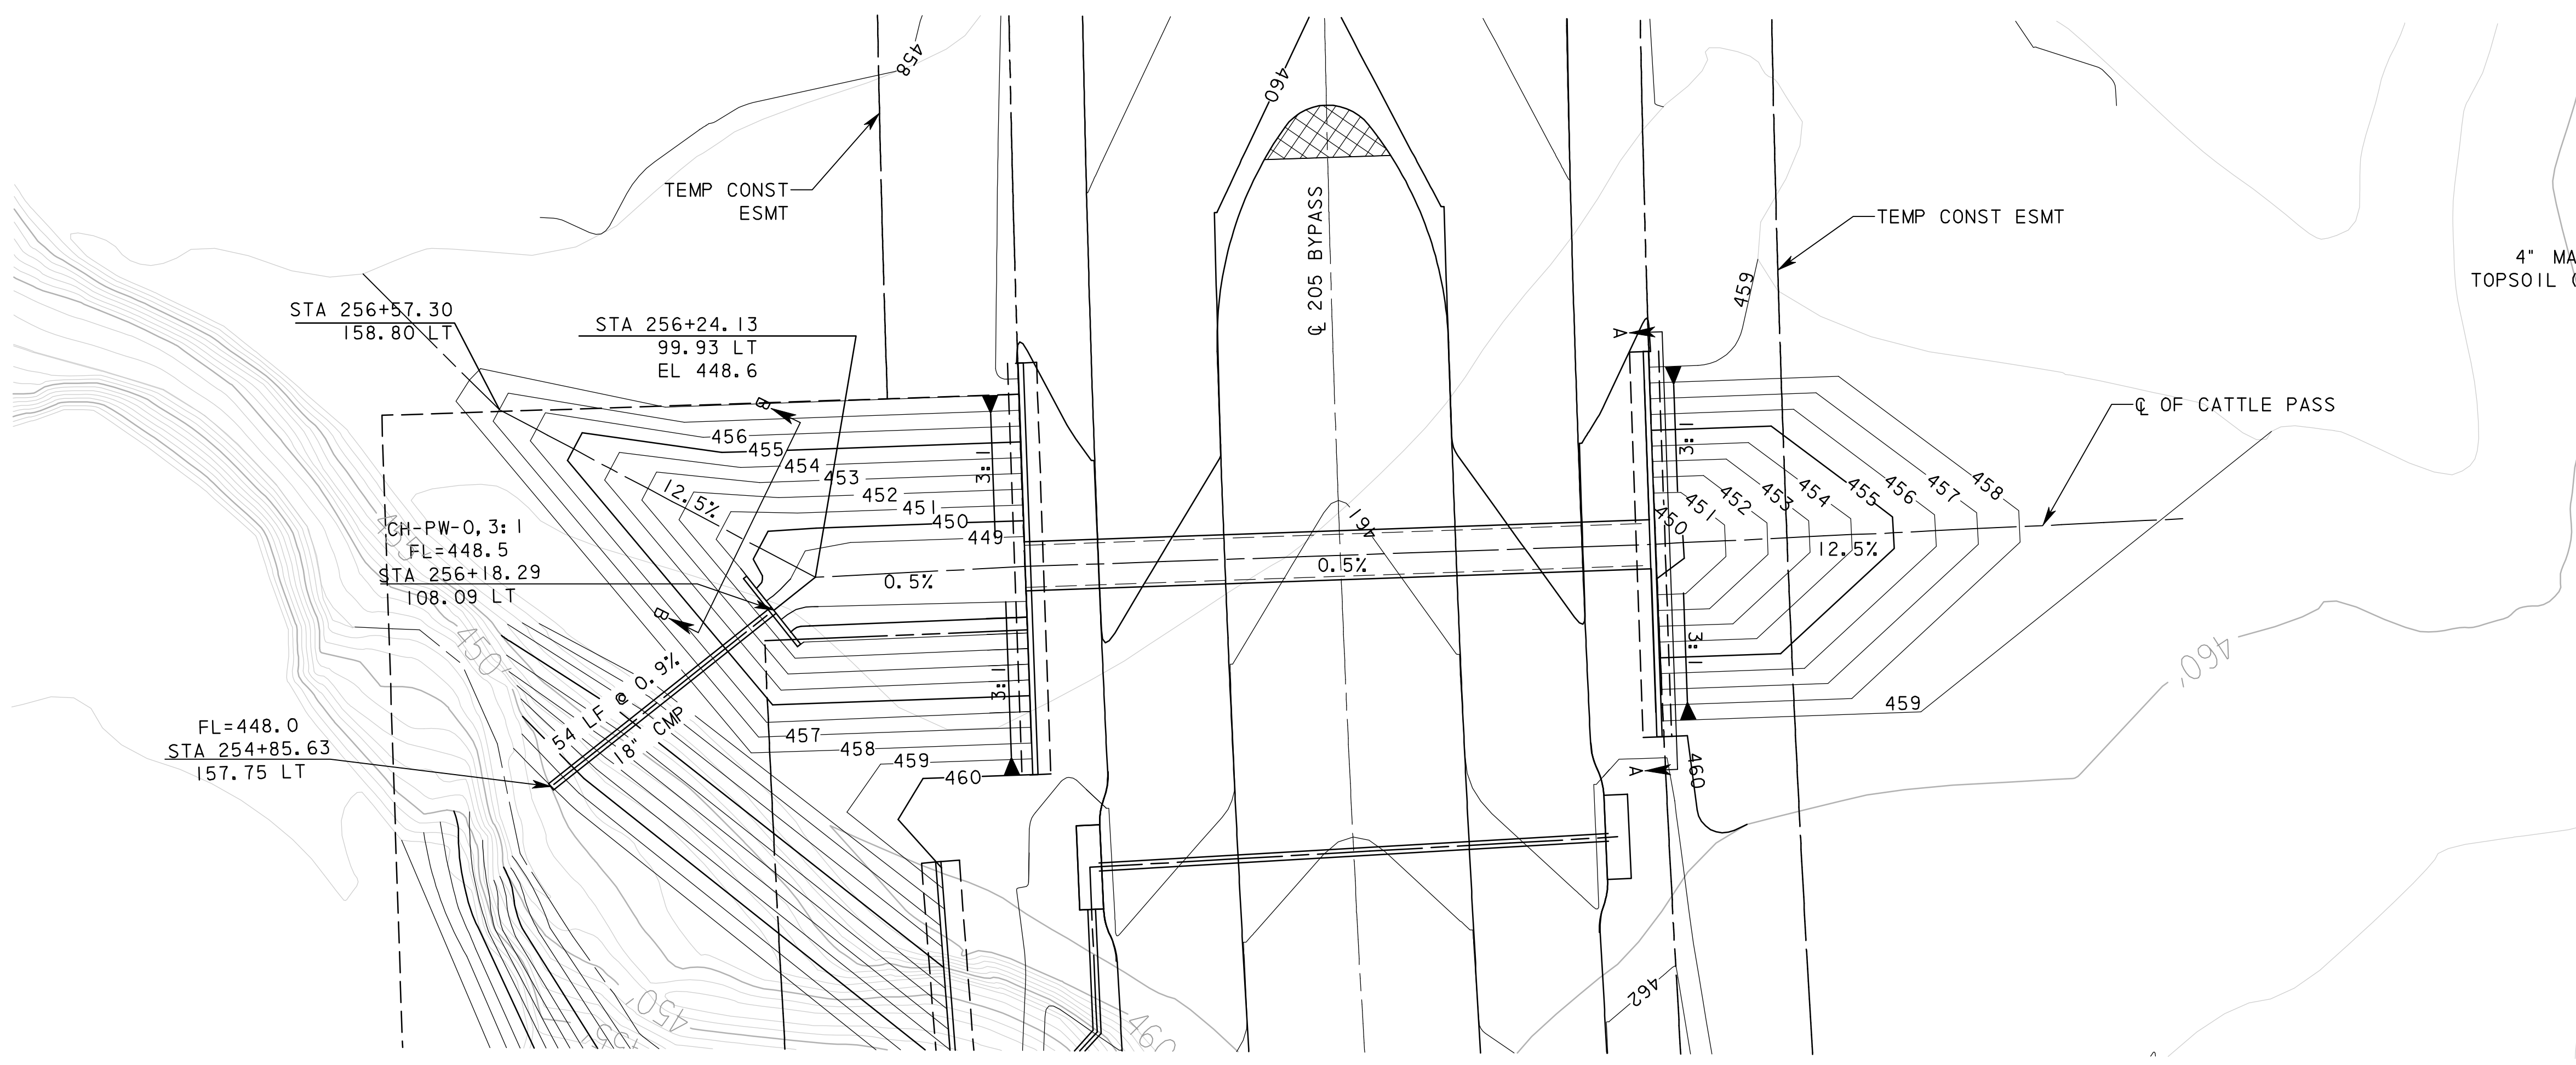

**NOTES:**

- CELLULOSE FIBER MULCH SEEDING IN ALL DISTURBED AREA PER TXDOT SPEC ITEM 164.

NO.	REVISION	BY	DATE



**City of Rockwall, Texas**

**205 BYPASS  
 PHASE 6**

**GRADING PLAN  
 STOCK PASS STA 256+24.38**

2 OF 2

**TCB | AECOM**  
 TCB INC. WWW.TCB.AECOM.COM  
 17300 DALLAS PARKWAY, SUITE 1010  
 DALLAS, TEXAS 75248

Unit	PW-DAL-FW	Scale:	Horz: AS SHOWN Vert: AS SHOWN	Date	10/11/2010
Designed	RI/US	Checked	TCB	Project No.	60004153
Drawn	FG	Approved	TCB	Sheet	216E of 216

\\usda11rpd001\pwn4328\60004153-205Bypass\CADD\Sheets\Phase 6 - FMS2 To 205\Record Drawing 10\_7\_09\Grading-STOCKPASS.dgn  
 10/11/2010