
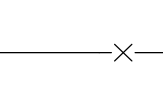

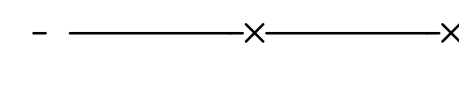



LEGEND

-  EXIST. TREE TO REMAIN
-  EXIST. TREE TO BE REMOVED
-  EXIST. FENCE TO REMAIN
-  EXIST. FENCE TO BE REMOVED
-  EXIST. BRUSH & SMALL DIAMETER TREES TO BE REMOVED

NOTES:

1. CONTRACTOR SHALL PAY FOR REMOVALS IN ACCORDANCE WITH PREPARING ROW, ITEM NO. 100. REMOVALS FOR ITEM 105 SHALL BE MEASURED & PAID FOR SEPERATLY.
2. QUANTITIES SHOWN ARE FOR CONTRACTOR'S INFORMATION ONLY.
3. FOR UTILITY ADJUSTMENTS, SEE THE UTILITY LAYOUT SHEETS.

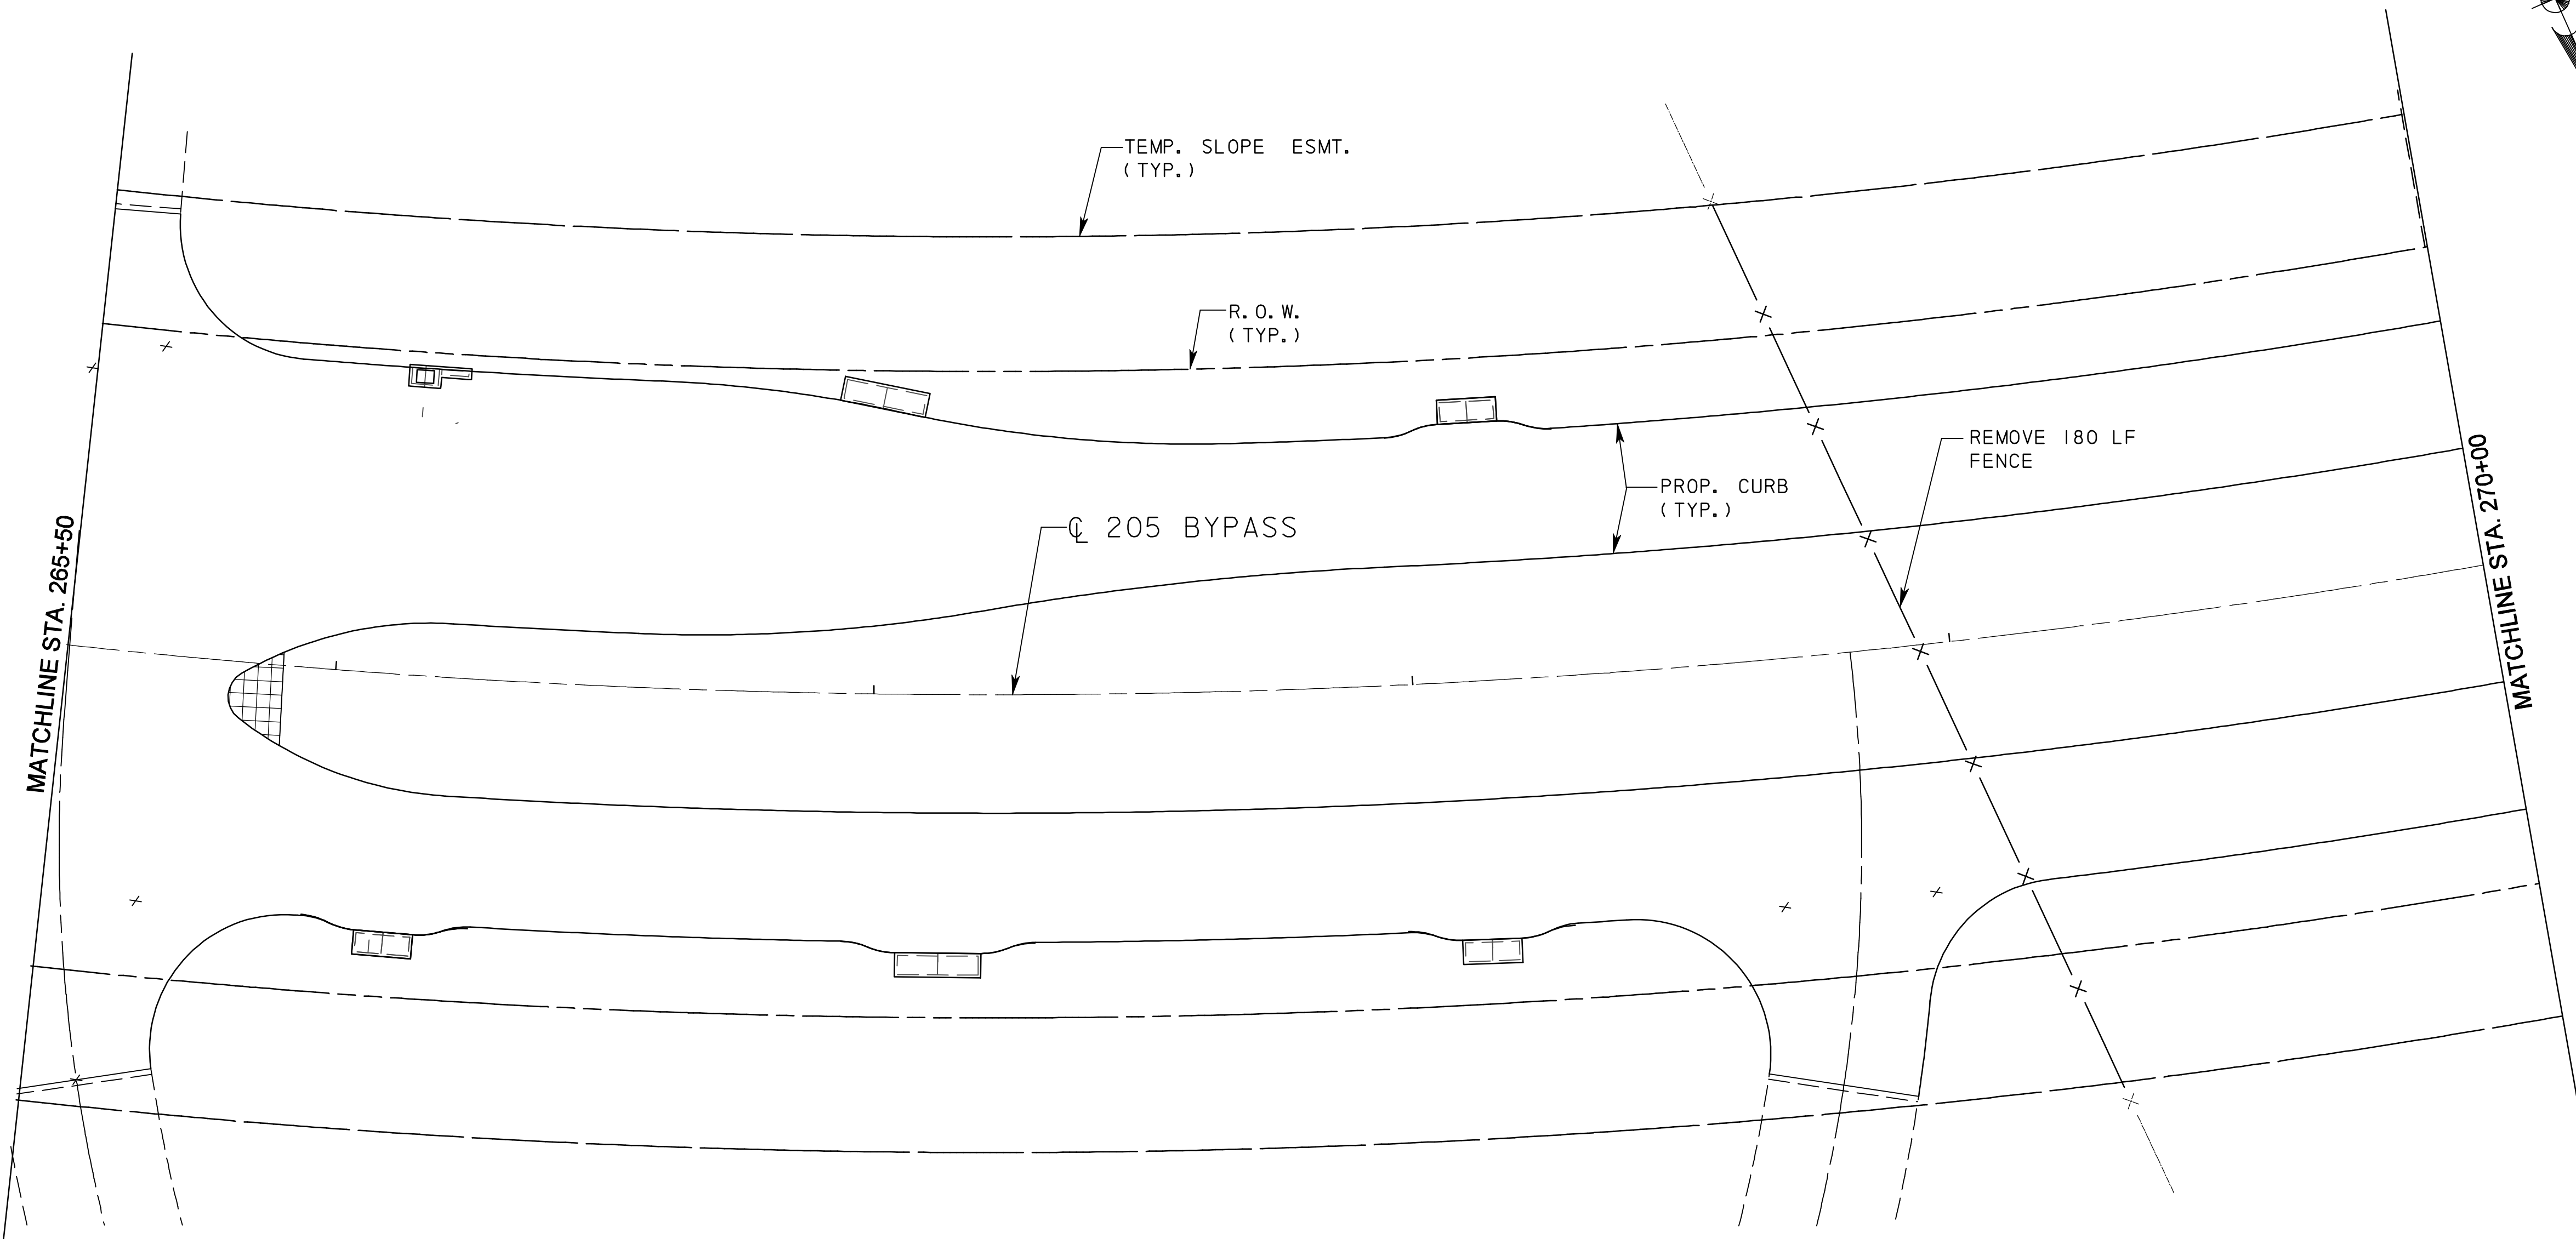
RECORD DRAWING

This drawing is a compilation of the original sealed engineering drawing and modifications by addenda, change orders and information furnished by the contractor. Information shown that was provided by the contractor and others not associated with the design engineer cannot be verified for accuracy or completeness. Original sealed drawing is on file at the office of AECOM USA Group, Inc., TBPE REG. NO. F-3082



ORIGINAL DRAWING SEALED & SIGNED BY
 Matthew L. Abbe, P.E.
 TX NO. 92715

| ITEM SPEC NO. | DESCRIPTION | UNIT | QUANTITY |
|---------------|--|------|----------|
| * 100 | PREP ROW (STORM DRAIN STRUCTURE REMOVAL) | LF | 0 |
| * 104 | REMOVING CONCRETE (CONCRETE PVMT) | SY | 0 |
| * 100 | PREP ROW (FENCE REMOVAL) | LF | 180 |
| * 100 | REMOVE GRAVEL ROAD | SY | 0 |

* THESE ITEMS ARE SUBSIDIARY TO ITEM 100, PREP. ROW.
 NOTE: ALL QUANTITIES SHOWN ARE FOR CONTRACTORS INFORMATION ONLY.



P:\4228\60004\153-205bypass\cadd\sheet\phase 6 - fms52 to 205\record drawing 10..T..09\0270.dwg - 11.dgn
 11/24/2009

| | | | |
|--|------------|---|----------------------------------|
| | | | |
| NO. | REVISION | BY | DATE |
|  City of Rockwall, Texas | | | |
| 205 BYPASS PHASE 6 | | | |
| DEMOLITION PLAN STA. 265+50 TO STA. 270+00 | | | |
| 11 OF 15 | | | |
|  | | <small>TCB INC. WWW.TCB.AECOM.COM 17300 DALLAS PARKWAY, SUITE 1010 DALLAS, TEXAS 75248</small> | |
| Unit | PW-DAL-FW | Scales | Horz: AS SHOWN Vert: AS SHOWN |
| Designed | SKW/MLA | Checked | TCB |
| Drawn | TCB | Approved | TCB |
| Date | 11/24/2009 | | Project No. 60004153 |
| Sheet | 27 of 216 | | |