

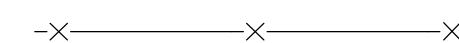
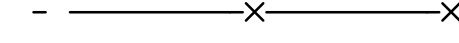
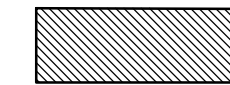


**LEGEND**

-  EXIST. TREE TO REMAIN
-  EXIST. TREE TO BE REMOVED
-  EXIST. FENCE TO REMAIN
-  EXIST. FENCE TO BE REMOVED
-  EXIST. BRUSH & SMALL DIAMETER TREES TO BE REMOVED



**NOTES:**

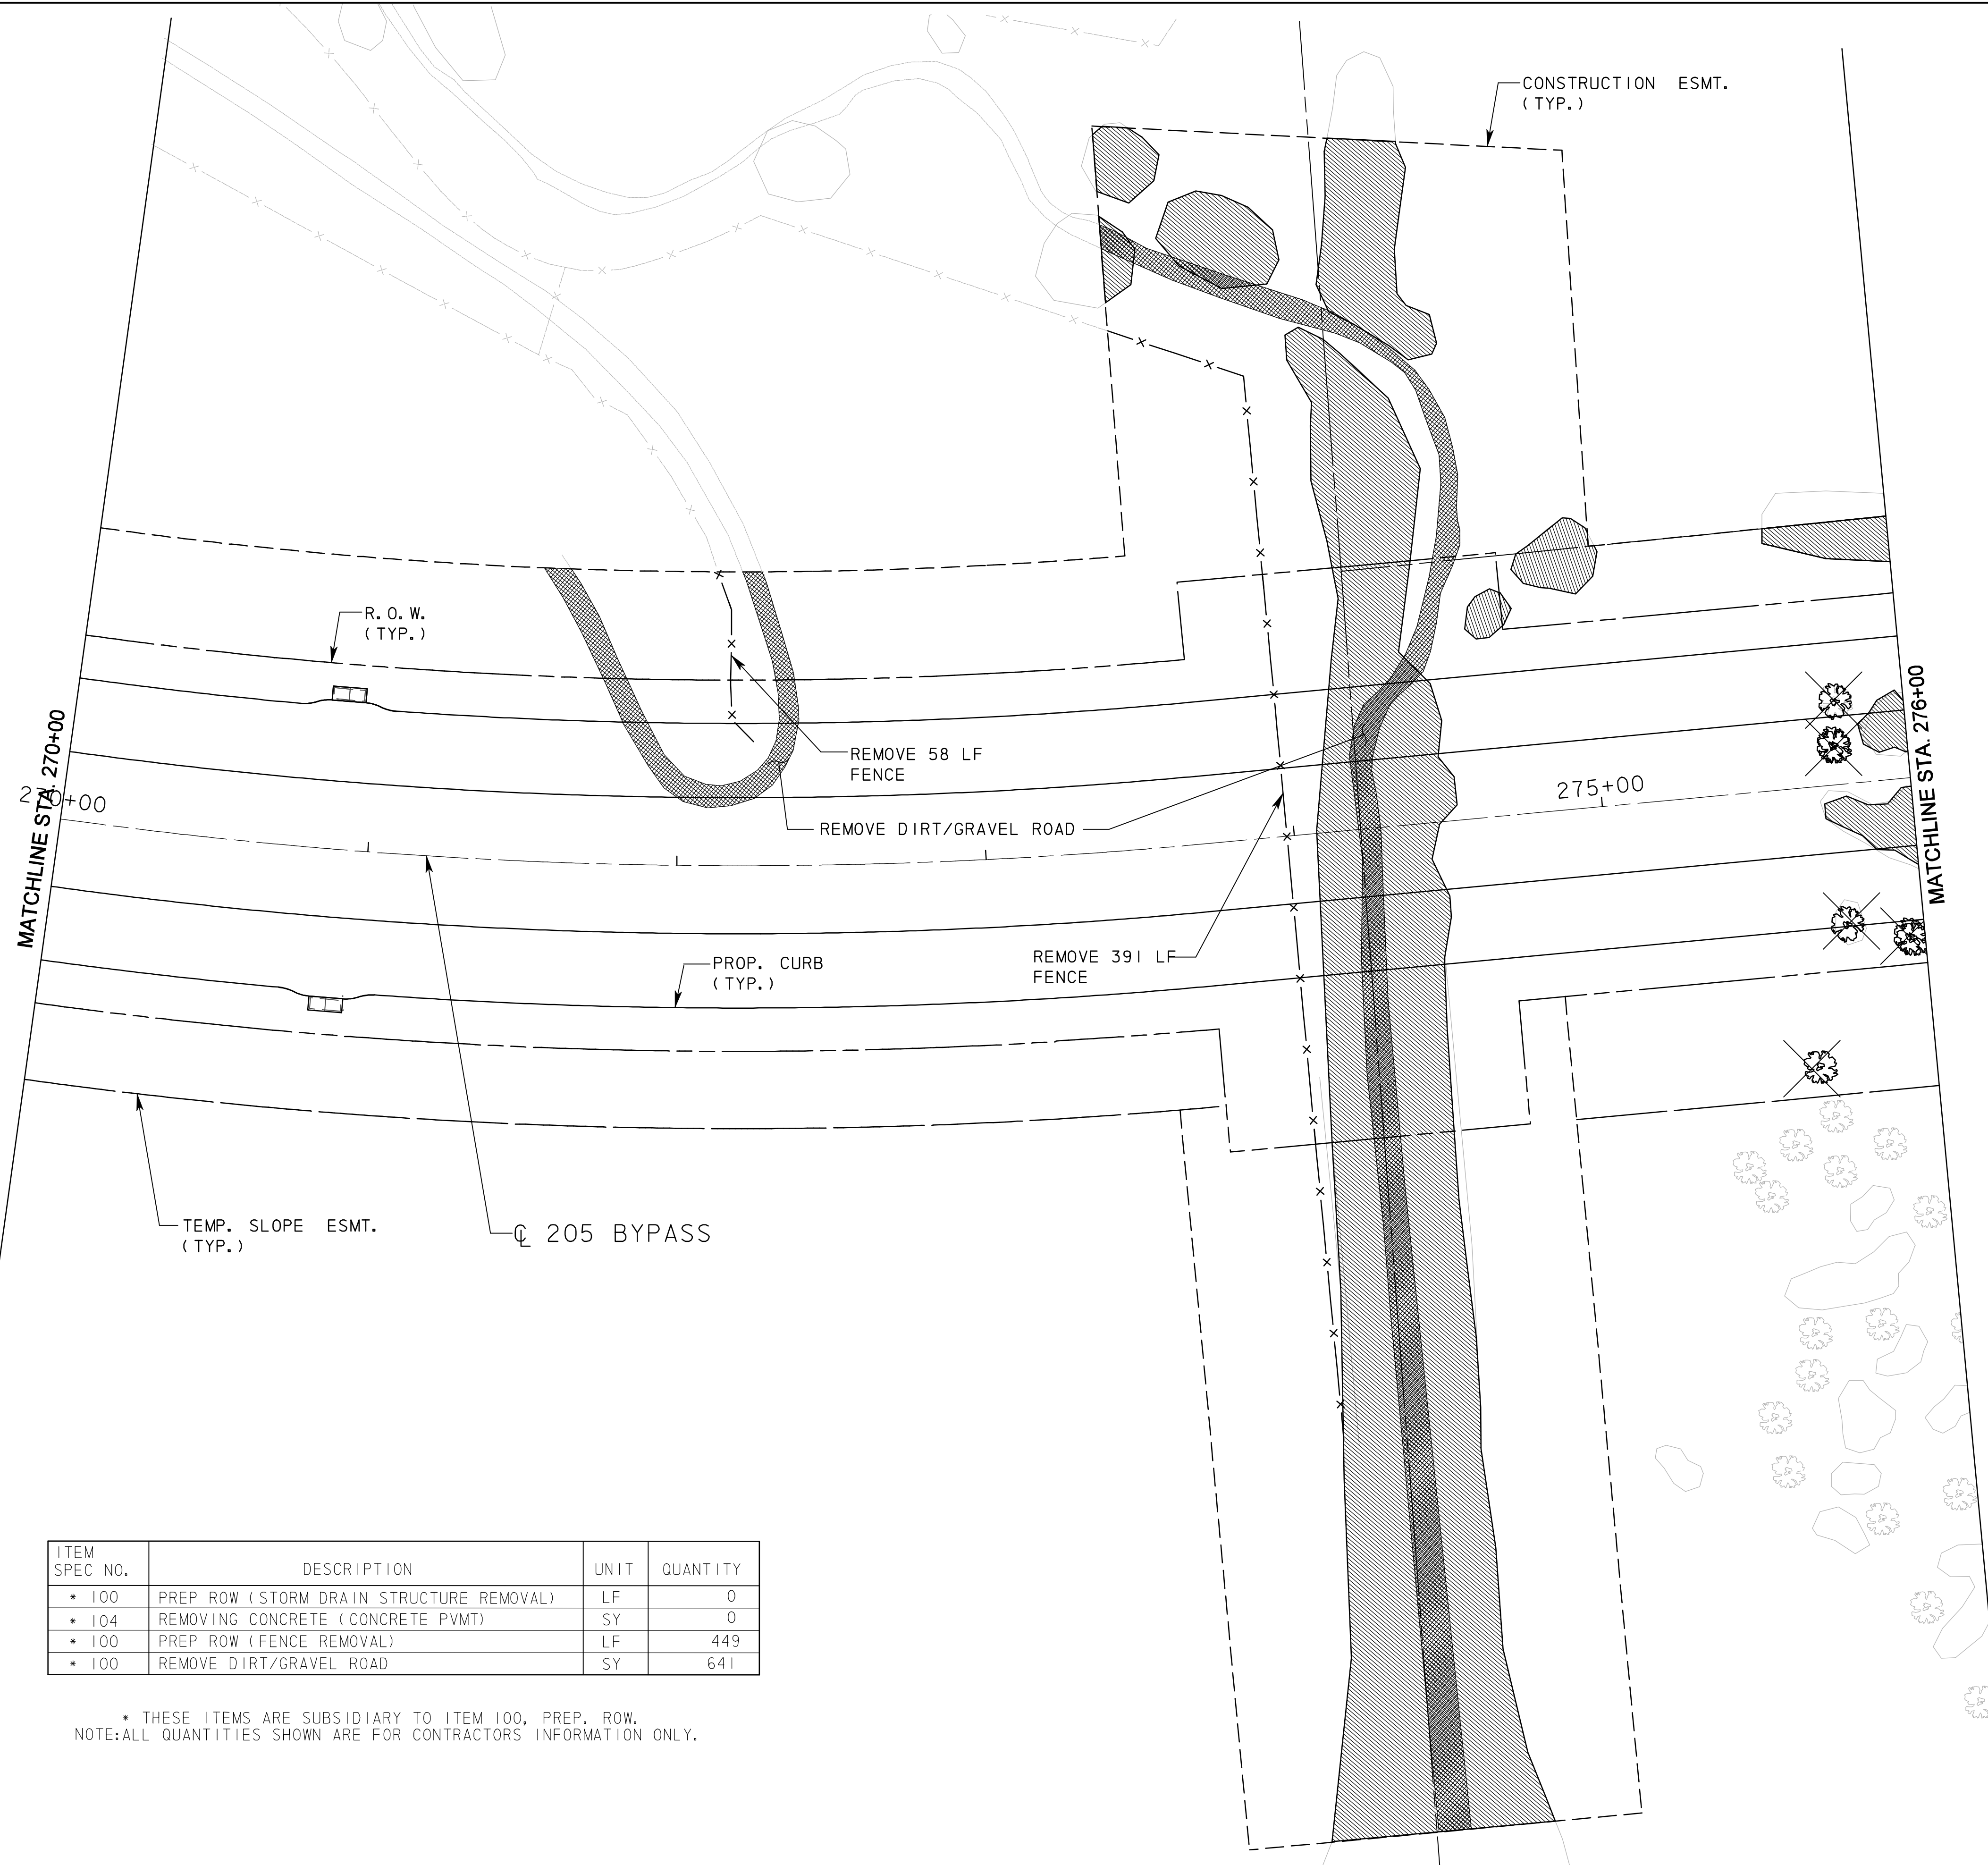
1. CONTRACTOR SHALL PAY FOR REMOVALS IN ACCORDANCE WITH PREPARING ROW, ITEM NO. 100. REMOVALS FOR ITEM 105 SHALL BE MEASURED & PAID FOR SEPERATLY.
2. QUANTITIES SHOWN ARE FOR CONTRACTOR'S INFORMATION ONLY.
3. FOR UTILITY ADJUSTMENTS, SEE THE UTILITY LAYOUT SHEETS.

**RECORD DRAWING**

This drawing is a compilation of the original sealed engineering drawing and modifications by addenda, change orders and information furnished by the contractor. Information shown that was provided by the contractor and others not associated with the design engineer cannot be verified for accuracy or completeness. Original sealed drawing is on file at the office of AECOM USA Group, Inc., TBPE REG. NO. F-3082

ORIGINAL DRAWING  
SEALED & SIGNED BY  
**Matthew L. Abbe, P.E.**  
TX NO. 92715

NO.	REVISION	BY	DATE
 <b>City of Rockwall, Texas</b>			
<b>205 BYPASS PHASE 6</b>			
<b>DEMOLITION PLAN STA. 270+00 TO STA. 276+00</b>			
12 OF 15			
		TCB INC. WWW.TCB.AECOM.COM 17300 DALLAS PARKWAY, SUITE 1010 DALLAS, TEXAS 75248	
Unit	PW-DAL-FW	Scales	Horz: AS SHOWN Vert: AS SHOWN
Designed	SKW/MLA	Checked	TCB
Drawn	TCB	Approved	TCB
Date	11/24/2009		Project No.
Sheet	28 of 216		60004153



ITEM SPEC NO.	DESCRIPTION	UNIT	QUANTITY
* 100	PREP ROW (STORM DRAIN STRUCTURE REMOVAL)	LF	0
* 104	REMOVING CONCRETE (CONCRETE PVMT)	SY	0
* 100	PREP ROW (FENCE REMOVAL)	LF	449
* 100	REMOVE DIRT/GRAVEL ROAD	SY	641

\* THESE ITEMS ARE SUBSIDIARY TO ITEM 100, PREP. ROW.  
NOTE: ALL QUANTITIES SHOWN ARE FOR CONTRACTORS' INFORMATION ONLY.

P:\4328\60004153-205bypass\cadd\sheet\phase 6 - fms52 to 205\record.drawing 10\_T\_09\0280.dwg - 12.dgn  
 11/24/2009