



SECTION A-A

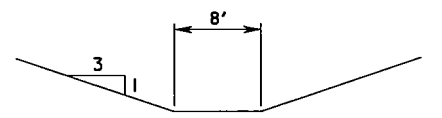

SECTION B-B

4" MANUFACTURED TOPSOIL (B05) (TYP)

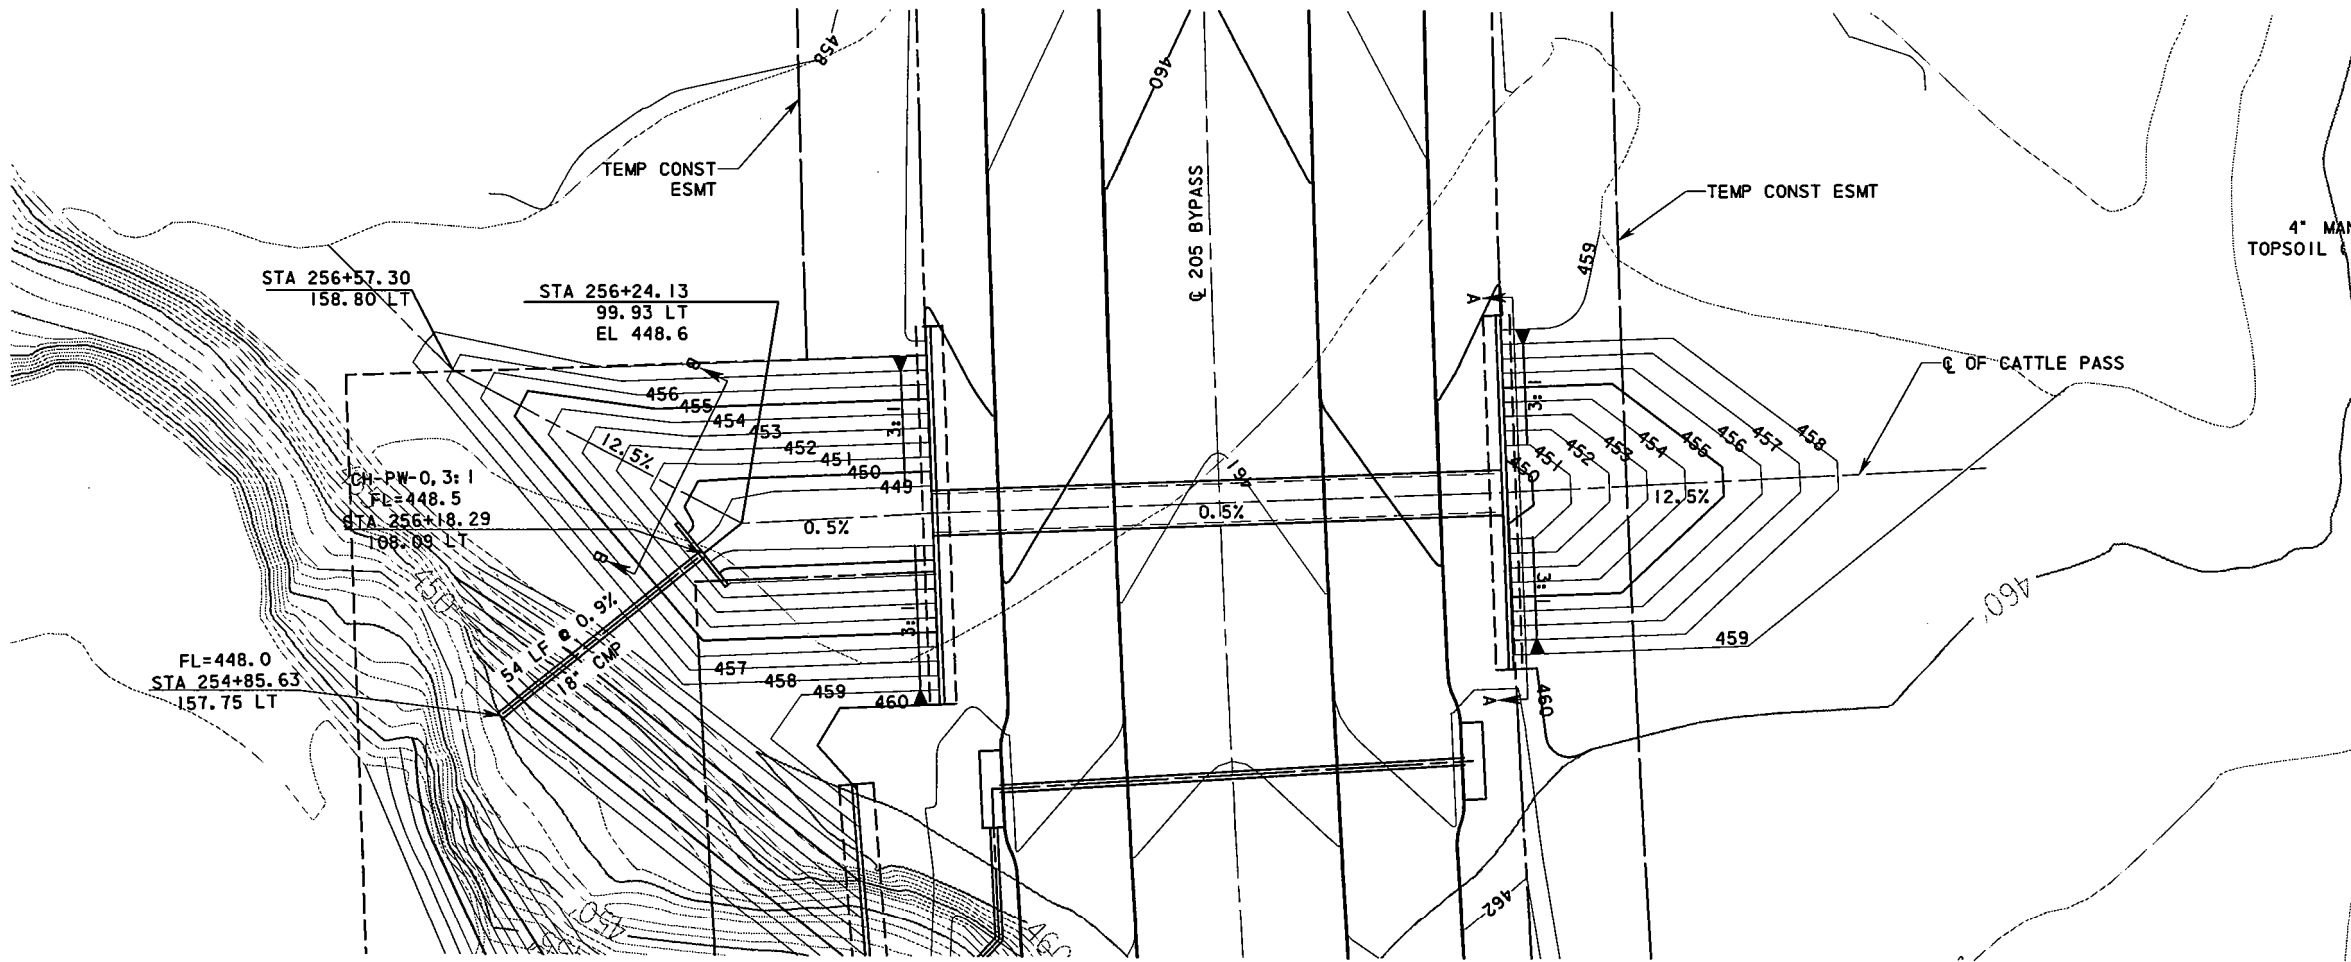

STA 256+57.30  
158.80 LT

STA 256+24.13  
99.93 LT  
EL 448.6

CH-PW-0, 3:1  
FL=448.5  
STA 256+18.29  
108.09 LT

FL=448.0  
STA 254+85.63  
157.75 LT

NOTES:

- CELLULOSE FIBER MULCH SEEDING IN ALL DISTURBED AREA PER TXDOT SPEC ITEM 164.



*Thomas H. Gaertner*  
5/20/08

NO.	REVISION	BY	DATE



City of Rockwall, Texas

205 BYPASS  
PHASE 6

GRADING PLAN  
STOCK PASS STA 256+24.38

2 OF 2

TCB | AECOM  
TCB INC.  
WWW.TCB.AECOM.COM  
17300 DALLAS PARKWAY, SUITE 1010  
DALLAS, TEXAS 75248

Unit	PW-DAL-FW	Scale	Horz AS SHOWN Vert AS SHOWN	Date	5/20/2008
Designed	RI/US	Checked	TCB	Project No.	60004153
Drawn	FC	Approved	TCB	Sheet	216 of 216