

- NOTES:
1. ALL CONDUIT FOR ILLUMINATION ASSEMBLIES SHALL BE PLACED 3-FT FROM 205 BYPASS CENTERLINE.
 2. CONDUIT INSTALLATION WILL BE PHASED IN FOLLOWING SUBGRADE OPERATIONS AND FOLLOWING UTILITY CONSTRUCTION, BUT PRIOR TO ROADWAY PAVEMENT CONSTRUCTION. IF CONSTRUCTION ACTIVITIES REQUIRE CONDUIT PLACEMENT AFTER STREET PAVEMENT CONSTRUCTION, THEN CONDUIT WILL NEED TO BE BORED FOR PLACEMENT. OPEN CUT METHOD OF CONDUIT PLACEMENT WILL NOT BE PERMITTED ON NEW PAVEMENT.
 3. CONDUIT LENGTHS SHOWN REPRESENT ENTIRE RUN (GROUND BOX-TO-GROUND BOX).
 4. IRRIGATION SLEEVES SHOULD BE INSTALLED 1-FT AWAY FROM BOXES SHOWN ON PLANS, AND NOT CONNECT TO BOXES.


LEGEND

	PROPOSED ELEC. GROUND BOX
	PROPOSED 2' CONDUIT
	PROPOSED 4' IRRIGATION SLEEVE
	PROPOSED IRRIG. VALVE BOX
	PROPOSED ILLUMINATION POLE BASE FOUNDATION FOR 30' POLE.

RECORD DRAWING

This drawing is a compilation of the original sealed engineering drawing and modifications by addenda, change orders and information furnished by the contractor. Information shown that was provided by the contractor and others not associated with the design engineer cannot be verified for accuracy or completeness. Original sealed drawing is on file at the office of AECOM USA Group, Inc. TBPE REG. NO F-3082

ORIGINAL DRAWING SEALED & SIGNED BY
T.H. Gaertner, P.E.
TX NO 37124

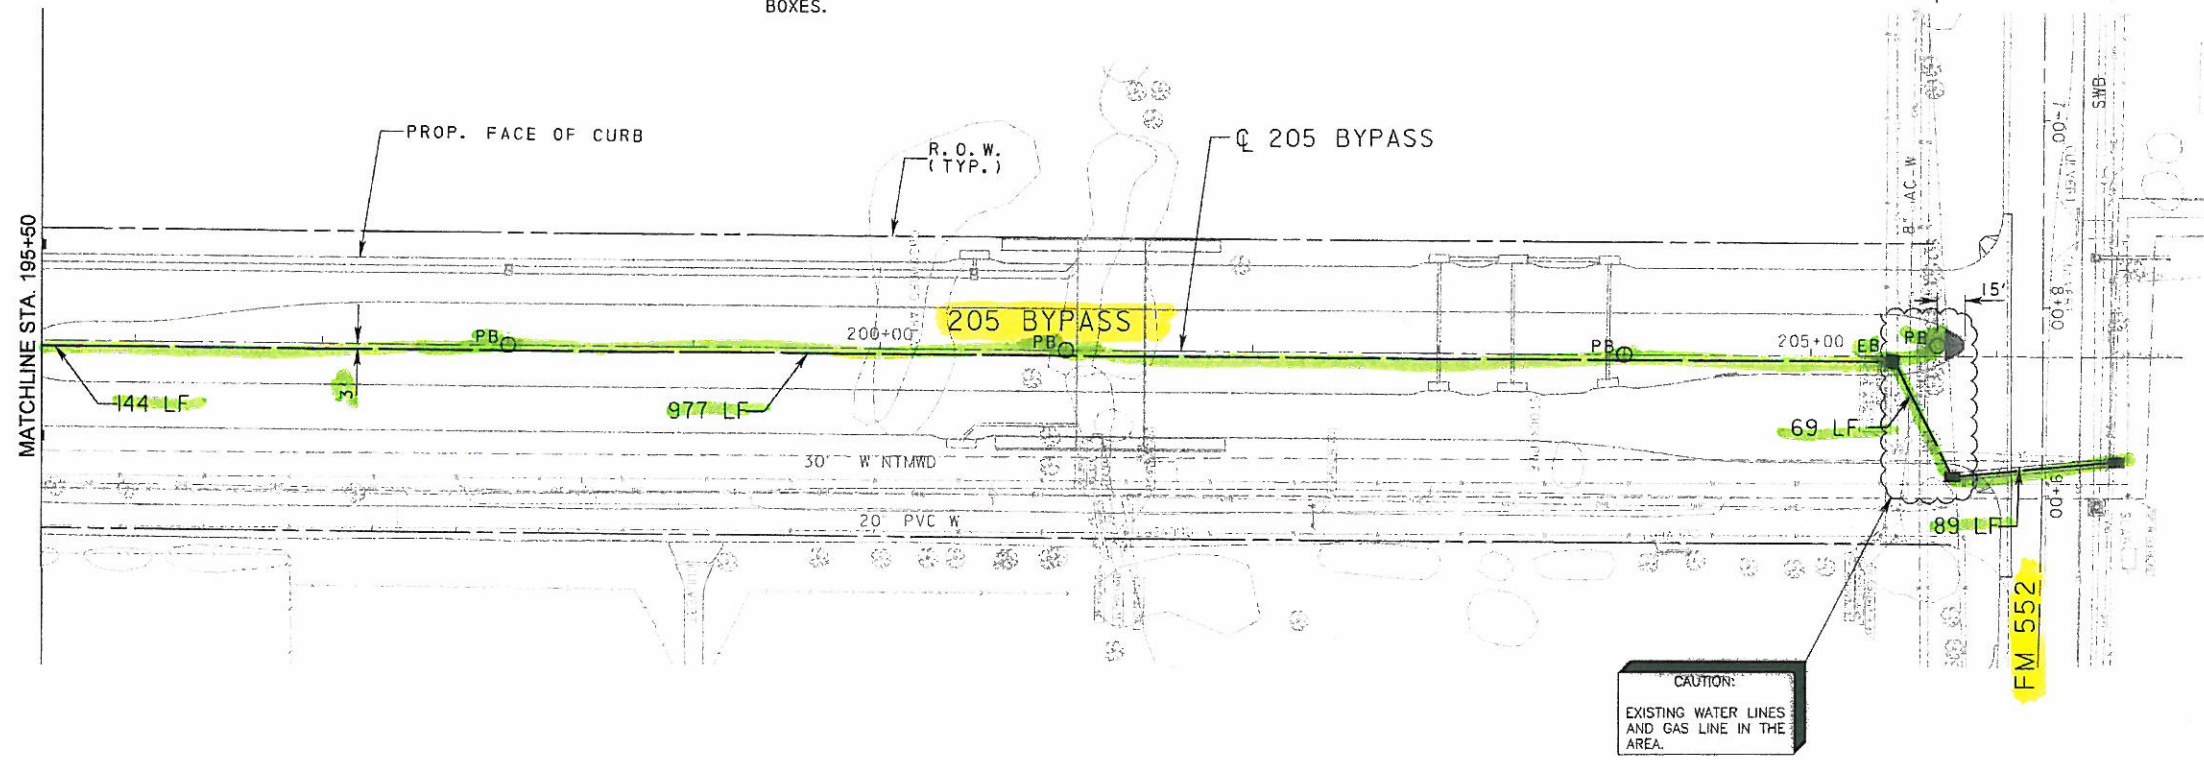

CAUTION:
EXISTING WATER LINES AND GAS LINE IN THE AREA.

I ADDED ILLUMINATION POLE BASES		THG	6/16/08
NO.	REVISION	BY	DATE
205 BYPASS SECTION 1			
ILLUMINATION & IRRIGATION PLAN			
3 OF 3			
TCB AECOM		TCB INC. WWW.TCB.AECOM.COM 1200 DALLAS PARKWAY SUITE 1010 DALLAS, TEXAS 75246	
Unit	PW-DAL-FW	Scale	Horizontal AS SHOWN Vertical AS SHOWN
Designed	THG	Checked	TCB
Drawn	FG	Approved	TCB
Date	11/11/2009	Project No.	60004153
Sheet	111	of	217

P:\1428\60004153-2008\pss\A\000\Sheet\A\sect1\om1-140-00-To-FM552\Record-Drawing 10.7.09\1111\illumirrig 03.dgn
 11/11/2009