



TIME 9:55 FILE: DAMAP1-04124\_01.dwg

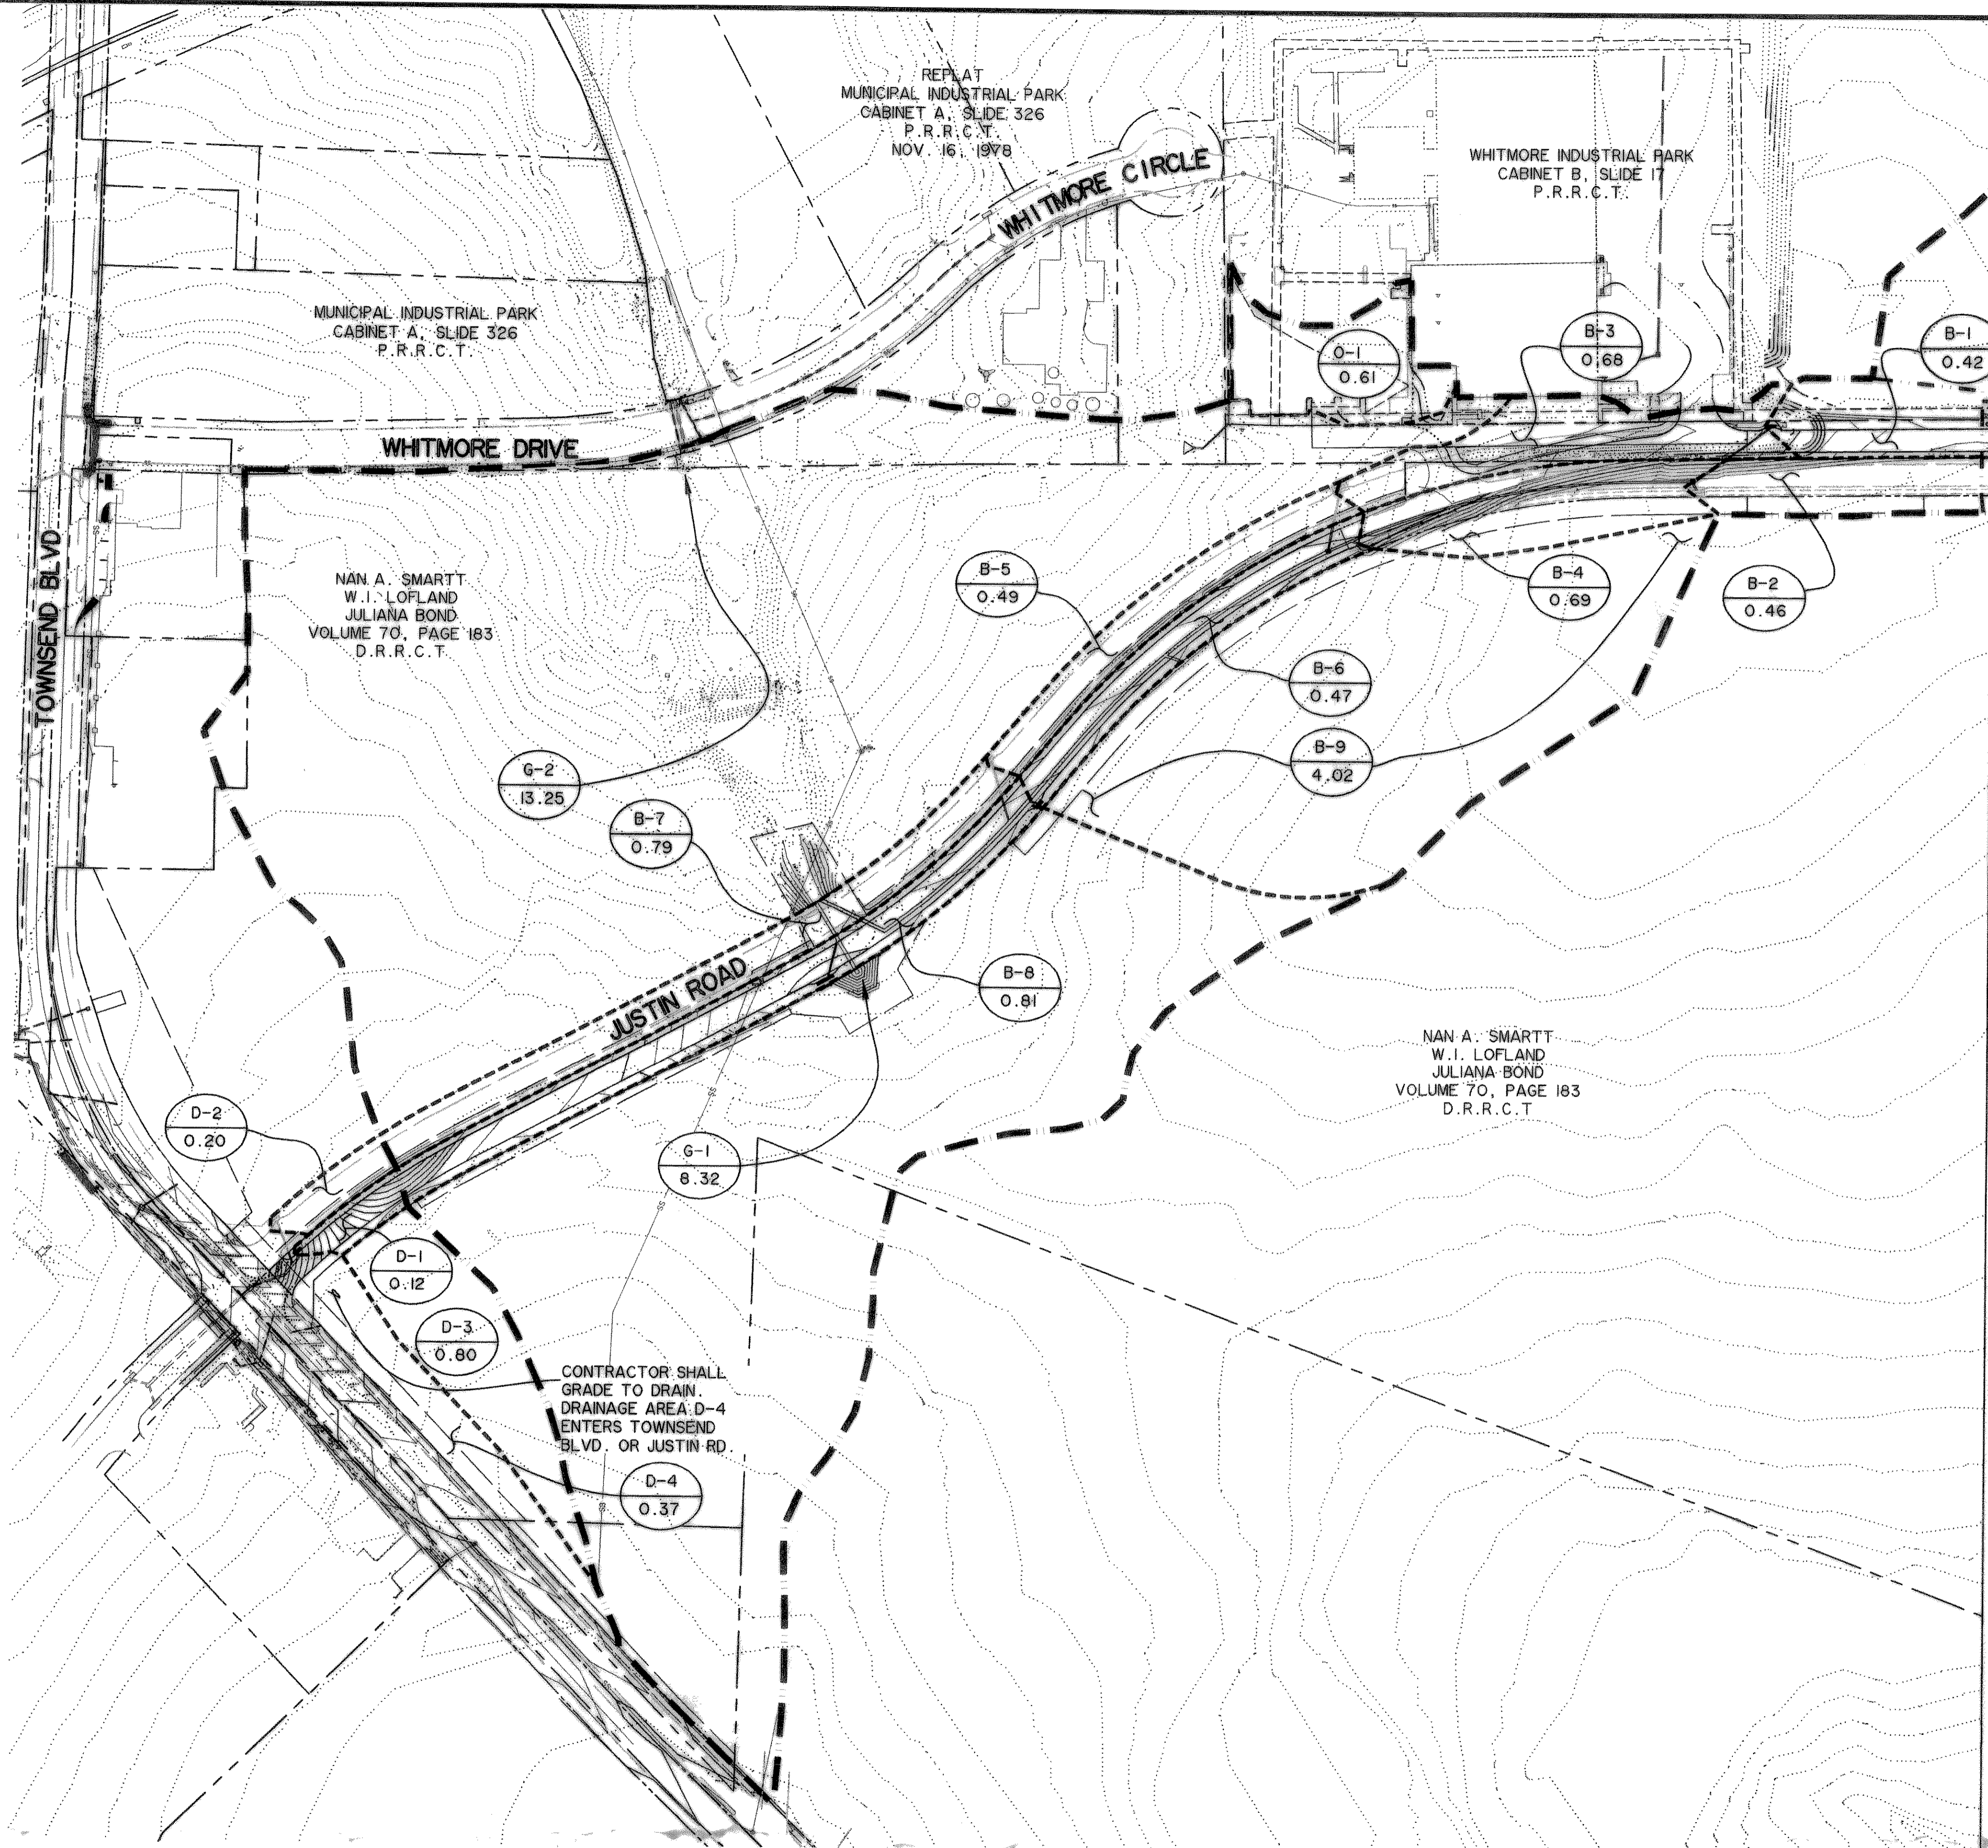

MATCH LINE

**RECORD  
DRAWING**  
2/18/09

PREPARED BY:  
**WIER & ASSOCIATES, INC.**  
ENGINEERS SURVEYORS LAND PLANNERS  
701 HIGHLANDER BLVD., SUITE 300 ARLINGTON, TEXAS 76015 METRO (817)467-7700  
6849 ELM STREET FRISCO, TEXAS 75004 METRO (214)387-8000  
www.wierassociates.com

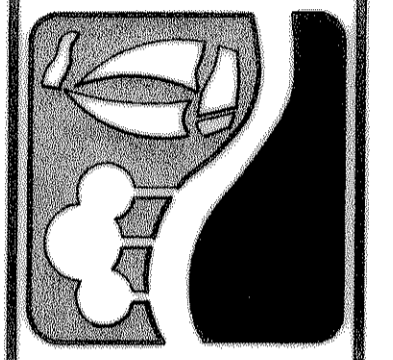

**CITY OF  
ROCKWALL  
JUSTIN ROAD  
EXTENSION**

**DRAINAGE  
AREA  
MAP**

STATE OF TEXAS  
RONALD RAMIREZ  
81821  
REGISTERED  
PROFESSIONAL ENGINEER  
2/18/09  
Ronald Ramirez  
COPYRIGHT ©  
WIER & ASSOCIATES, INC.  
LAST SHEET EDIT  
DATE 02-18-2009  
WA# 04124\_01  
SHEET NO.  
D001