




### FUTURE LATERAL "B-7"

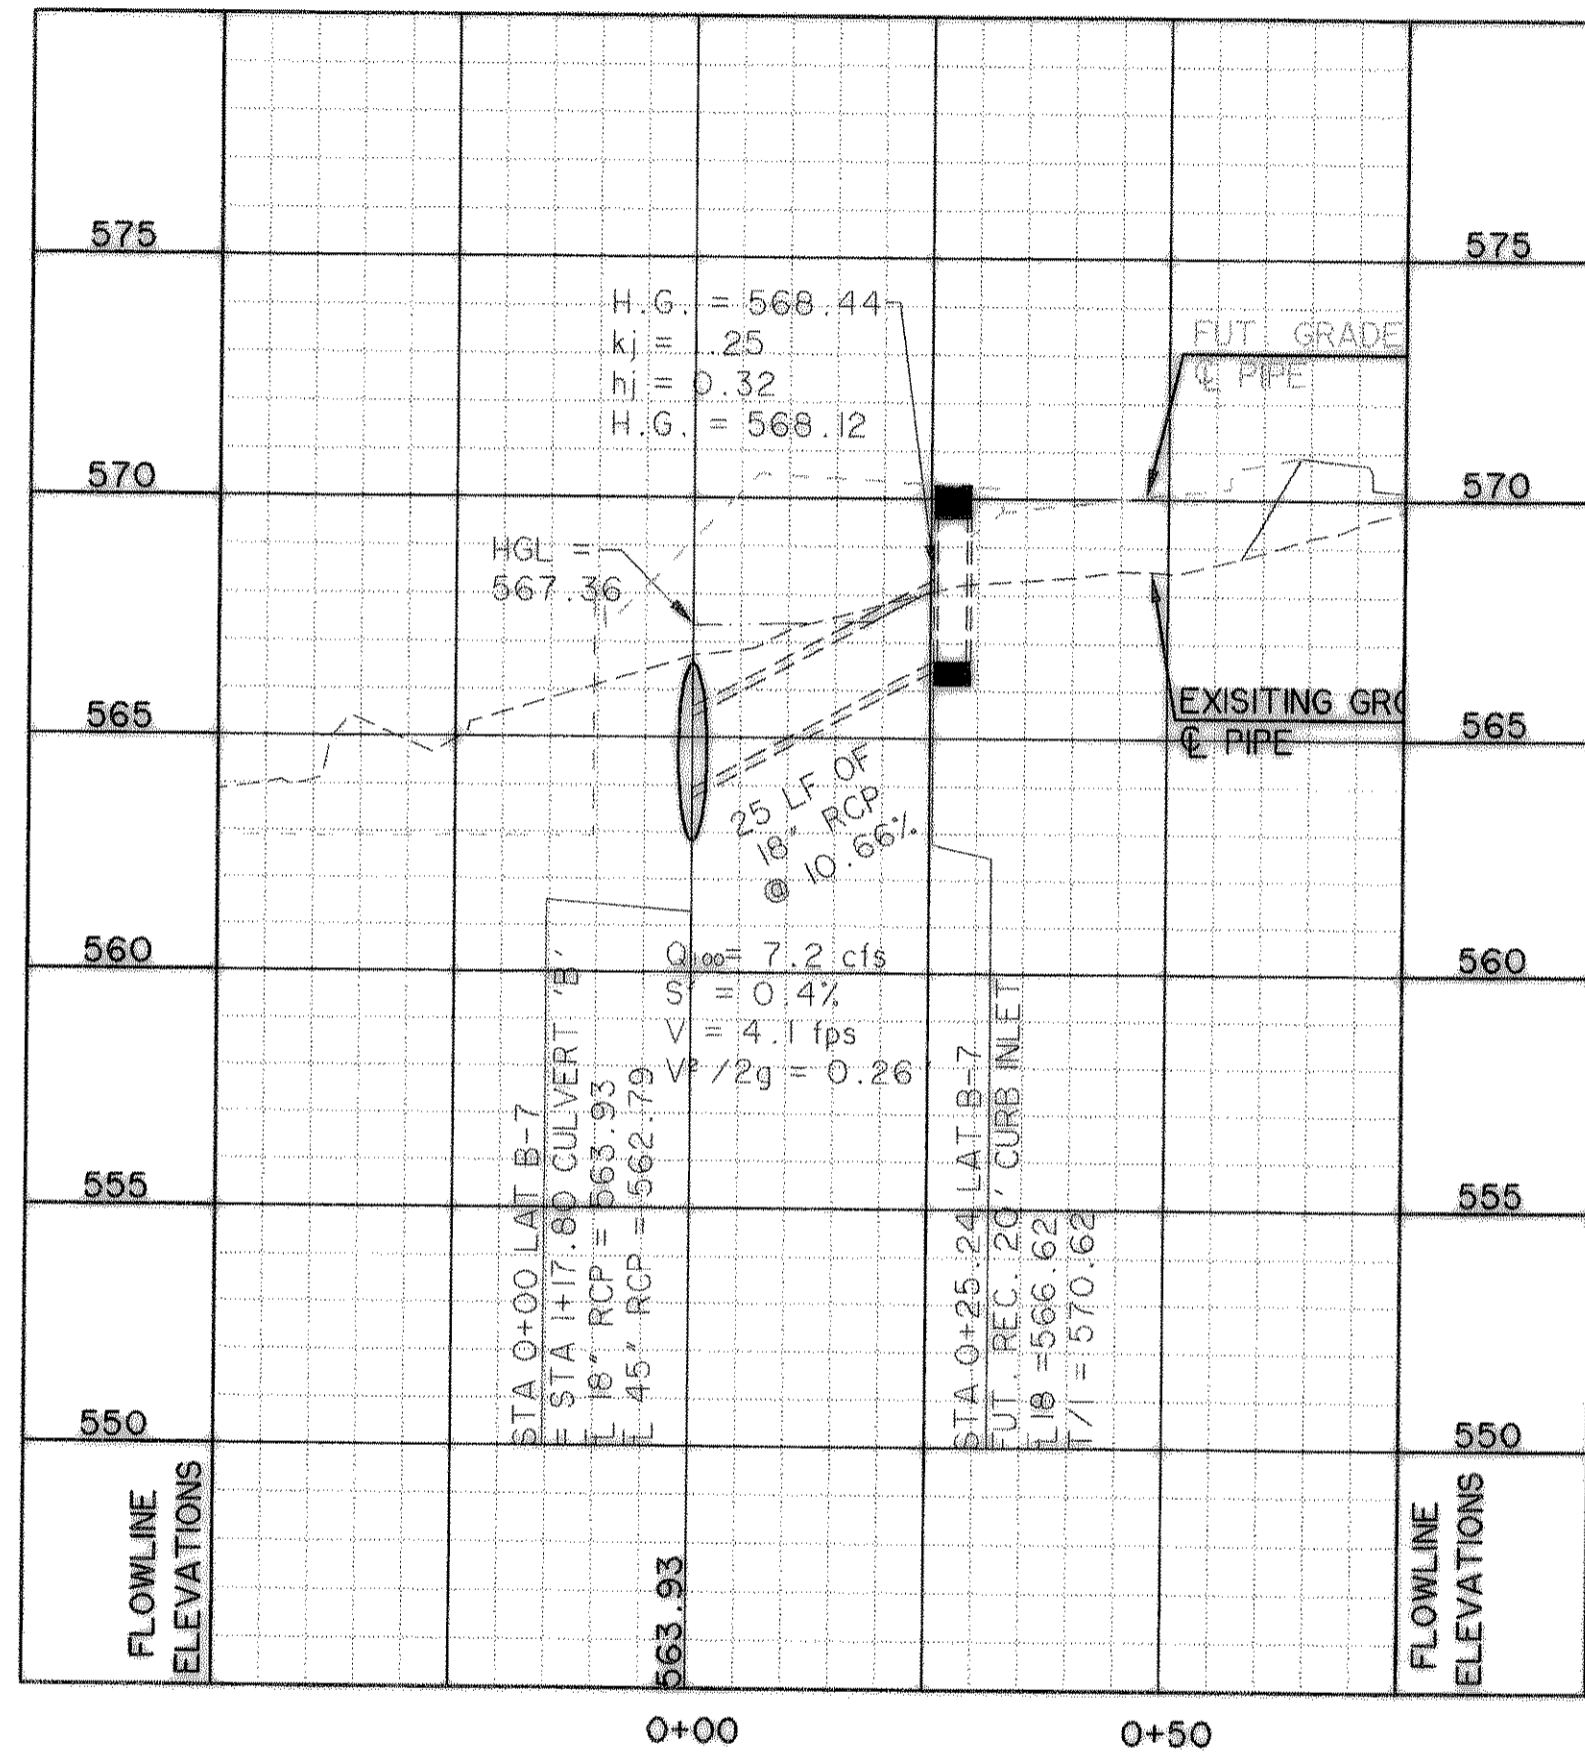

### LATERAL "B-8"

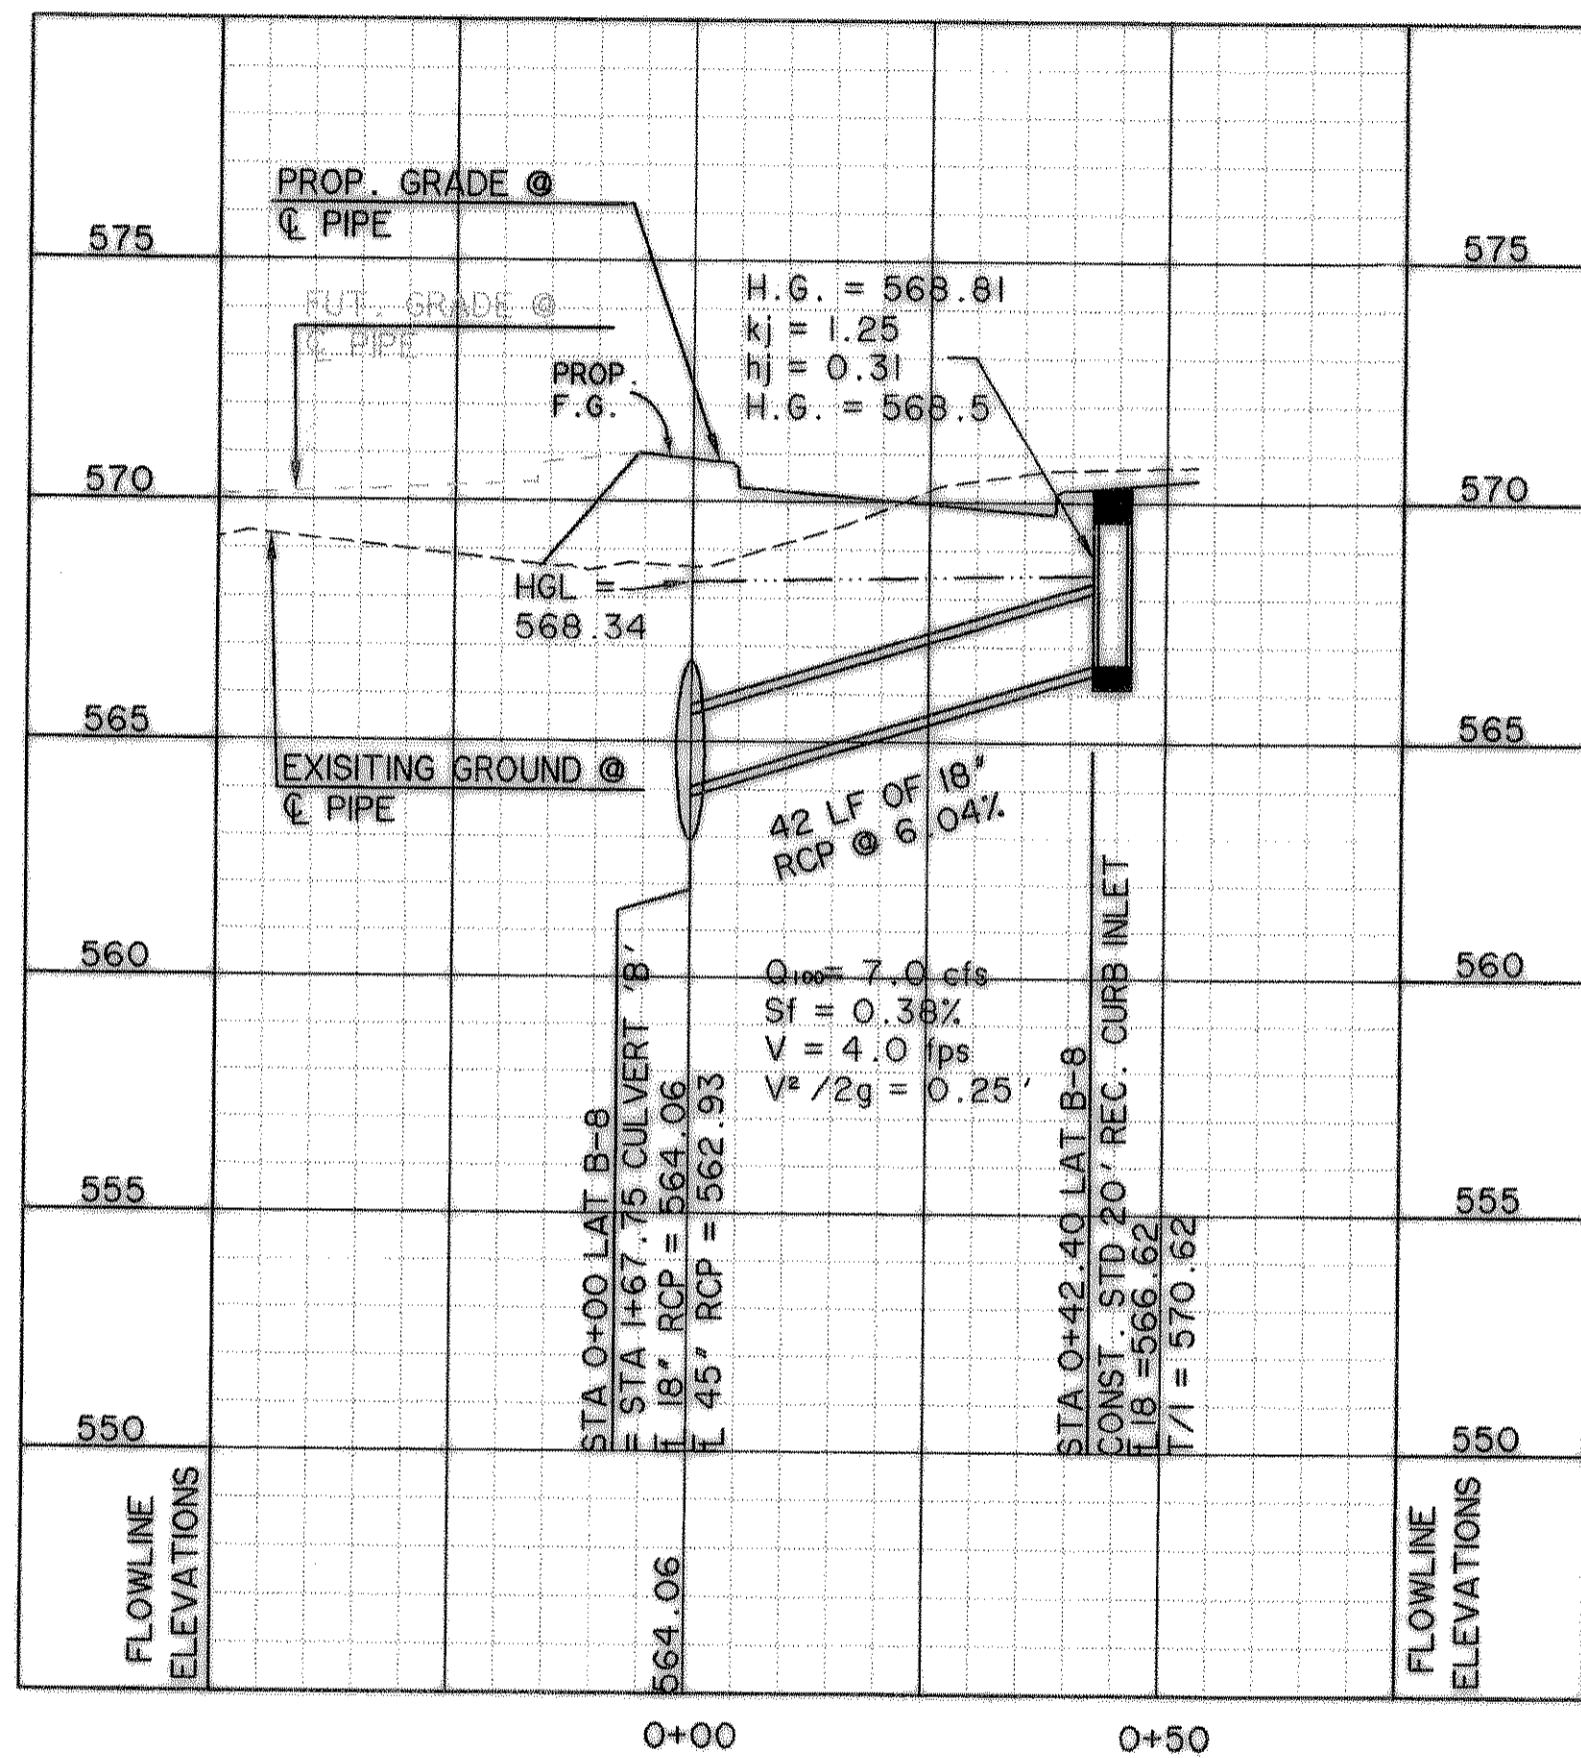


### LATERAL "B-9"

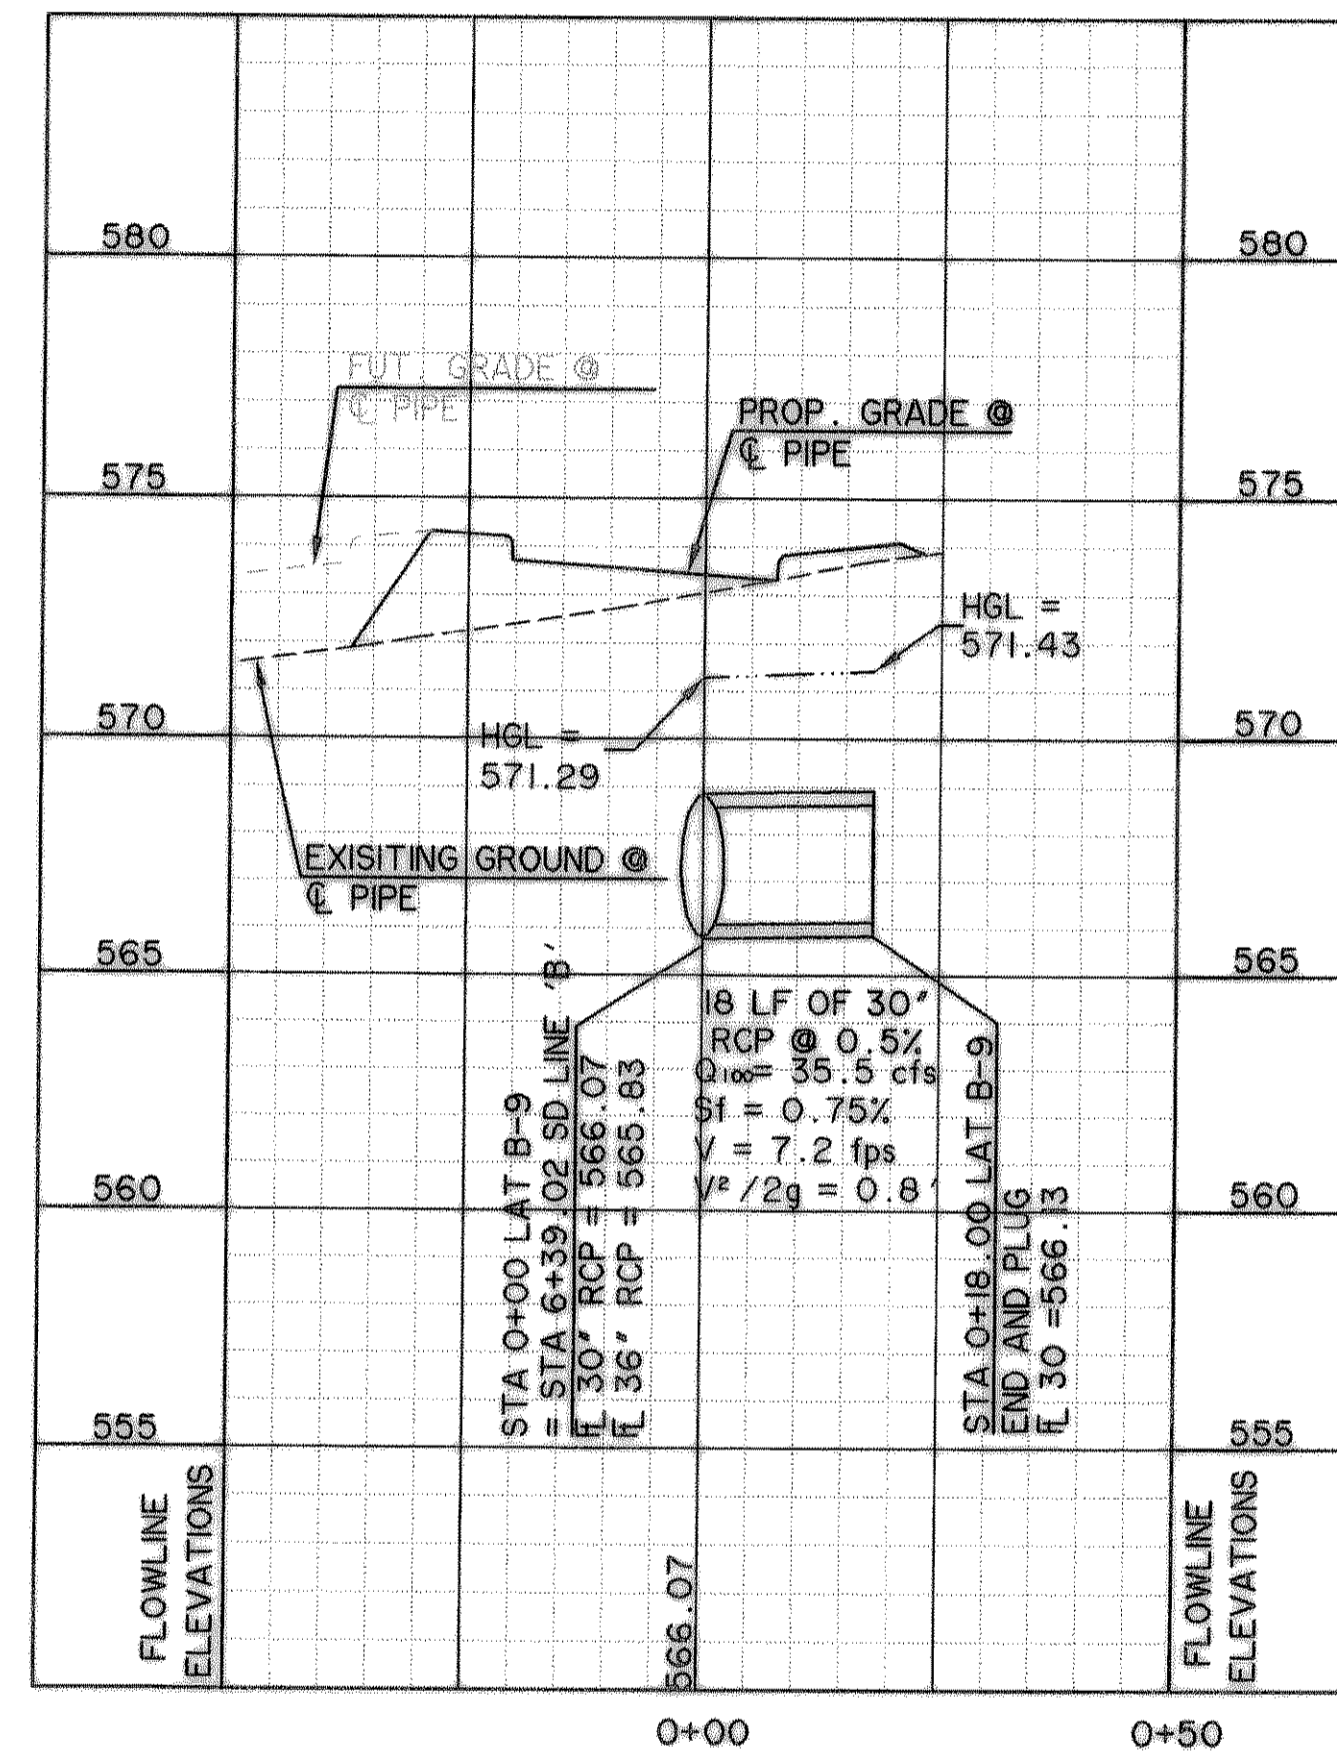

**RECORD DRAWING**  
2/18/09

PREPARED BY:  
**WIA WIER & ASSOCIATES, INC.**  
 ENGINEERS SURVEYORS LAND PLANNERS  
 701 HIGHLANDER BLD., SUITE 300 ARLINGTON, TEXAS 76015 METRO (817)467-7700  
 6849 ELM STREET FRISSO, TEXAS 75034 METRO (214)387-8000  
 www.wierassociates.com

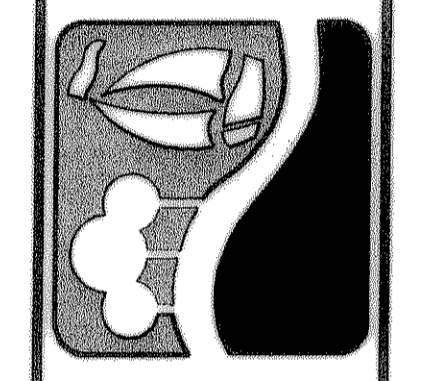

CITY OF  
**ROCKWALL**  
**JUSTIN ROAD**  
**EXTENSION**

STORMDRAIN  
 LATERALS  
 B-7 THRU B-10

STATE OF TEXAS  
 RONALD RAMIREZ  
 81821  
 REGISTERED PROFESSIONAL ENGINEER  
 Ronald Ramirez  
 COPYRIGHT ©  
 WIER & ASSOCIATES, INC.  
 LAST SHEET EDIT  
 DATE 04-28-2006  
 WA# 04124\_01  
**SHEET NO.**  
 D111