

MATCHLINE STA 11+05.74

NAN A. SMARTT
W.I. LOFLAND
JULIANA BOND
VOLUME 70, PAGE 183
D.R.R.C.T

EXIST. FENCE
TO BE REMOVED

INSTALL PERMANENT
5-STRAND BARBED WIRE
FENCING

INSTALL TEMPORARY
5-STRAND BARBED WIRE
FENCING

INSTALL PERMANENT
5-STRAND BARBED WIRE
FENCING

NAN A. SMARTT
W.I. LOFLAND
JULIANA BOND
VOLUME 70, PAGE 183
D.R.R.C.T

CAUTION !!
EXISTING UTILITIES ARE INDICATED ON THE PLANS FROM AVAILABLE INFORMATION. IT SHALL BE THE RESPONSIBILITY OF THE CONTRACTOR TO VERIFY THE LOCATION OF ALL UTILITIES, TO NOTIFY ALL UTILITY COMPANIES OF THE CONTRACTORS OPERATIONS, TO PROTECT ALL UTILITIES FROM DAMAGE, TO REPAIR ALL UTILITIES DAMAGED DUE TO THE CONTRACTORS OPERATIONS, AND TO NOTIFY THE ENGINEER PROMPTLY OF ALL CONFLICTS OF THE WORK WITH EXISTING UTILITIES.


GENERAL FENCE NOTES

- I. CONTRACTOR SHALL MAINTAIN SECURE AREAS FOR CATTLE AT ALL TIMES.
2. DISPOSE OF EXISTING FENCING, DO NOT SALVAGE OR REUSE FENCE OR POSTS.

SEQUENCING

- I. INSTALL TEMPORARY FENCE ON SOUTH AND EAST OF PROPOSED ROADWAY, INCLUDING TEMPORARY GATES.
- II. CONSTRUCT ROADWAY FACILITIES.
- III. INSTALL ALL PERMANENT FENCING, INCLUDING GATES AT LOCATIONS PROVIDED BY THE OWNER.
- IV. REMOVE TEMPORARY FENCING.

PREPARED BY:
WIA WIER & ASSOCIATES, INC.
ENGINEERS SURVEYORS LAND PLANNERS
701 HIGHLANDER BLVD., SUITE 300 ARLINGTON, TEXAS 76015 METRO (817)467-7700
6946 ELM STREET FRODO, TEXAS 75034 METRO (214)397-8000
www.WierAssociates.com

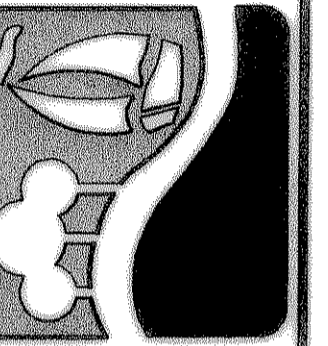

**CITY OF
ROCKWALL
JUSTIN ROAD
EXTENSION**

**LOFLAND FARMS
FENCE LAYOUT**




Ronald Ramirez

COPYRIGHT ©
WIER & ASSOCIATES, INC.
LAST SHEET EDIT
DATE 02-18-2009
WA# 04124.01

**SHEET NO.
F101**

**RECORD
DRAWING
2/18/09**

LEGEND	
	EXISTING FENCE TO BE REMOVED
	PROPOSED TEMPORARY FENCE
	PROPOSED PERMANENT FENCE

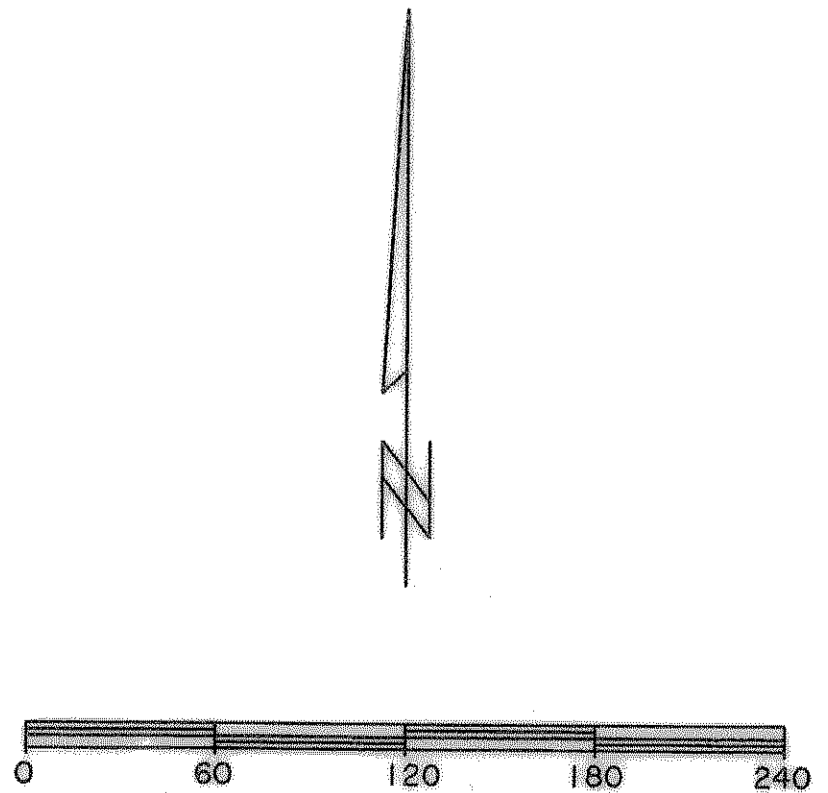

TIME 14:43 FILE: FENCE-1-04124_01.dwg