

TIME: 14.43 FILE: FENCE-2-04124_01.dwg

MATCHLINE STA 20+00

WHITMORE DRIVE

NAN A. SMARTT
W.I. LOFLAND
JULIANA BOND
VOLUME 70, PAGE 183
D.R.R.C.T.

INSTALL PERMANENT
5-STRAND BARBED WIRE
FENCING

INSTALL PERMANENT
5-STRAND BARBED WIRE
FENCING AND CONNECT
TO EXISTING FENCE

EXIST. FENCE
TO REMAIN

EXIST. FENCE
TO BE REMOVED

INSTALL PERMANENT
5-STRAND BARBED WIRE
FENCING

NAN A. SMARTT
W.I. LOFLAND
JULIANA BOND
VOLUME 70, PAGE 183
D.R.R.C.T.

INSTALL TEMPORARY
5-STRAND BARBED WIRE
FENCING

MATCHLINE STA 11+05.74

WHITMORE INDUSTRIAL PARK
CABINET B, SLIDE 17
P.R.R.C.T.

WHITMORE MANUFACTURING COMPANY
VOLUME 453, PAGE 167
D.R.R.C.T.

EXIST. FENCE
TO BE REMOVED

EXIST. FENCE
TO BE REMOVED

JUSTIN ROAD

INSTALL PERMANENT
5-STRAND BARBED WIRE
FENCING

INSTALL TEMPORARY
5-STRAND BARBED WIRE
FENCING

NAN A. SMARTT
W.I. LOFLAND
JULIANA BOND
VOLUME 70, PAGE 183
D.R.R.C.T.

GENERAL FENCE NOTES

1. CONTRACTOR SHALL MAINTAIN SECURE AREAS FOR CATTLE AT ALL TIMES.
2. DISPOSE OF EXISTING FENCING, DO NOT SALVAGE OR REUSE FENCE OR POSTS.

SEQUENCING

- I. INSTALL TEMPORARY FENCE ON SOUTH AND EAST OF PROPOSED ROADWAY, INCLUDING TEMPORARY GATES.
- II. CONSTRUCT ROADWAY FACILITIES.
- III. INSTALL ALL PERMANENT FENCING, INCLUDING GATES AT LOCATIONS PROVIDED BY THE OWNER.
- IV. REMOVE TEMPORARY FENCING.

CAUTION !!

EXISTING UTILITIES ARE INDICATED ON THE PLANS FROM AVAILABLE INFORMATION. IT SHALL BE THE RESPONSIBILITY OF THE CONTRACTOR TO VERIFY THE LOCATION OF ALL UTILITIES, TO NOTIFY ALL UTILITY COMPANIES OF THE CONTRACTORS OPERATIONS, TO PROTECT ALL UTILITIES FROM DAMAGE, TO REPAIR ALL UTILITIES DAMAGED DUE TO THE CONTRACTORS OPERATIONS, AND TO NOTIFY THE ENGINEER PROMPTLY OF ALL CONFLICTS OF THE WORK WITH EXISTING UTILITIES.

LEGEND


	EXISTING FENCE TO BE REMOVED
	PROPOSED TEMPORARY FENCE
	PROPOSED PERMANENT FENCE

**RECORD
DRAWING
2/18/09**




MATCHLINE STA 20+00

PREPARED BY:
WIER & ASSOCIATES, INC.
ENGINEERS SURVEYORS LAND PLANNERS
701 HIGHLANDER BLVD., SUITE 300 ARLINGTON, TEXAS 76015 METRO (817)467-7700
6849 ELM STREET FRISCO, TEXAS 75034 METRO (214)387-8000
www.wierassociates.com

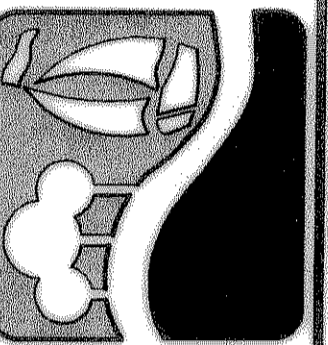

**CITY OF
ROCKWALL
JUSTIN ROAD
EXTENSION**

**LOFLAND FARMS
FENCE LAYOUT**

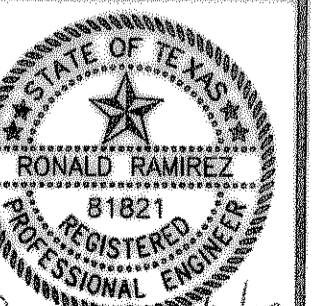

Ronald Ramirez

COPYRIGHT ©
WIER & ASSOCIATES, INC.
LAST SHEET OF 11
DATE 02-18-2009
WA# 04124.01

**SHEET NO.
F102**