


CAUTION !!
 EXISTING UTILITIES ARE INDICATED ON THE PLANS FROM AVAILABLE INFORMATION. IT SHALL BE THE RESPONSIBILITY OF THE CONTRACTOR TO VERIFY THE LOCATION OF ALL UTILITIES, TO NOTIFY ALL UTILITY COMPANIES OF THE CONTRACTORS OPERATIONS, TO PROTECT ALL UTILITIES FROM DAMAGE, TO REPAIR ALL UTILITIES DAMAGED DUE TO THE CONTRACTORS OPERATIONS, AND TO NOTIFY THE ENGINEER PROMPTLY OF ALL CONFLICTS OF THE WORK WITH EXISTING UTILITIES.


| LEGEND | |
|--------|--|
| | PROPOSED STREET LIGHT AS PER TXU-ONCOR |
| | FUTURE STREET LIGHT |
| | PROPOSED ELECTRIC CONDUIT |

PREPARED BY:
WIA WIER & ASSOCIATES, INC.
 ENGINEERS SURVEYORS LAND PLANNERS
 701 HIGHLANDER BLVD., SUITE 300 ARLINGTON, TEXAS 76015 METRO (817)467-7700
 6848 ELM STREET FORT COCK, TEXAS 75034 METRO (214)387-8000
 www.wierassociates.com

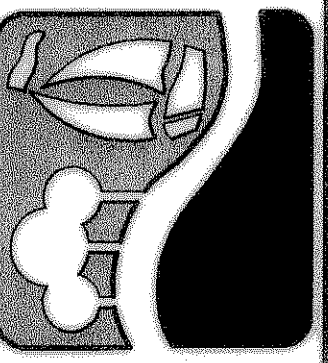

**CITY OF
 ROCKWALL
 JUSTIN ROAD
 EXTENSION**

**STREET LIGHT
 PLAN**

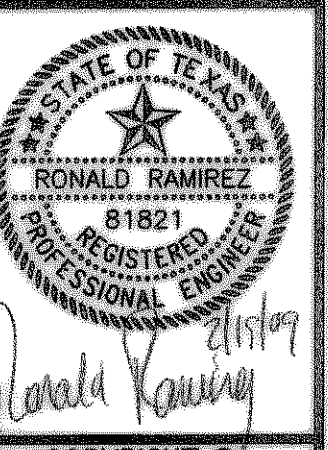

COPYRIGHT ©
 WIER & ASSOCIATES, INC.
 LAST SHEET EDITION
 DATE 02-18-2009
 WA# 04124.01
**SHEET NO.
 L102**

TIME 16:17 FILE: STLIGHTS-2-04124-01.dwg