


- NOTE: ALL PROPOSED DRIVE APPROACHES SHALL BE 12' WIDE & EXTENDED TO R.O.W. LINE EXCEPT AS NOTED ON PLANS.
- NOTE: ALL RAVIN ON DRIVES WILL BE 5' EXCEPT AS NOTED ON PLANS.
- NOTE: ALL UNDERGROUND UTILITIES TO BE RELOCATED OR ADJUSTED TO NEW PAVEMENT OR PARKWAY GRADE. PRIOR TO ANY PAVEMENT CONSTRUCTION.
- NOTE: ALL EXISTING DRAINAGE PIPES TO BE REMOVED & SALVAGED EXCEPT AS NOTED ON THE STORM SEWER DESIGN PLANS.
- NOTE: POWER POLES & TELEPHONE BOXES TO BE RELOCATED BY OTHERS PRIOR TO CONSTRUCTION.
- NOTE: ALL CONSTRUCTION SHALL MEET CITY OF ROCKWALL SPECIFICATIONS.
- NOTE: CONTRACTOR SHALL HAVE ONE LANE REMAINED OPEN FOR TRAFFIC FLOW AT ALL TIMES.
- NOTE: STREET CONSTRUCTION - 6" - 3500 P.S.I. CONCRETE W/ #3 BARS ON 2" C-C EACH WAY ON 6" LIME STABILIZED SUBGRADE W/ A MINIMUM OF 7% LIME.

LEGEND

- Power Pole ○
- Telephone Box □
- Telephone M.H. ⊗
- Gas Meter ⊕
- Fire Hydrant ⊕
- Water Meter ⊕
- Water Valve ⊕
- San Sewer M.H. ⊕

B.M. - Bolt on Fire Hydrant @ S.W. Corner of Heath Street & N. Alamo St. Elev = 570.77

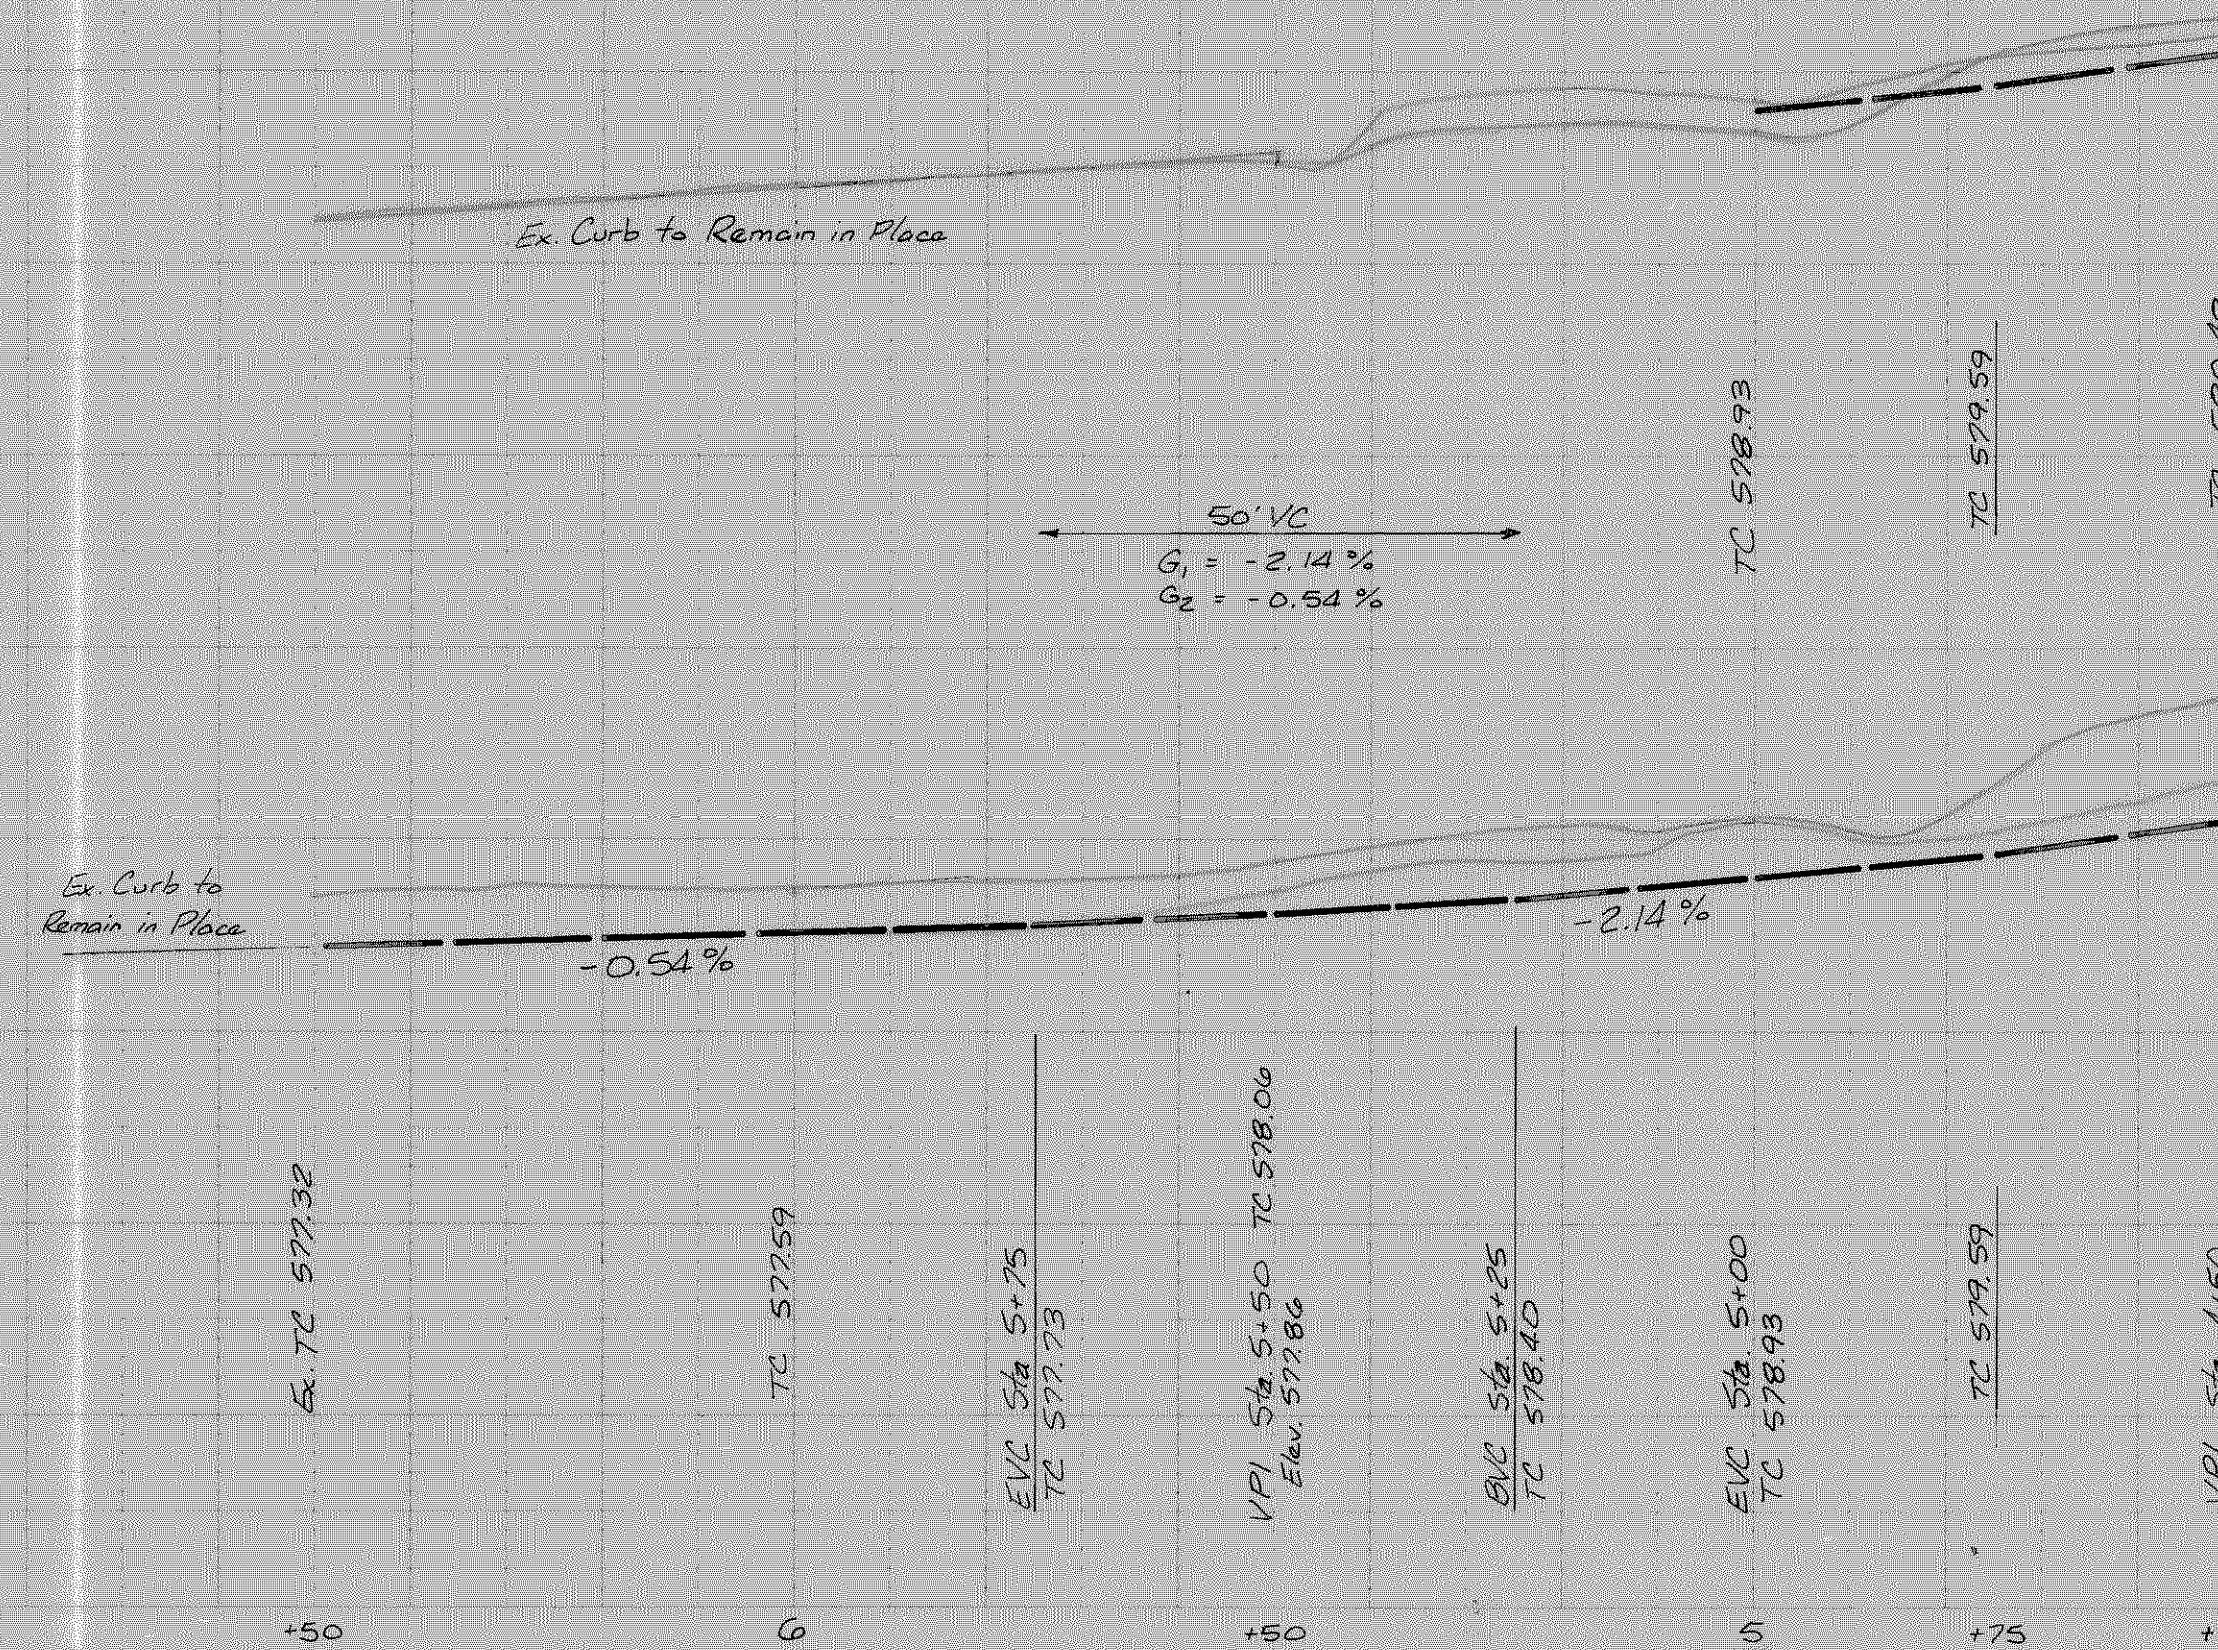

REVISION NO.	REMARKS	DATE
PAVING IMPROVEMENTS KAUFMAN STREET		
CITY OF ROCKWALL, TEXAS 205 W. RUSK STREET 214-771-1111		
DESIGNED:	W.L.D.	SCALE: NOTED
DRAWN:	C.L.R.	APPROVED: <i>[Signature]</i>
JOB NO.	87008	DATE: 5-88 SHEET NO. 30