
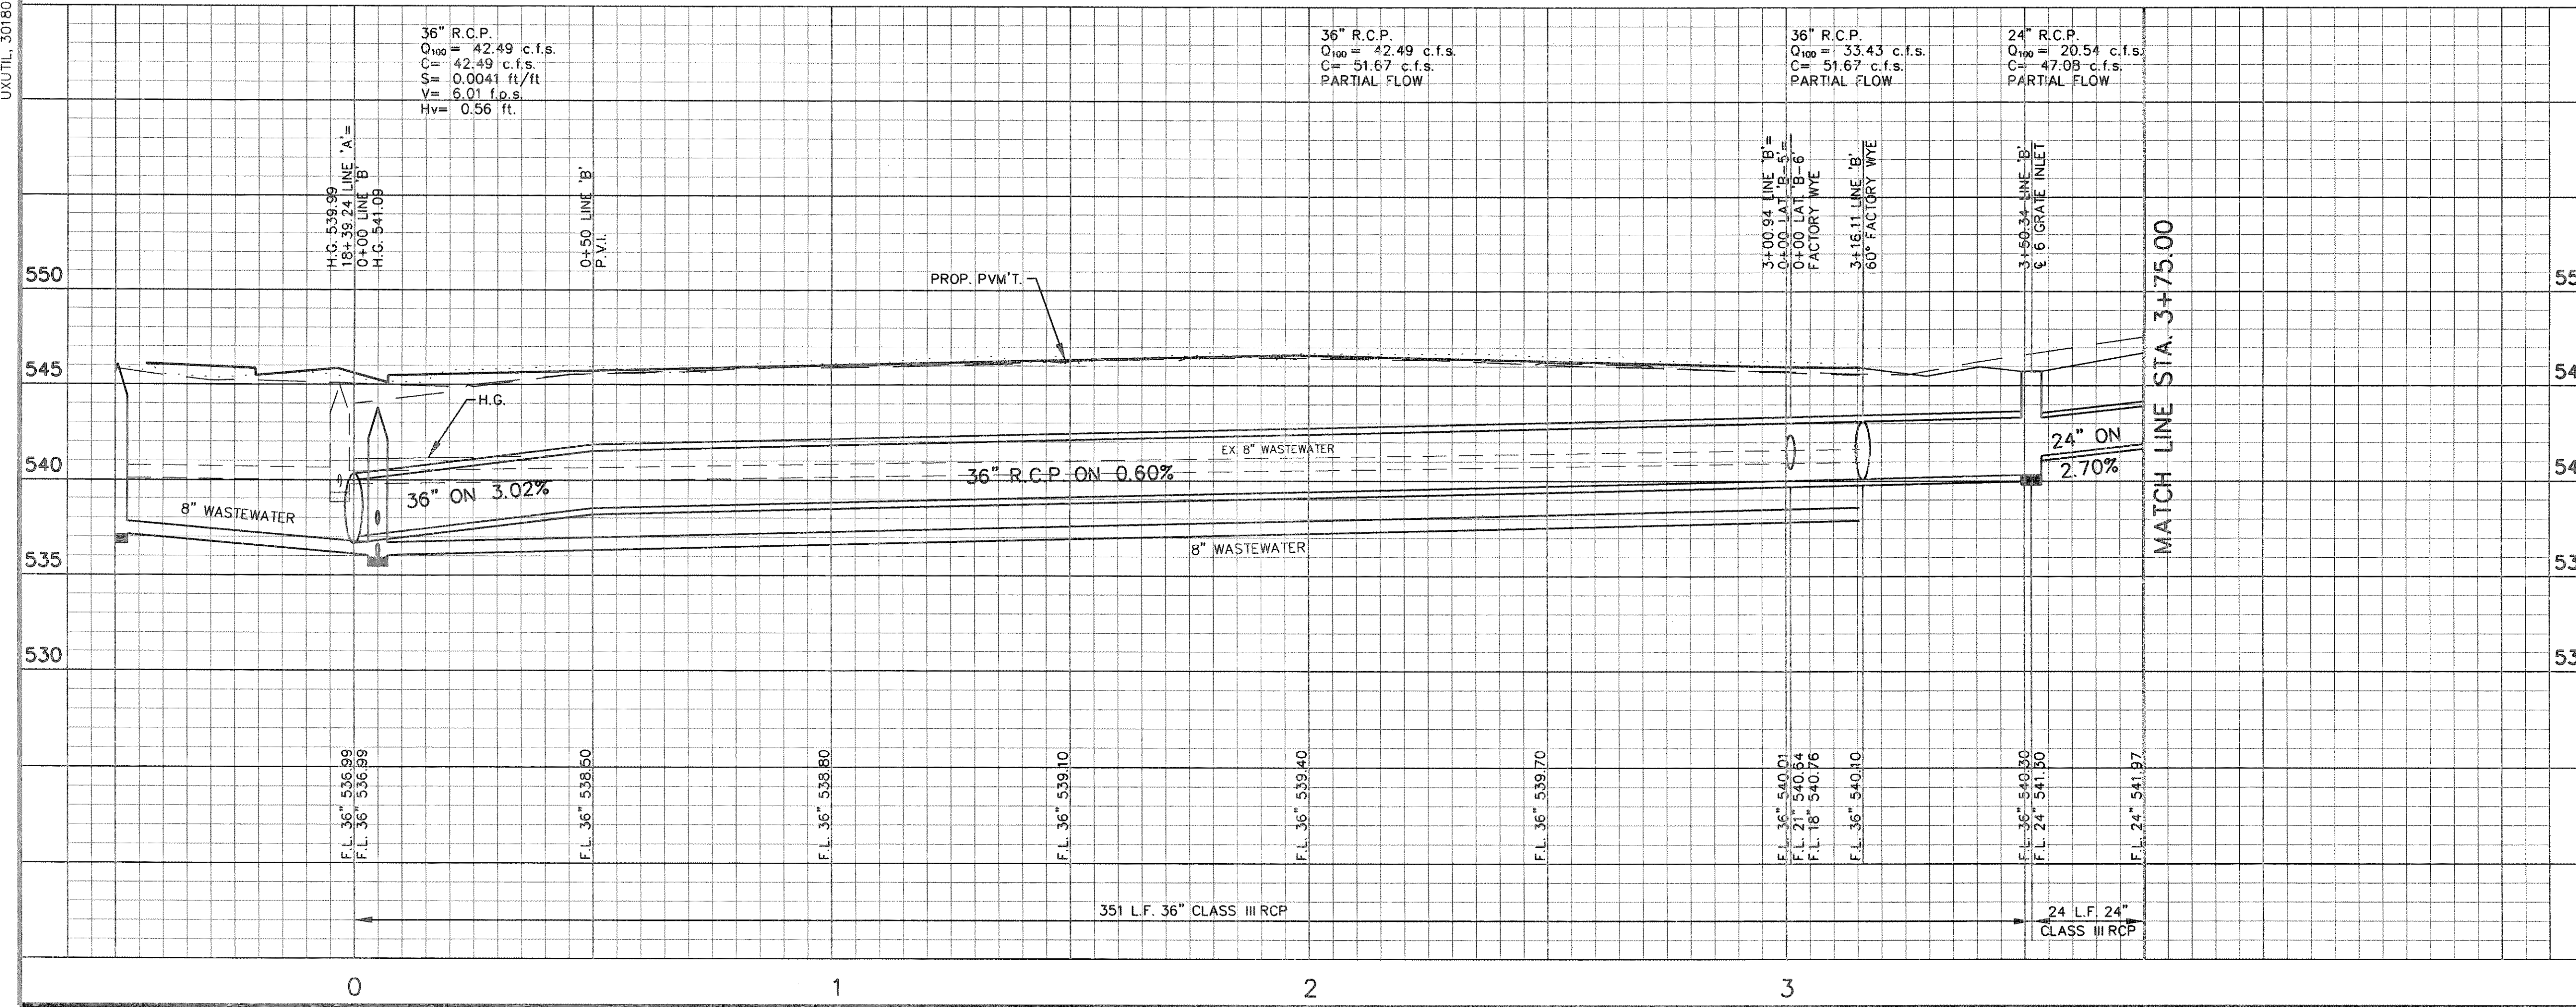


UWPLAN, 301801UWTR1.DGN, 17,18,20,21,48-54
 USSPLAN, 301801USSR1.DGN, 17,18,20,21,35-38,40,41
 CVALIGN, 301801CVAR1.DGN, 1,2,23,27,28
 USPLAN, 301801USDR1.DGN, 17-21,23-31
 UTPROF2SM, 301801UPFR2.DGN, 2,3,11,17,19,23,27,36,38-40,57,56,60
 UTPROF2WW, 301801UPFR2.DGN, 36,37,55,56

BORDER, 301801BDR1.DGN, 1-4,7,11,12,21,30,31,37,40,41,45-48,50
 VFIELD, 301801VFR1.DGN, 20,24,26,28,43,56,57
 CHALIGN, 301801CHAR1.DGN, 1,3
 CSTPLAN, 301801CSTR1.DGN, 31,35
 CROW, 301801CROW1.DGN, 3,5,6
 UKUTILL, 301801UKXR1.DGN, 36,37,55,56


theresso
 SCALE=20.000000
 PRF ROTATION=0.000000
 F:\1b\1\H\Z\FULL.TBL

h:\proj\01301801\dgn\301801USD05.DGN
 DATE: 7/29/03
 TIME: 07:59:24

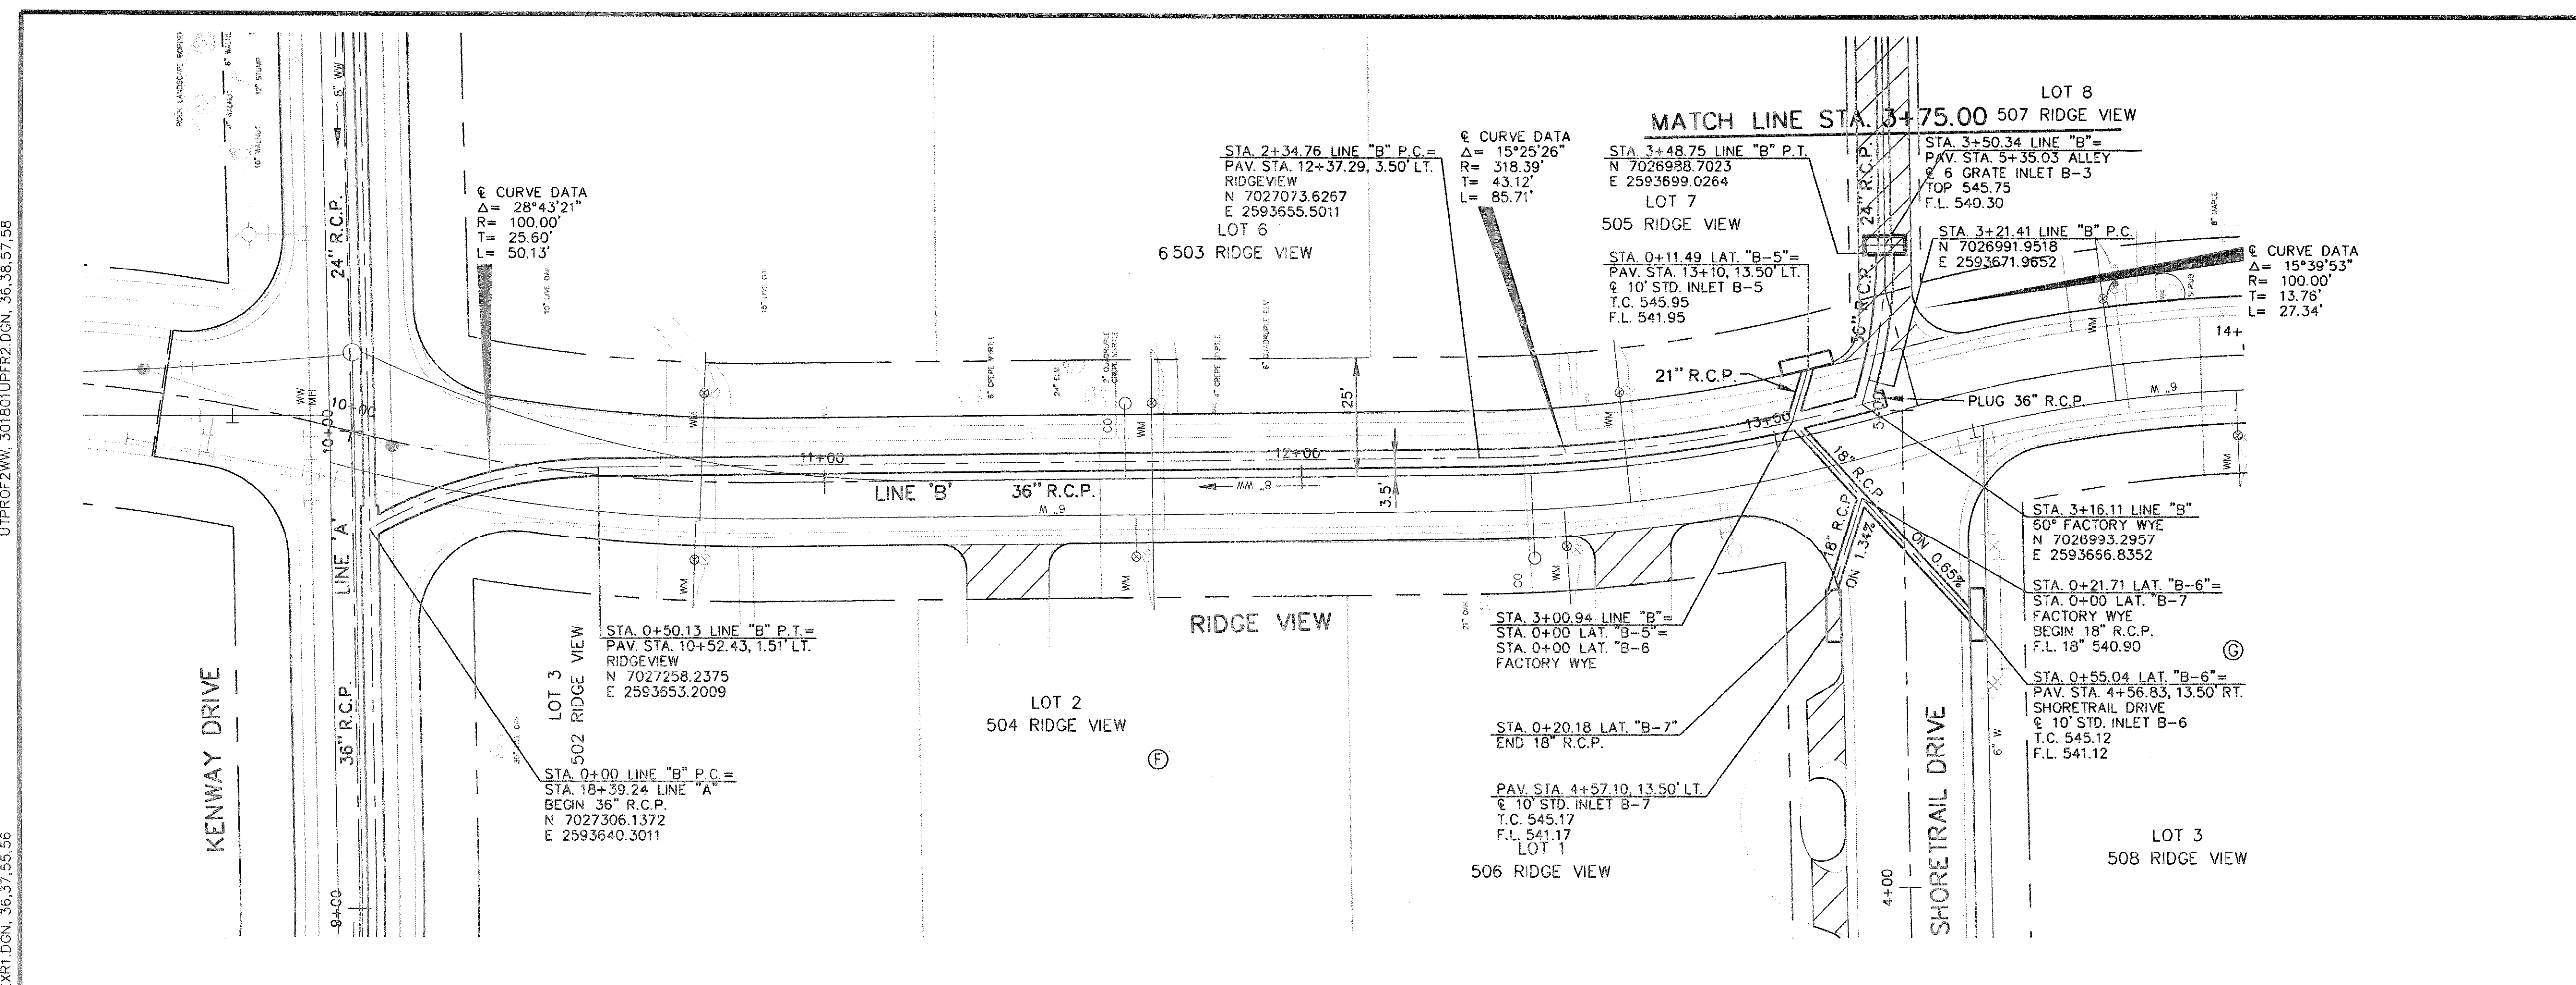

RECORD DRAWINGS JULY 25, 2003
 THIS RECORD DOCUMENT HAS BEEN PREPARED BASED ON INFORMATION PROVIDED BY OTHERS. THE CONSULTANT HAS NOT VERIFIED THE ACCURACY AND/OR COMPLETENESS OF THIS INFORMATION AND SHALL NOT BE RESPONSIBLE FOR ANY ERRORS OR OMISSIONS THAT MAY BE INCORPORATED AS A RESULT OF ERRONEOUS INFORMATION PROVIDED BY OTHERS.

BENCHMARKS:
 BM #1 "O" CUT ON BACK OF CURB NORTH SIDE OF SHORETRAIL DRIVE APPROXIMATELY 150 FT. WEST OF THE INTERSECTION OF SHORETRAIL DR. AND RIDGE VIEW, ALSO AT SOUTH SIDE BASE OF POWER POLE.
 ELEVATION = 550.33
 BM #2 "O" CUT ON BACK OF CURB E OF A CURB INLET ON SOUTH SIDE OF LAKE MEADOWS DR. BETWEEN LAKE MEADOWS DR. BETWEEN LAKE MEADOWS CT. AND LAKE MEADOW CIRCLE IN FRONT OF HOUSE # 709.
 ELEVATION = 484.53

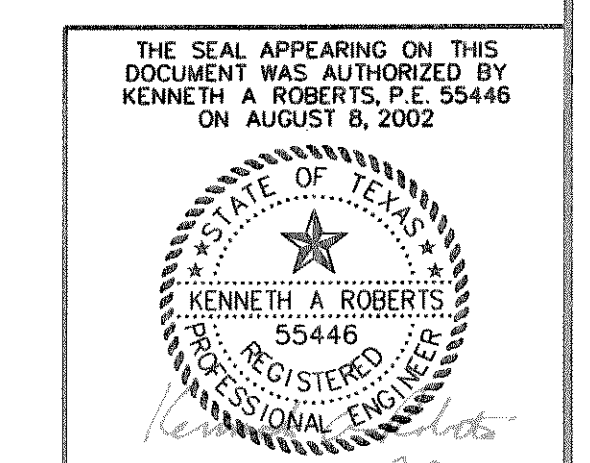

NO.	DATE	REVISIONS	APPROVED

STORMWATER PLAN & PROFILE
LINE "B" STA. 0+00 TO 3+75
RIDGE VIEW ADDITION REHAB

HUITT-ZOLLARS HUITT-ZOLLARS, INC. 831 McKinney Avenue, Suite 600 Dallas, Texas 75204-2489 Phone (214) 871-3311 Fax (214) 871-0757
CITY OF ROCKWALL, TEXAS

DESIGN	DRAWN	APPR.	SCALE	DATE	PROJECT NO.	NO.
HZI	HZI	KAR	H: 1"=20' V: 1"=5'	AUGUST 2002	01-3018-01	ST-8