
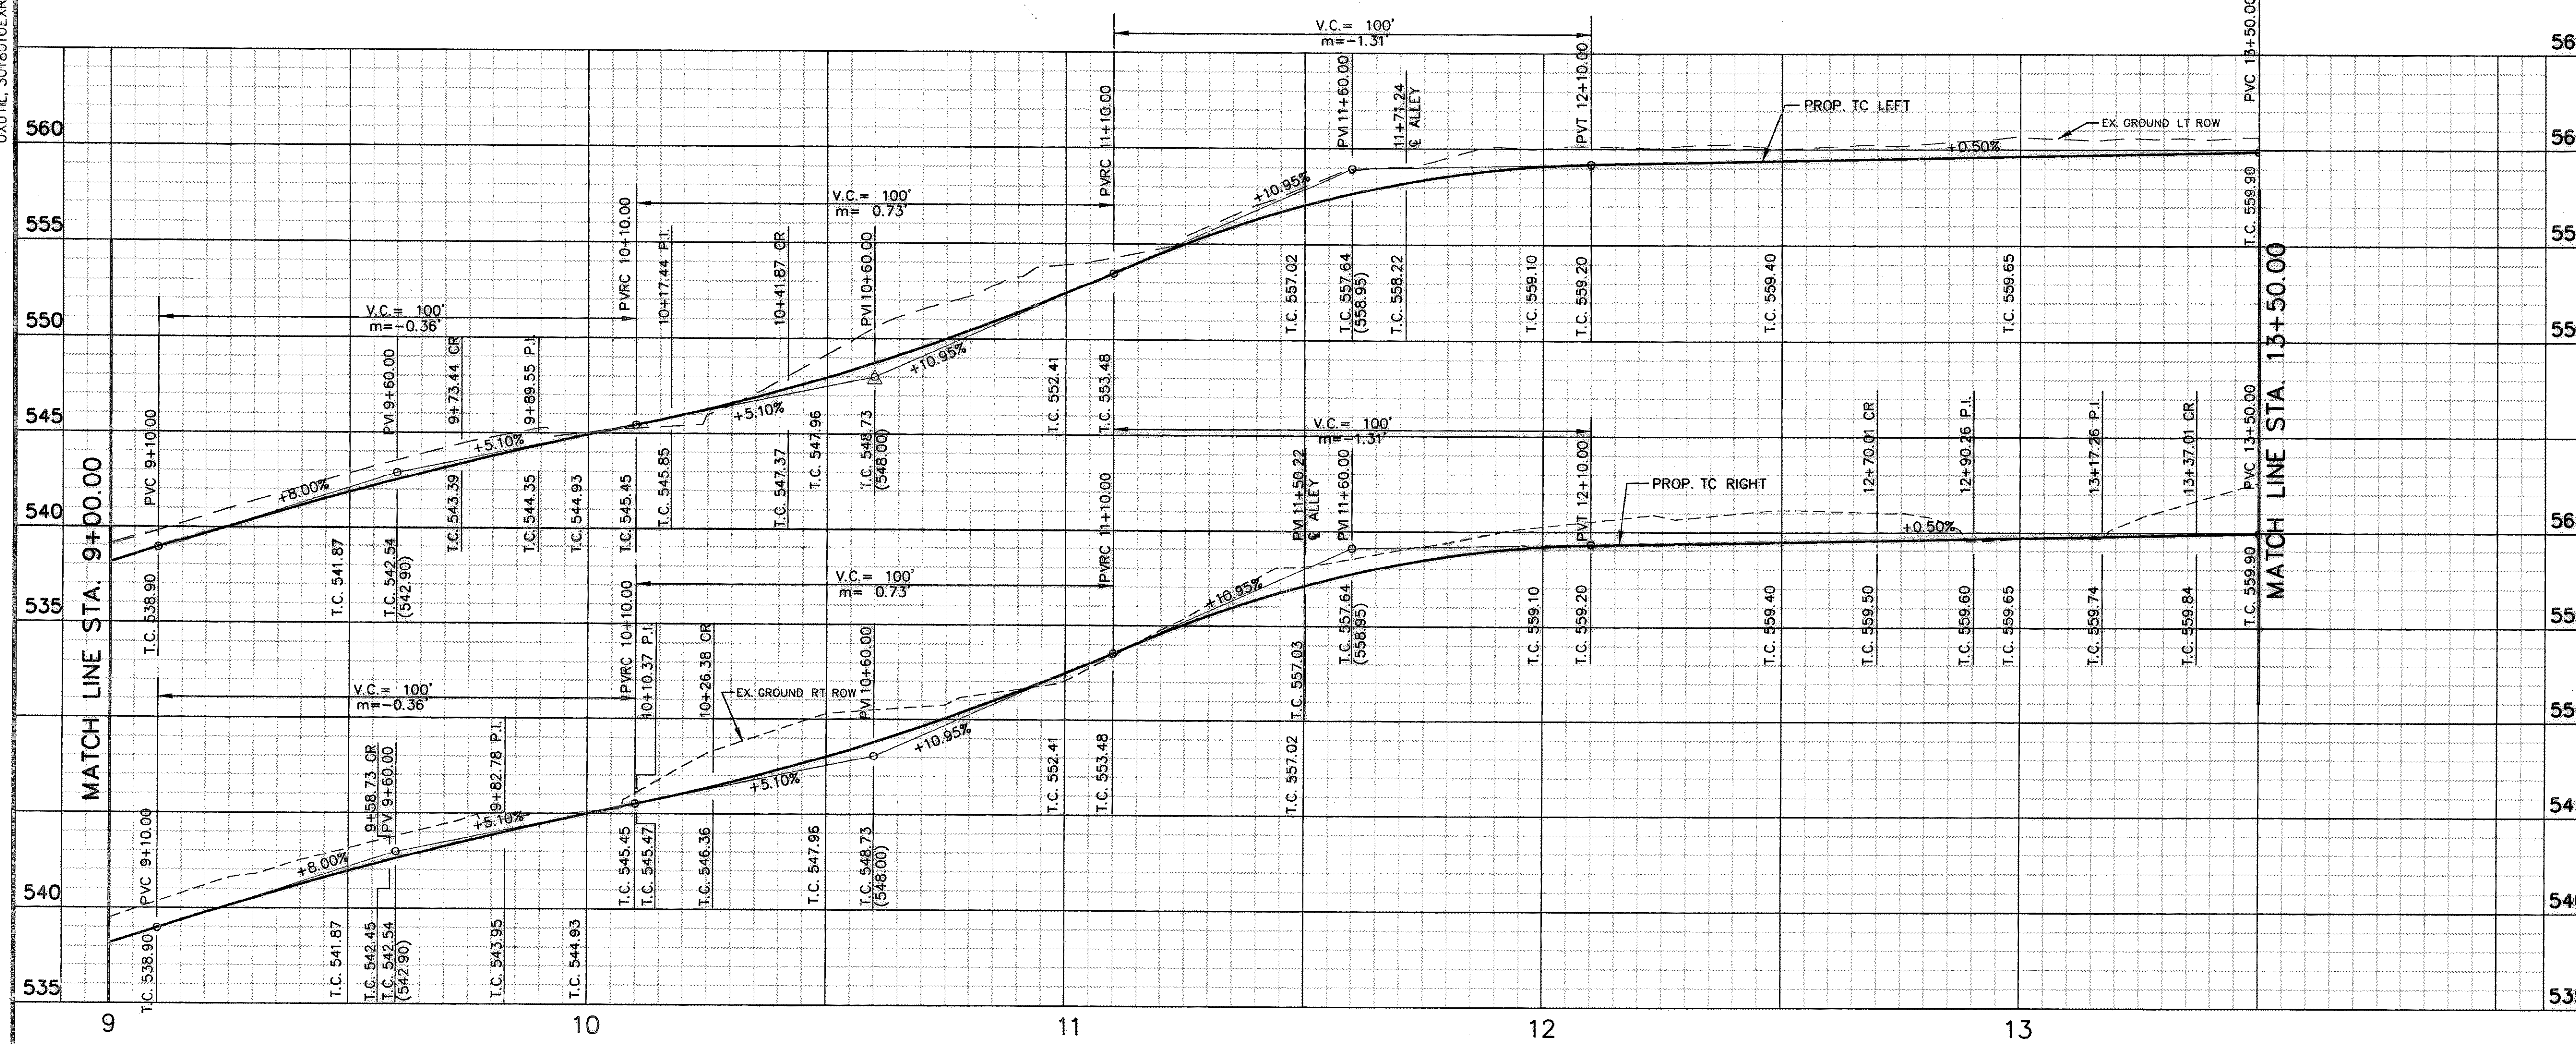


UWPLAN, 301801UWTR1.DGN, 17.18.20.21.48-54  
 USSPLAN, 301801USSRI.DGN, 17.18.20.21.35-38,40,41  
 CVALIGN, 301801CVART.DGN, 1.3.6.23.27-29,31,32  
 CVALIGN, 301801CVART.DGN, 1.4.6.23.27-29,31,32  
 USPLAN, 301801USORI.DGN, 17-21.23-31  
 \*no ref logical, \*no ref levels\*

BORDER, 301801BDR1.DGN, 1-4,7,11,12,21,30,31,37,38,40,41,45-48,50  
 VFIELD, 301801VFI.DGN, 11,14,20,24,26,28,43,50,56,57,60  
 CHALIGN, 301801CHART.DGN, 1-3  
 CSTPLAN, 301801CSTR1.DGN, 28,31,35,41,46,51,57  
 CROW, 301801CRWRI.DGN, 3,5,6  
 UAXTIL, 301801UAXRI.DGN, 36,37,55,56

KOR  
 SCALE=20.000000  
 PRT ROTATION=270.000000  
 F:\VIZ\FULL.TBL

H:\proj\01301801\dgn\301801CST02.DGN  
 DATE: 7/4/03  
 TIME: 17:14:58

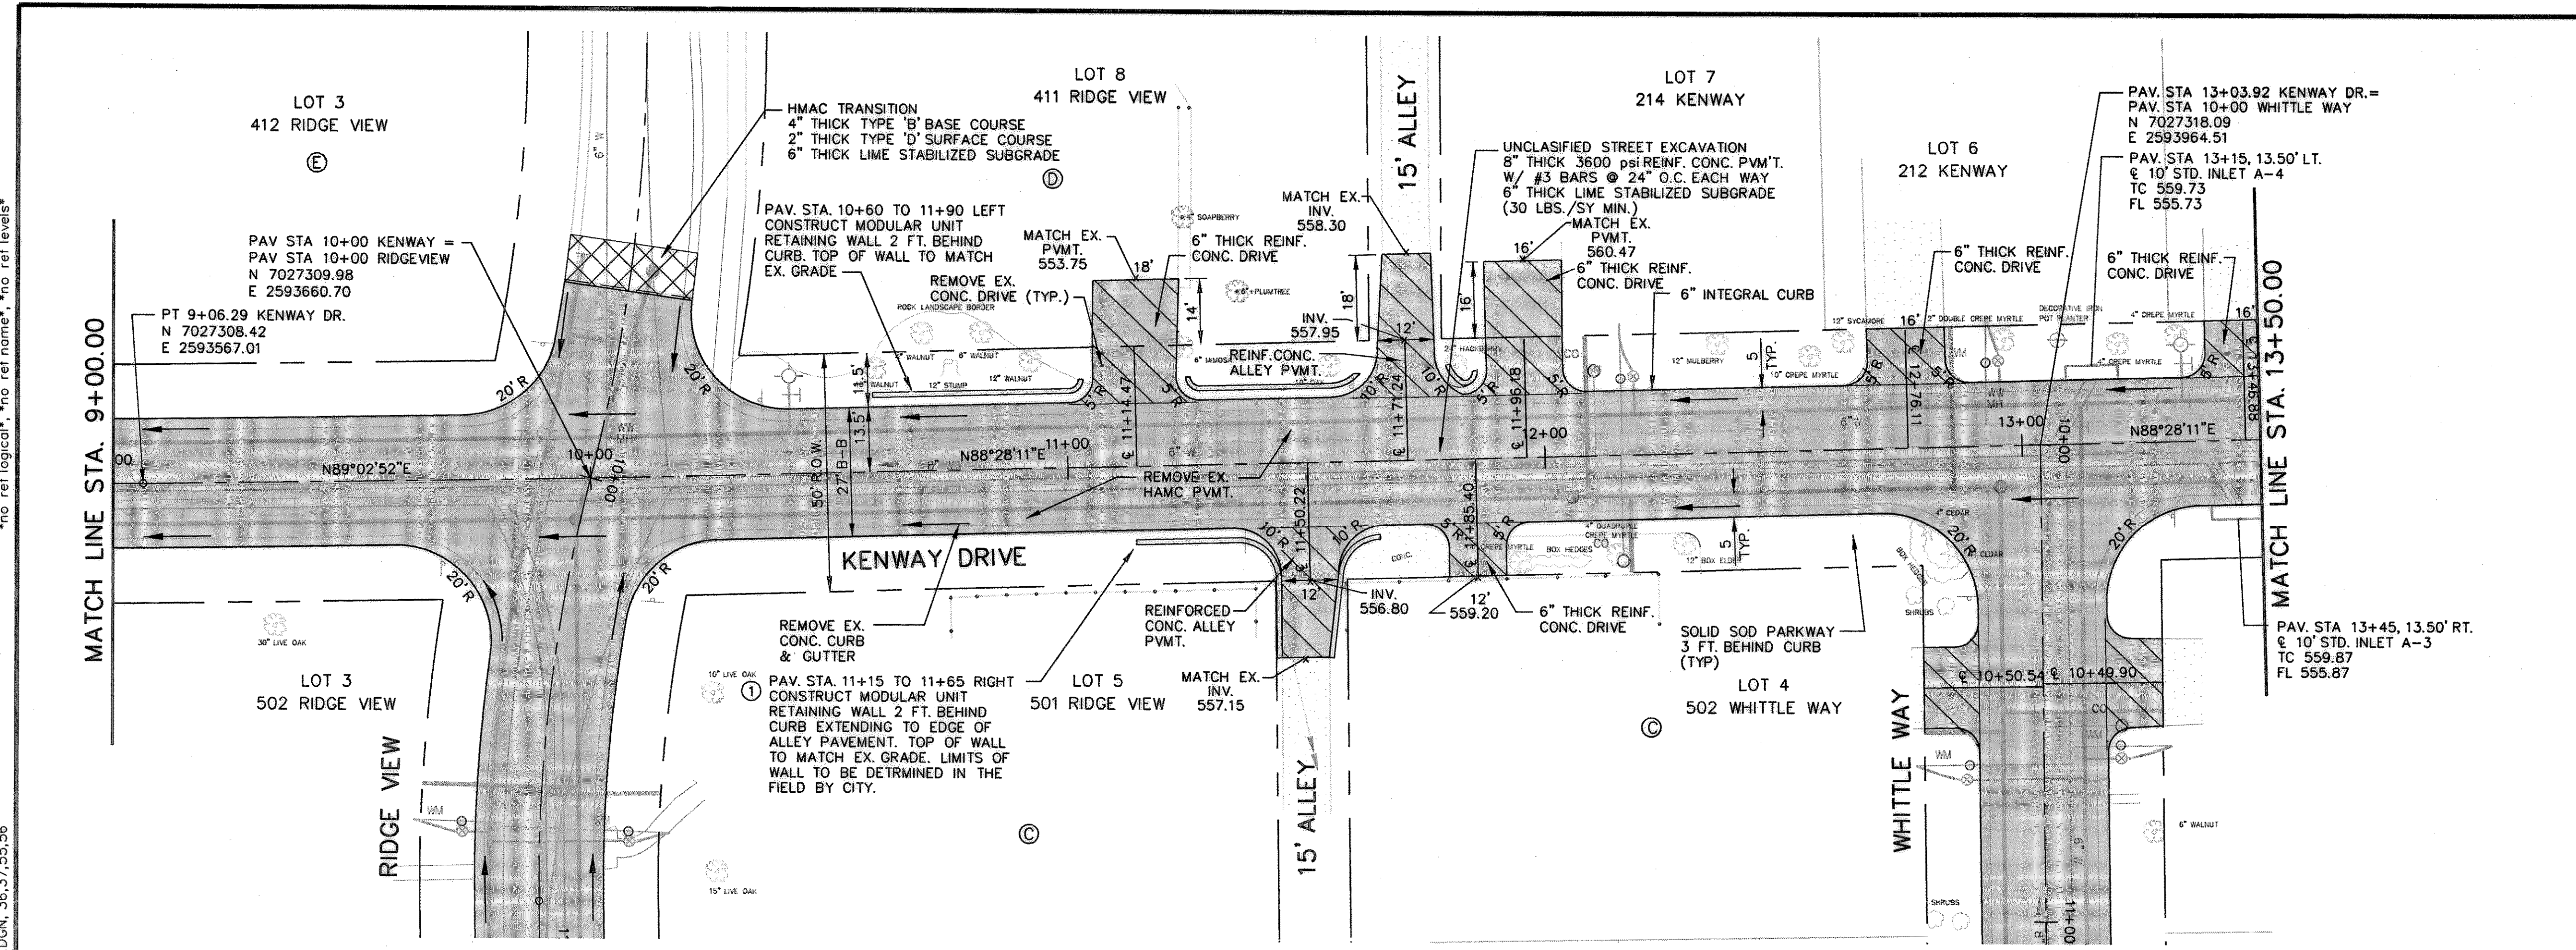

**LEGEND**

W	EXISTING WATER	— UGT —	EX. UNDERGROUND TELEPHONE
FH	FIRE HYDRANT	— OHE & T —	EX. OVERHEAD ELECTRIC & TELEPHONE
WM	METER		
T	WATER VALVE		
WW	EXISTING WASTEWATER		
WMH	WASTEWATER MANHOLE		
CO	CLEANOUT		
OHE	EX. OVERHEAD ELECTRIC		
PP	POWER POLE & GUY WIRE		
G	EXISTING GAS		
24"TRCP	EXISTING STORMWATER		
	PROPOSED STORMWATER		

**PAVING**

	REMOVE EXISTING CONCRETE PAVEMENT
	REMOVE EXISTING CONCRETE SIDEWALK
	PROPOSED CURB
	EXISTING R.O.W.
T.C. 569.05	PROPOSED TOP OF CURB
G. 569.05	PROPOSED GUTTER
PVMT 561.11	PROPOSED TOP OF PAVEMENT


**MISCELLANEOUS**

	EXISTING TREE OR SHRUB
--	------------------------

**BENCHMARKS:**

BM #1 "□" CUT ON BACK OF CURB NORTH SIDE OF SHORETRAIL DRIVE APPROXIMATELY 150 FT. WEST OF THE INTERSECTION OF SHORETRAIL DR. AND RIDGE VIEW, ALSO AT SOUTH SIDE BASE OF POWER POLE. ELEVATION = 550.33

BM #2 "□" CUT ON BACK OF CURB & OF A CURB INLET ON SOUTH SIDE OF LAKE MEADOWS DR. BETWEEN LAKE MEADOWS DR. BETWEEN LAKE MEADOWS CT. AND LAKE MEADOW CIRCLE IN FRONT OF HOUSE # 709. ELEVATION = 484.53

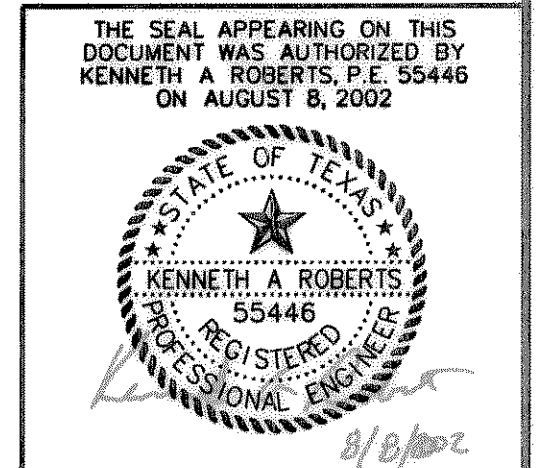

NO.	DATE	REVISIONS	APPROVED
1	4/03/03	ADD RET. WALL 11+15-11+65 RT.	<i>KAR</i>

**PAVING PLAN & PROFILE**  
**KENWAY DR. STA. 9+00 TO 13+50**  
**RIDGE VIEW ADDITION REHAB**

**HUITT-ZOLIARS** Huitt-Zoliars, Inc. Dallas  
 3838 McKinney Avenue, Suite 600 Dallas, Texas 75204-2489  
 Phone (214) 871-3311 Fax (214) 871-0757

**CITY OF ROCKWALL, TEXAS**

DESIGN	DRAWN	APPR.	SCALE	DATE	PROJECT NO.	NO.
HZI	HZI	KAR	Ht 1"=20' V: 1"=5'	AUGUST 2002	01-3018-01	P-3