
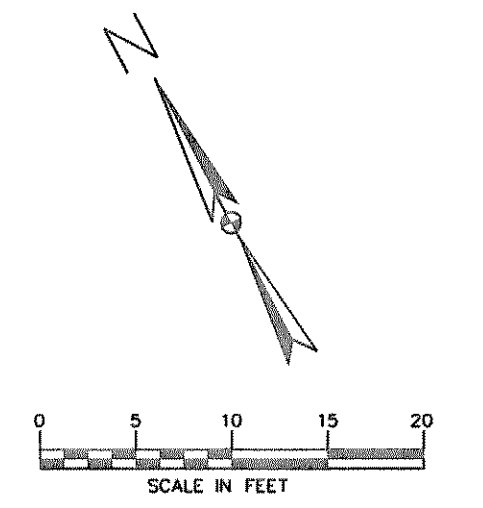


UWTPLAN1, 301801UWTR1.DGN, 17,18,20,21,48-54
 USSPLAN1, 301801USSR1.DGN, 17,18,20,21,35-38,40,41
 USDPAN1, 301801USDR1.DGN, 17-21,23-31
 no ref logical, *no ref name*, *no ref levels*
 no ref logical, *no ref name*, *no ref levels*
 no ref logical, *no ref name*, *no ref levels*

BORDER, 301801GBDR1.DGN, 1,3,4,7,21,26,30,31,40,41,45-48,50,61,63
 VFIELD1, 301801VFR1.DGN, 14,20,24,26,28,43,50,56,60
 CHALIGN1, 301801CHAR1.DGN, 1
 CSTPLAN1, 301801CSTR1.DGN, 35,46
 CROW1, 301801CRWR1.DGN, 3,6
 SKUXLTL1, 301801UEXR1.DGN, 25,26,36,37,55,56

therrasa
 SCALE=10.000000
 PRF ROTATION=-62.000000
 F:\tb\HZ\FULL.TBL

h:\proj\01301801\dgn\301801CST10.DGN
 DATE: 7/29/03
 TIME: 07:57:06

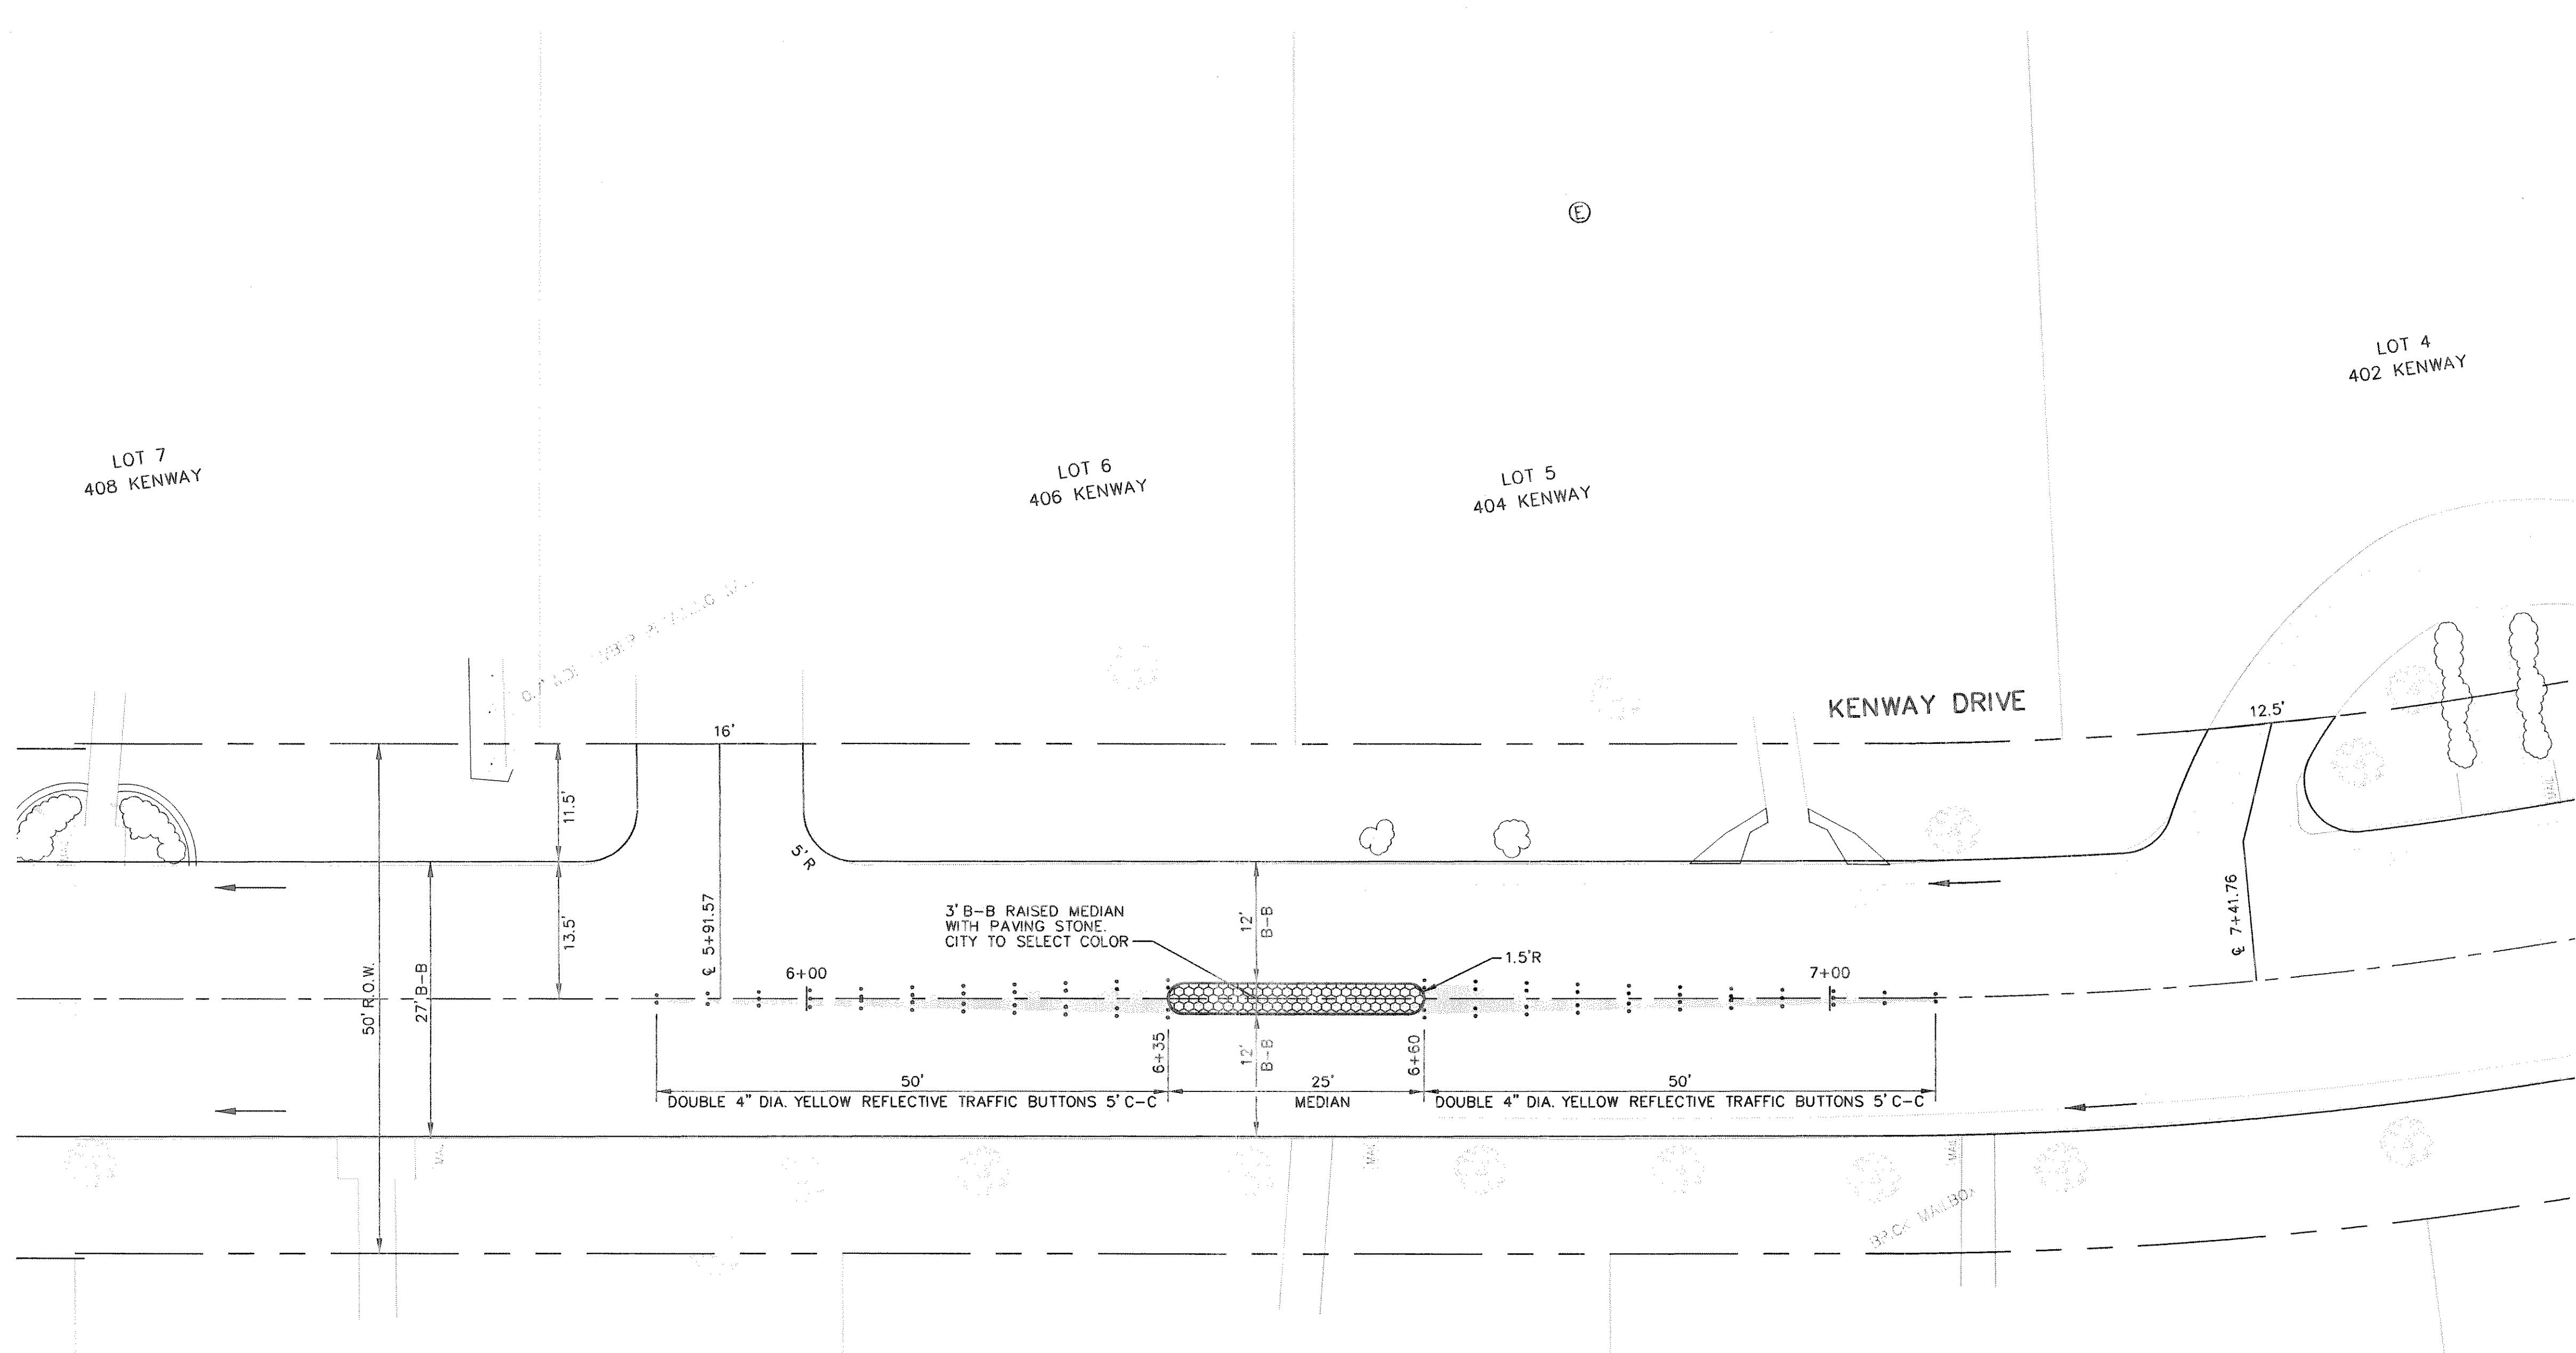


THIS WORK DELETED FROM THE CONTRACT

RECORD DRAWINGS JULY 25, 2003
 THIS RECORD DOCUMENT HAS BEEN PREPARED BASED ON INFORMATION PROVIDED BY OTHERS. THE CONSULTANT HAS NOT VERIFIED THE ACCURACY AND/OR COMPLETENESS OF THIS INFORMATION AND SHALL NOT BE RESPONSIBLE FOR ANY ERRORS OR OMISSIONS THAT MAY BE INCORPORATED AS A RESULT OF ERRONEOUS INFORMATION PROVIDED BY OTHERS.


LOT 7
407 KENWAY

LOT 6
405 KENWAY

LOT 5
403 KENWAY

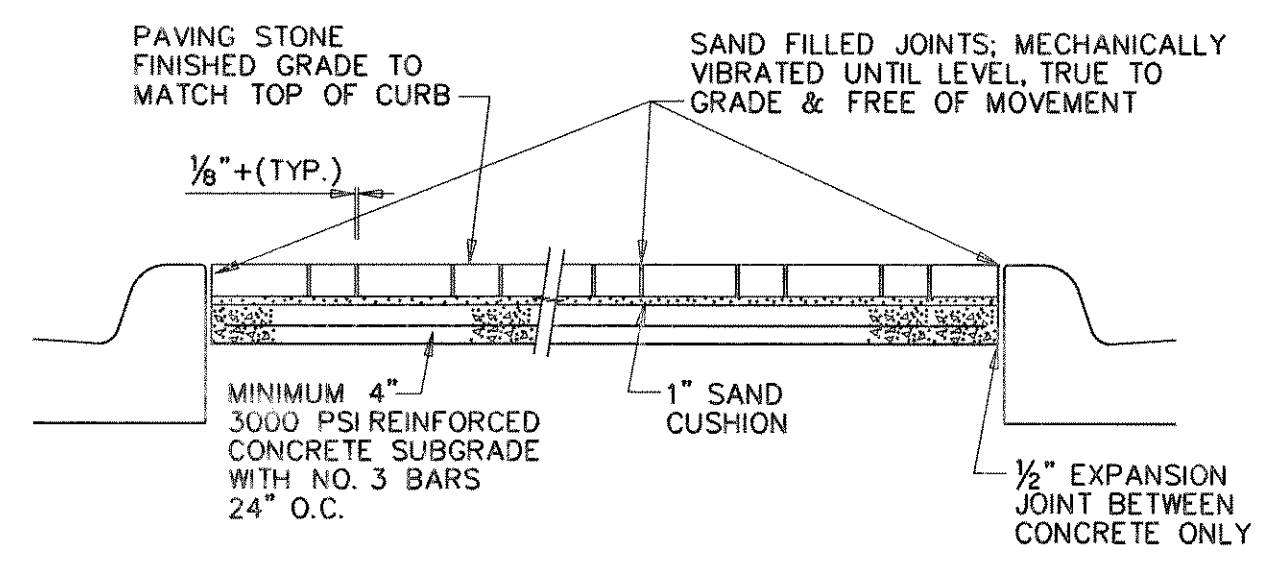

MEDIAN PAVING STONE DETAIL

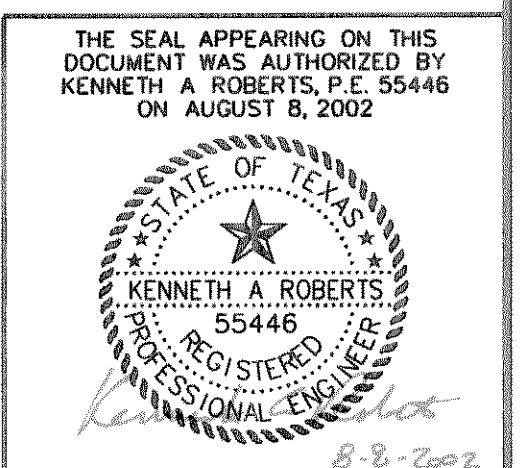

NO.	DATE	REVISIONS	APPROVED			
TRAFFIC CALMING DETAIL						
KENWAY DRIVE						
RIDGE VIEW ADDITION REHAB						
HUITT-ZOLLARS		<small>HUITT-ZOLLARS, Inc. 831 McKinney Avenue, Suite 600 Dallas, Texas 75204-2489 Phone (214) 871-3311 Fax (214) 871-0757</small>				
CITY OF ROCKWALL, TEXAS						
DESIGN	DRAWN	APPR.	SCALE	DATE	PROJECT NO.	NO.
HZI	HZI	KAR	1" = 10'	AUGUST 2002	01-3018-01	P-10