
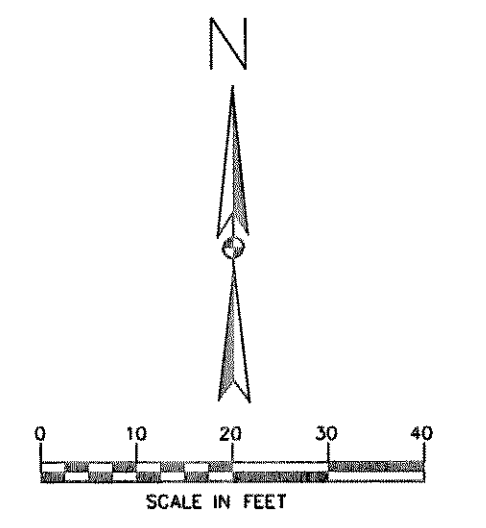


UWPLAN, 301801UWTR1.DGN, 17.18.20.21.48-54
 USSPLAN, 301801USSR1.DGN, 17.18.20.21.35-38.40.41
 CVALIGN, 301801CVAR1.DGN, 1-3.6.23.27-28.31.32
 CVALIGN, 301801CVAR1.DGN, 1-3.6.23.27-28.31.32
 USPLAN, 301801USDR1.DGN, 17-21.23-31
 no reflagged, *no ref name*, *no ref levels*

BORDER, 301801BDR1.DGN, 1-4.7.11.12.21.30.31.37.38.40.41.45-48.50
 VFIELD, 301801VFR1.DGN, 11.14.20.24.26.28.43.50.56.57.60
 CHALIGN, 301801CHART1.DGN, 1-3
 CSTPLAN, 301801CSTR1.DGN, 28.31.35.41.46.57
 CROW, 301801CRWR1.DGN, 3.6
 UXUTIL, 301801UEXRT1.DGN, 25.28.36.37.55.56


thresso
 SCALE=20.000000
 PRF ROTATION=270.000000
 F:\nb\142\FULL.TBL

h:\proj\01301801\dgn\301801CST06.DGN
 DATE: 7/29/03
 TIME: 07:56:01

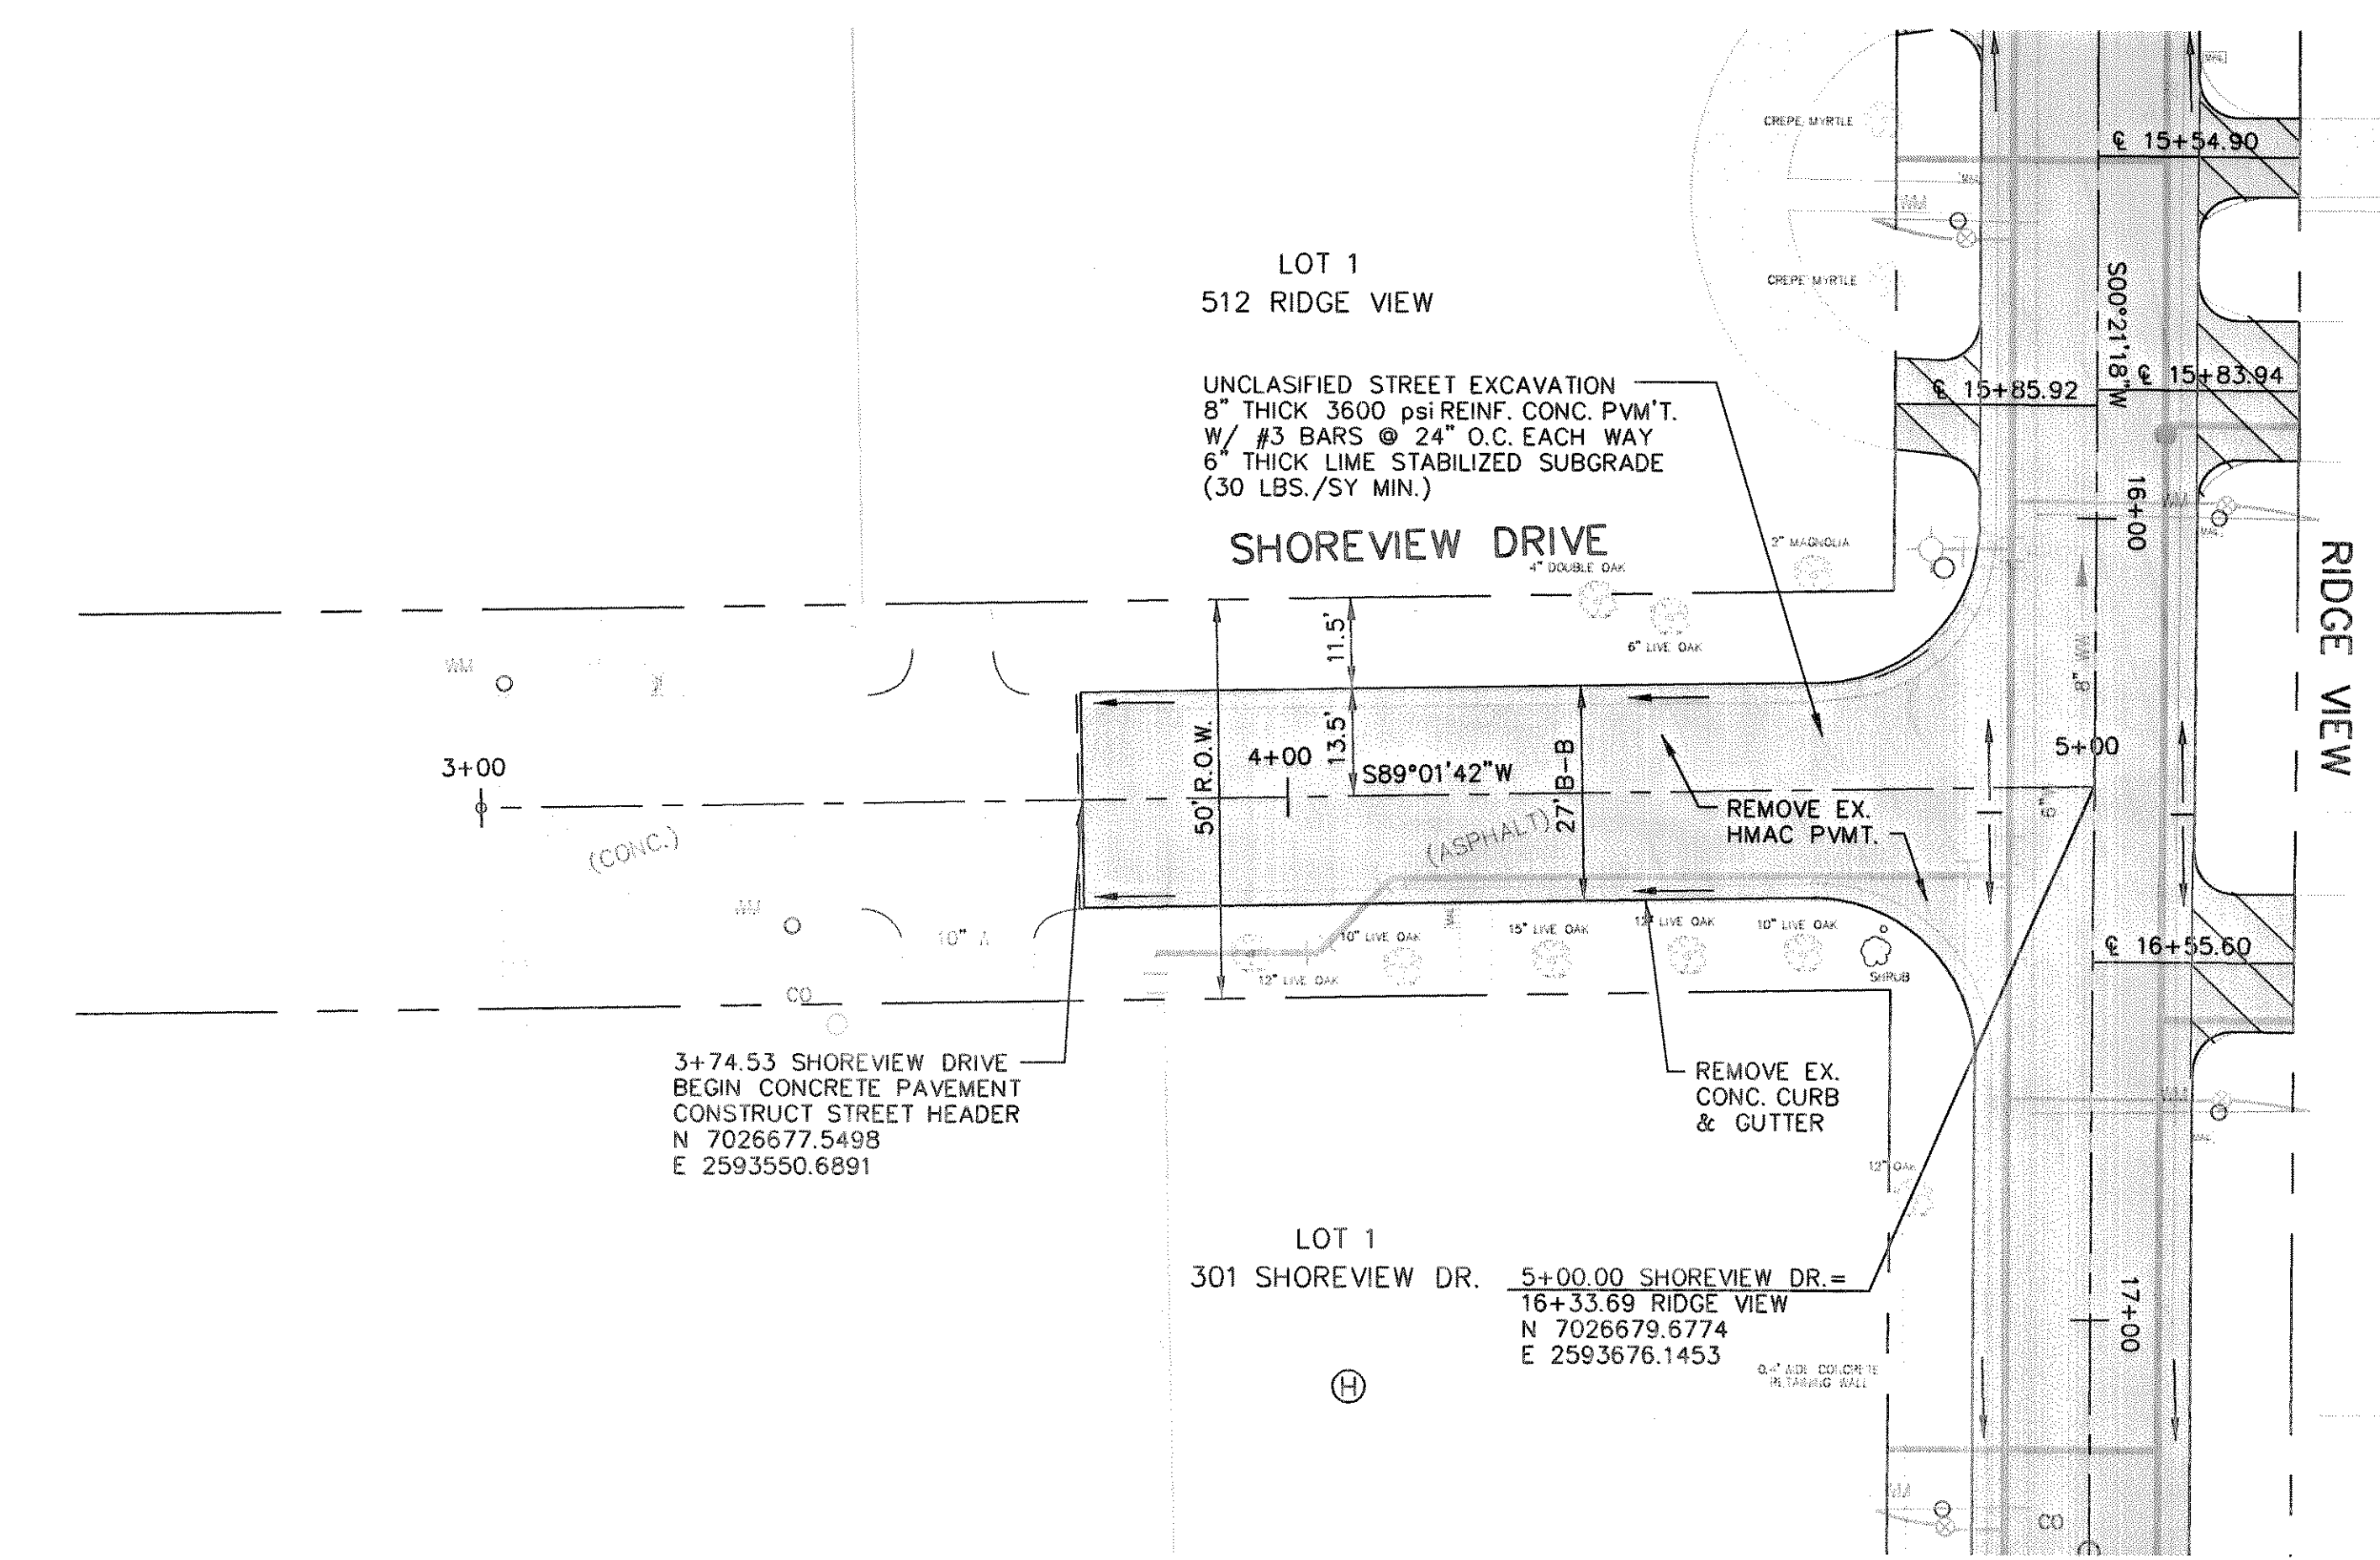

LEGEND

WATER	TELEPHONE
W EXISTING WATER	UGT EX UNDERGROUND TELEPHONE
FH FIRE HYDRANT	OHE&T EX OVERHEAD ELECTRIC & TELEPHONE
METER	
WV WATER VALVE	
WASTEWATER	PAVING
WV EXISTING WASTEWATER	REMOVE EXISTING CONCRETE PAVEMENT
WV MH WASTEWATER MANHOLE	REMOVE EXISTING CONCRETE SIDEWALK
CO CLEANOUT	PROPOSED CURB
	EXISTING R.O.W.
ELECTRIC	T.C. 569.05 PROPOSED TOP OF CURB
OHE EX OVERHEAD ELECTRIC	G. 569.05 PROPOSED GUTTER
PP POWER POLE & GUY WIRE	PVMT 561.11 PROPOSED TOP OF PAVEMENT
GAS	MISCELLANEOUS
G EXISTING GAS	EXISTING TREE OR SHRUB
STORMWATER	
EXISTING STORMWATER	
PROPOSED STORMWATER	

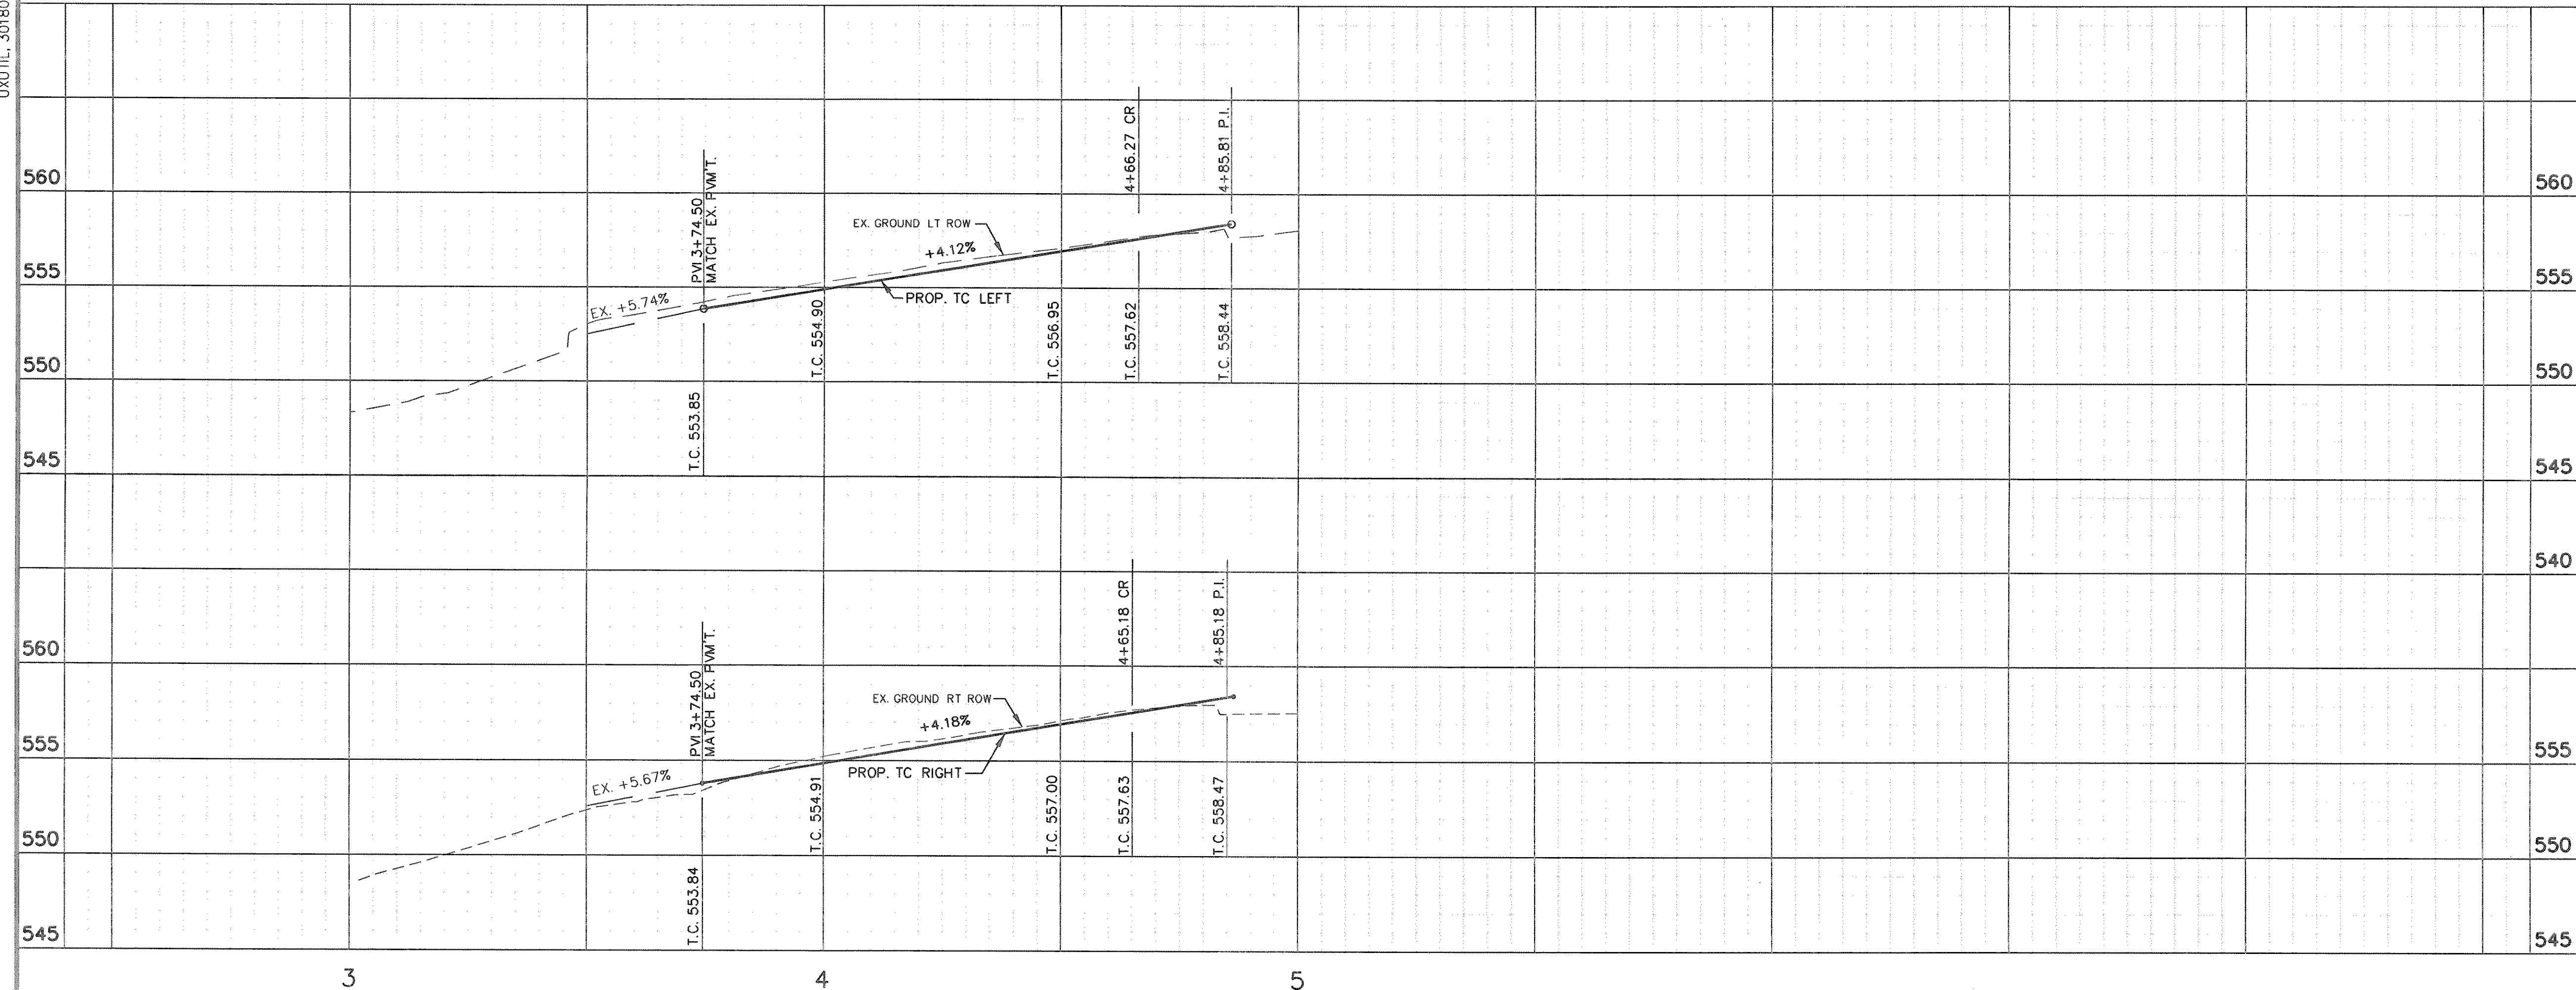


RECORD DRAWINGS JULY 25, 2003
 THIS RECORD DOCUMENT HAS BEEN PREPARED BASED ON INFORMATION PROVIDED BY OTHERS. THE CONSULTANT HAS NOT VERIFIED THE ACCURACY AND/OR COMPLETENESS OF THIS INFORMATION AND SHALL NOT BE RESPONSIBLE FOR ANY ERRORS OR OMISSIONS THAT MAY BE INCORPORATED AS A RESULT OF ERRONEOUS INFORMATION PROVIDED BY OTHERS.

BENCHMARKS:

BM #1 "C" CUT ON BACK OF CURB NORTH SIDE OF SHORETRAIL DRIVE APPROXIMATELY 150 FT WEST OF THE INTERSECTION OF SHORETRAIL DR. AND RIDGE VIEW, ALSO AT SOUTH SIDE BASE OF POWER POLE.
 ELEVATION = 550.33

BM #2 "C" CUT ON BACK OF CURB E OF A CURB INLET ON SOUTH SIDE OF LAKE MEADOWS DR. BETWEEN LAKE MEADOWS DR. BETWEEN LAKE MEADOWS CT. AND LAKE MEADOW CIRCLE IN FRONT OF HOUSE # 709.
 ELEVATION = 484.53

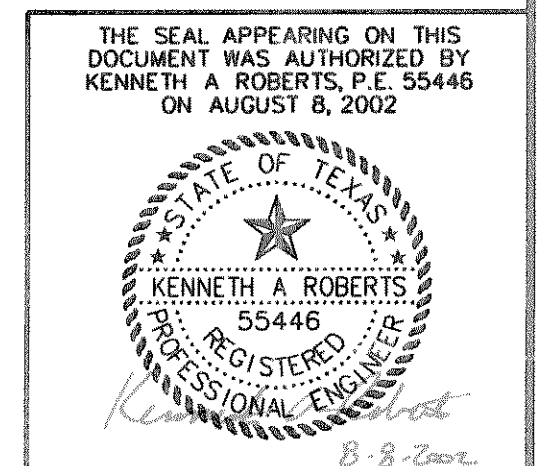

NO.	DATE	REVISIONS	APPROVED
PAVING PLAN & PROFILE			
SHOREVIEW DRIVE			
RIDGE VIEW ADDITION REHAB			
HUITT-ZOLIARS		Huitt-Zoliars, Inc. 381 McKinney Avenue, Suite 600 Dallas, Texas 75204-2489 Phone (214) 871-3811 Fax (214) 871-0757	
CITY OF ROCKWALL, TEXAS			
DESIGN	DRAWN	APPR.	SCALE
HZI	HZI	KAR	H1=20' V1=1=5'
DATE	PROJECT NO.	NO.	
AUGUST 2002	01-3018-01	P-8	