
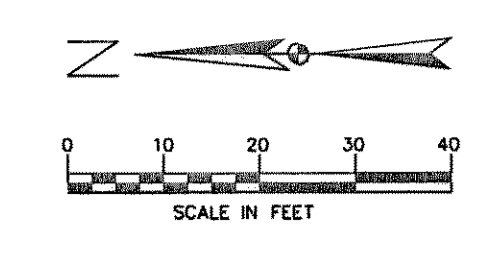


UWPLAN, 301801UWTR1.DGN, 17.18.20.21.48-54  
 USSPLAN, 301801USSR1.DGN, 17.18.20.21.35-38.40.41  
 CVALIGN, 301801CVARI.DGN, 3.6.23.27-29.31.32  
 CVALIGNR, 301801CVARI.DGN, 4.6.23.27-29.31.32  
 USPLAN, 301801USDR1.DGN, 17-21.23-31  
 \*No reflagged, \*no ref names, \*no relievers\*

BORDER, 301801GBDR1.DGN, 1-4.7.11.12.21.30.31.37.38.40.41.45-48.50  
 VFIELD, 301801VFR1.DGN, 11.14.20.24.26.28.43.50.56.57.60  
 CHALIGN, 301801CHART1.DGN, 1-3  
 CSTPLAN, 301801CSTR1.DGN, 28.31.35.41.46.57.58  
 CROW, 301801CRWR1.DGN, 3.5.6  
 UXUTL, 301801UXR1.DGN, 25.28.36.37.55.56

thresso  
 SCALE=20.000000  
 PRF ROTATION=0.000000  
 F:\N\14\Z\FULL.TBL


h:\proj\01301801\dgn\301801CST04.DGN  
 DATE: 7/29/03  
 TIME: 07:55:26

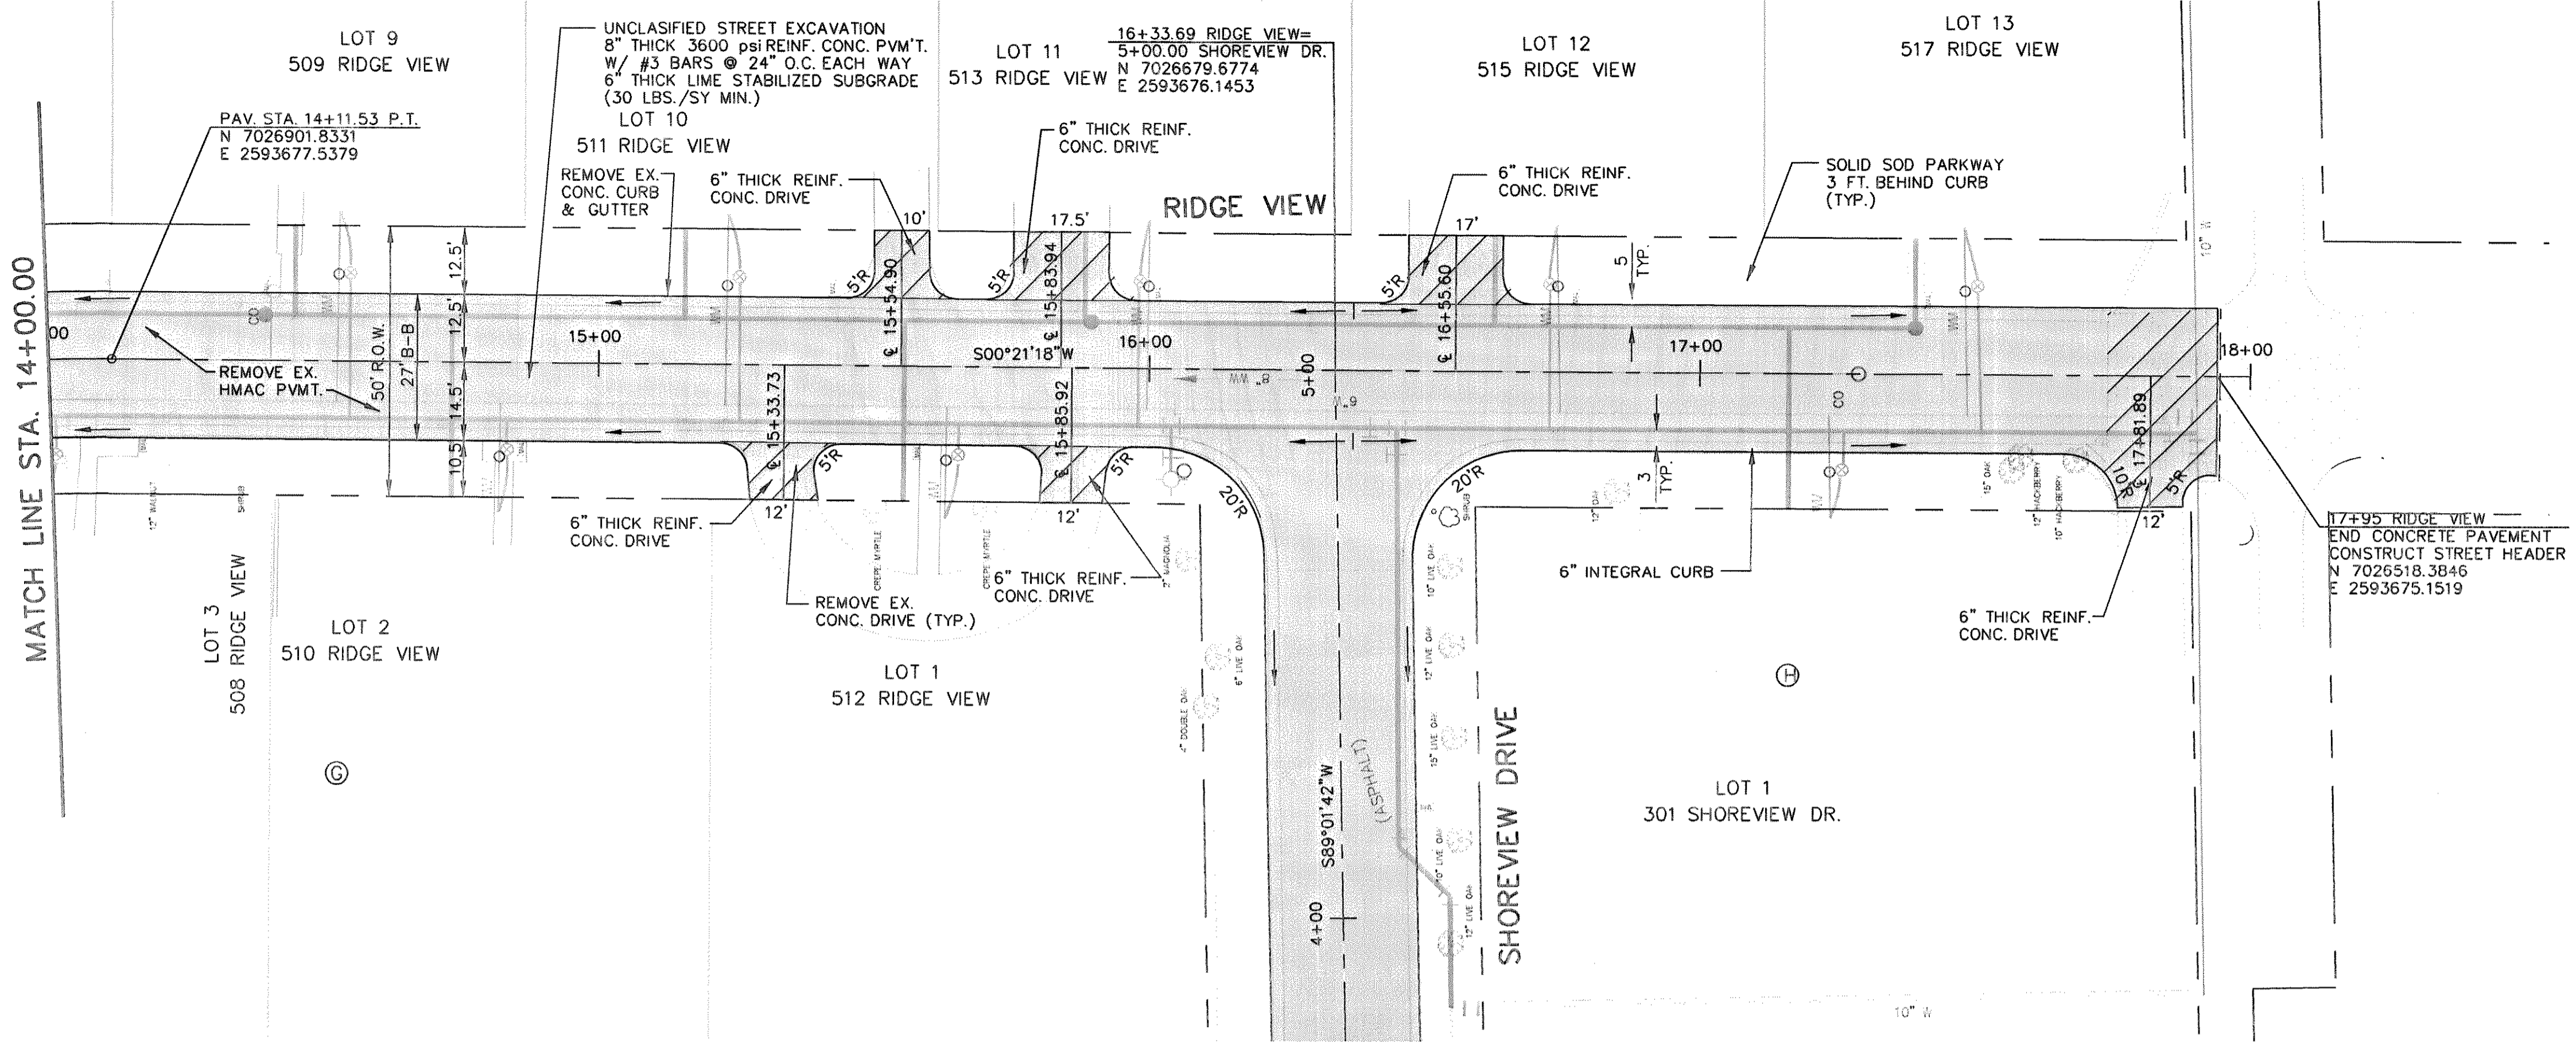

LEGEND	
<b>WATER</b>	<b>TELEPHONE</b>
W EXISTING WATER	— LGT — EX UNDERGROUND TELEPHONE
FO FIRE HYDRANT	— OHE & T — EX OVERHEAD ELECTRIC & TELEPHONE
WM METER	
T WATER VALVE	
<b>WASTEWATER</b>	<b>PAVING</b>
WW EXISTING WASTEWATER	REMOVE EXISTING CONCRETE PAVEMENT
WW MH WASTEWATER MANHOLE	REMOVE EXISTING CONCRETE SIDEWALK
CO CLEANOUT	PROPOSED CURB
	EXISTING R.O.W.
<b>ELECTRIC</b>	T.C. 569.05 PROPOSED TOP OF CURB
OHE EX OVERHEAD ELECTRIC	G. 569.05 PROPOSED GUTTER
PP POWER POLE & GUY WIRE	PVMT 561.11 PROPOSED TOP OF PAVEMENT
<b>GAS</b>	<b>MISCELLANEOUS</b>
G EXISTING GAS	EXISTING TREE OR SHRUB
24" PCP EXISTING STORMWATER	
PROPOSED STORMWATER	

RECORD DRAWINGS JULY 25, 2003  
 THIS RECORD DOCUMENT HAS BEEN PREPARED BASED ON INFORMATION PROVIDED BY OTHERS. THE CONSULTANT HAS NOT VERIFIED THE ACCURACY AND/OR COMPLETENESS OF THIS INFORMATION AND SHALL NOT BE RESPONSIBLE FOR ANY ERRORS OR OMISSIONS THAT MAY BE INCORPORATED AS A RESULT OF ERRONEOUS INFORMATION PROVIDED BY OTHERS.

**BENCHMARKS:**  
 BM #1 "□" CUT ON BACK OF CURB NORTH SIDE OF SHORETRAIL DRIVE APPROXIMATELY 150 FT WEST OF THE INTERSECTION OF SHORETRAIL DR. AND RIDGE VIEW, ALSO AT SOUTH SIDE BASE OF POWER POLE. ELEVATION = 550.33  
 BM #2 "□" CUT ON BACK OF CURB E OF A CURB INLET ON SOUTH SIDE OF LAKE MEADOWS DR. BETWEEN LAKE MEADOWS DR. BETWEEN LAKE MEADOWS CT. AND LAKE MEADOW CIRCLE IN FRONT OF HOUSE # 709. ELEVATION = 484.53

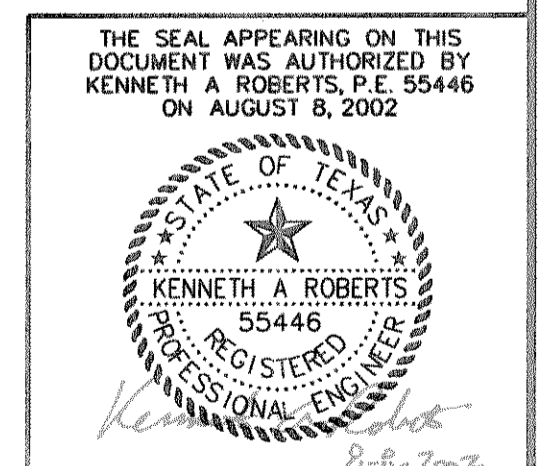

NO.	DATE	REVISIONS	APPROVED
<b>PAVING PLAN &amp; PROFILE</b>			
<b>RIDGE VIEW STA. 14+00 TO 18+00</b>			
<b>RIDGE VIEW ADDITION REHAB</b>			
<b>HUITT-ZOLIARS</b>			Huitt-Zoliars, Inc. 3931 McKinney Avenue, Suite 600 Dallas, Texas 75204-2489 Phone (214) 871-3311 Fax (214) 871-0757
<b>CITY OF ROCKWALL, TEXAS</b>			
DESIGN	DRAWN	APPR.	SCALE
HZI	HZI	KAR	H:V=20':1'=5'
DATE	PROJECT NO.	NO.	
AUGUST 2002	01-3018-01	P-6	

