
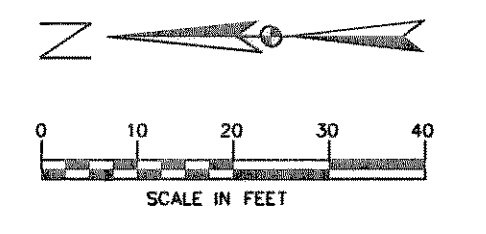


UWPLAN, 301801UWTR1.DGN, 17.18.20.21.48-54
 USSPLAN, 301801USSR1.DGN, 17.18.20.21.35-38,40,41
 CVALIGN, 301801CVARI.DGN, 3.6.23.27-29,31,32
 CVALIGNR, 301801CVARI.DGN, 4.6.23.27-29,31,32
 USPLAN, 301801USDR1.DGN, 17-21,23-31
 no reflocat, *no ref name*, *no ref levels*

BORDER, 301801GBDR1.DGN, 1-4,7,11,12,21,30,31,37,38,40,41,45-48,50
 VFIELD, 301801VFR1.DGN, 11,14,20,24,26,28,43,50,56,57,60
 CHALIGN, 301801CHARI.DGN, 1-3
 CSTPLAN, 301801CSTR1.DGN, 20,28,31,35,41,46,57,58
 CROW, 301801CRWR1.DGN, 3,5,6
 UXUTIL, 301801UXE1.DGN, 25,28,36,37,55,56

theresso
 SCALE=20.000000
 PRF ROTATION=0.000000
 F:\hzi\HZFULL.TBL


h:\proj\01301801\dgn\301801CS107.DGN
 DATE: 7/29/03
 TIME: 07:56:27

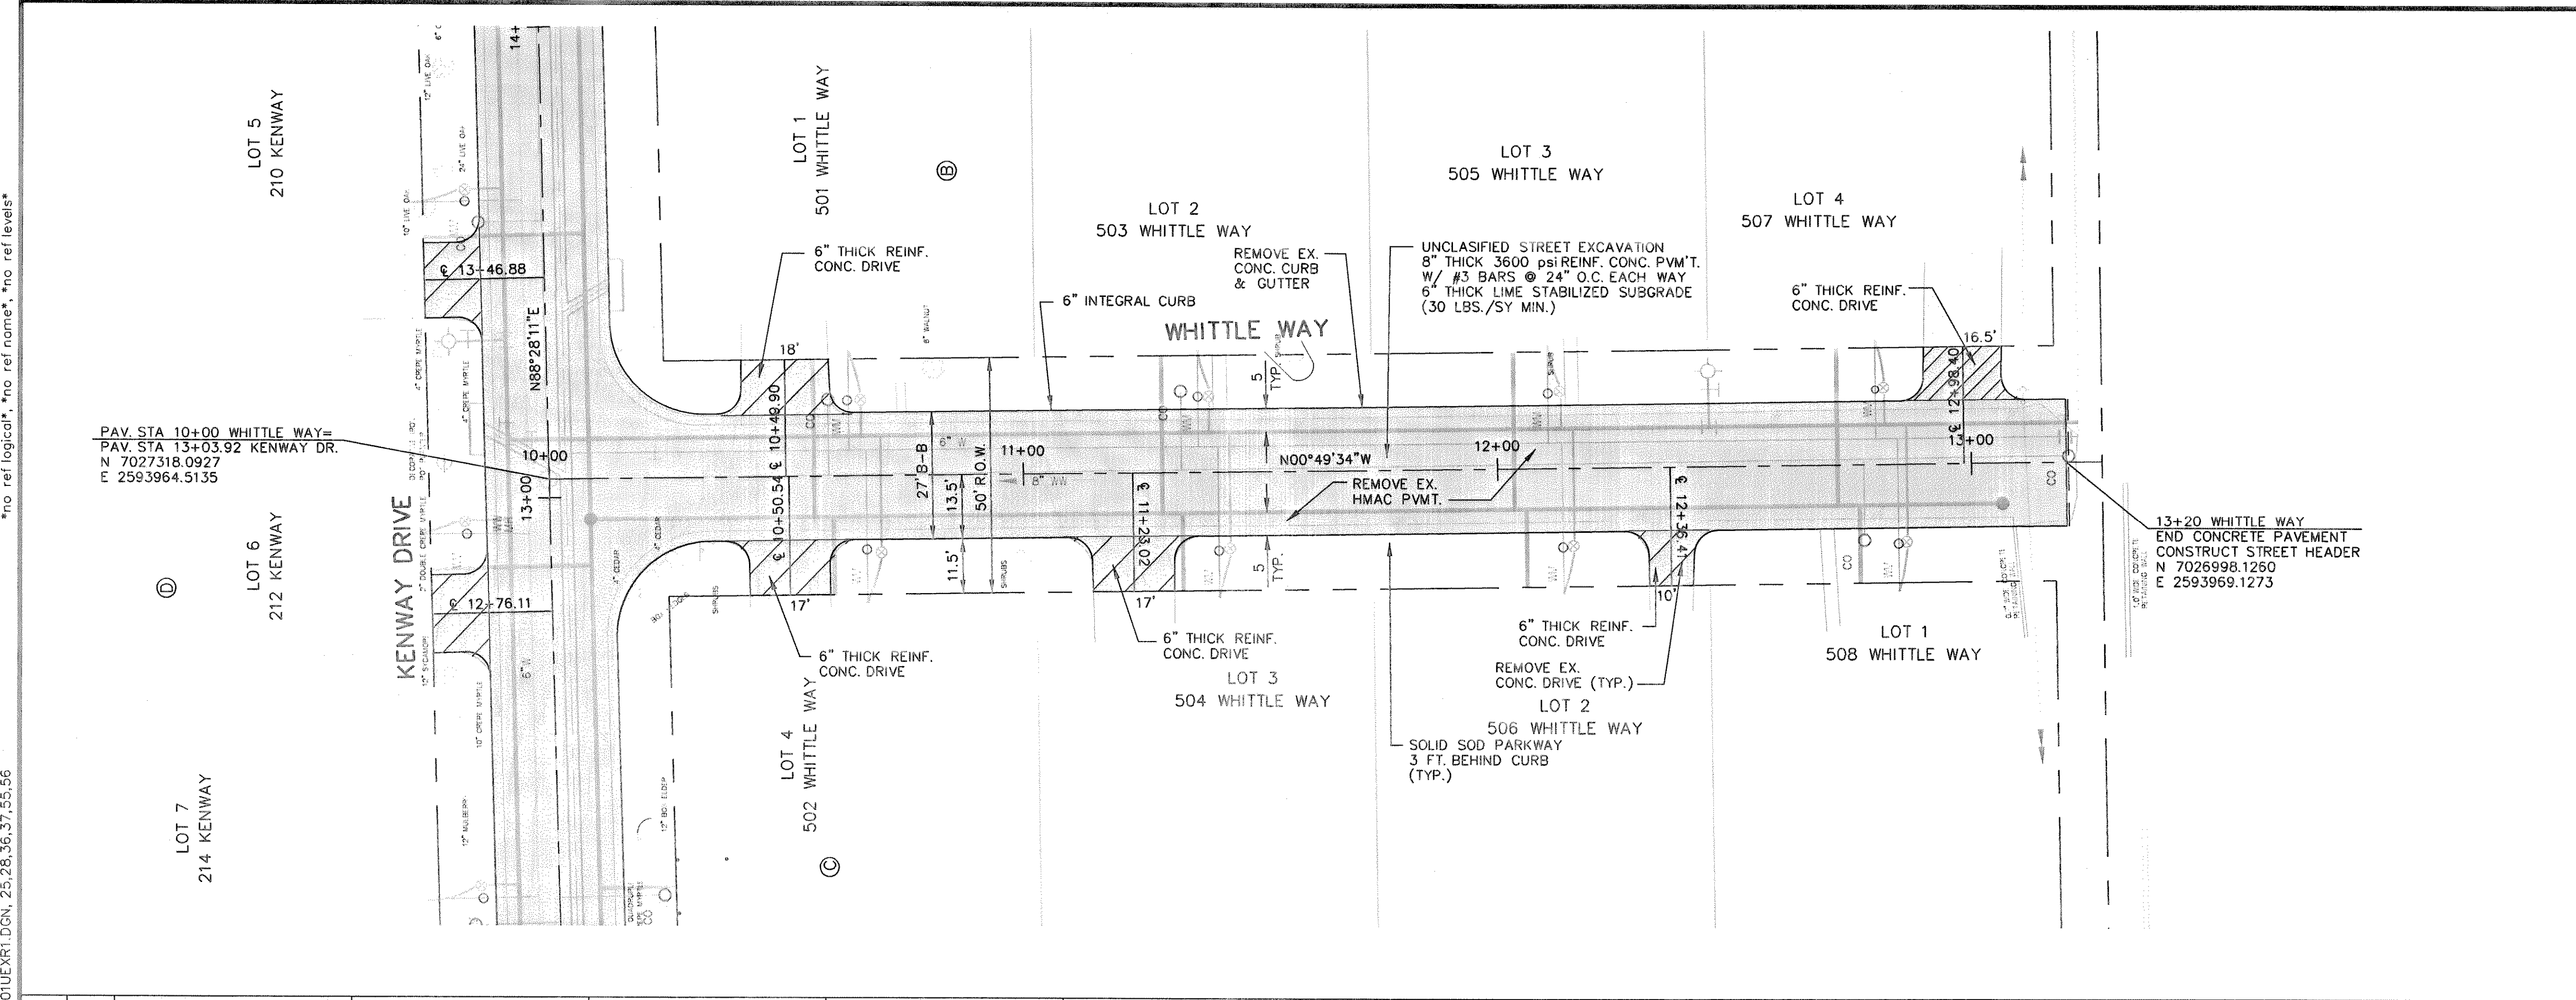

LEGEND				
W	EXISTING WATER	TELEPHONE		
HO	FIRE HYDRANT	UGT	EX UNDERGROUND TELEPHONE	
WO	METER	OHE&T	EX OVERHEAD ELECTRIC & TELEPHONE	
T	WATER VALVE	PAVING		
WW	EXISTING WASTEWATER	[Hatched Box]	REMOVE EXISTING CONCRETE PAVEMENT	
CO	WASTEWATER MANHOLE CLEANOUT	[Hatched Box]	REMOVE EXISTING CONCRETE SIDEWALK	
OHE	EX OVERHEAD ELECTRIC	[Dashed Line]	PROPOSED CURB	
PP	POWER POLE & GUY WIRE	[Dashed Line]	EXISTING R.O.W.	
G	EXISTING GAS	[Dashed Line]	T.C. 569.05	PROPOSED TOP OF CURB
STW	EXISTING STORMWATER	[Dashed Line]	G. 569.05	PROPOSED GUTTER
STW	PROPOSED STORMWATER	[Dashed Line]	PVMT 561.11	PROPOSED TOP OF PAVEMENT
		[Circle]	MISCELLANEOUS	
		[Circle]	EXISTING TREE OR SHRUB	

RECORD DRAWINGS JULY 25, 2003
 THIS RECORD DOCUMENT HAS BEEN PREPARED BASED ON INFORMATION PROVIDED BY OTHERS. THE CONSULTANT HAS NOT VERIFIED THE ACCURACY AND/OR COMPLETENESS OF THIS INFORMATION AND SHALL NOT BE RESPONSIBLE FOR ANY ERRORS OR OMISSIONS THAT MAY BE INCORPORATED AS A RESULT OF ERRONEOUS INFORMATION PROVIDED BY OTHERS.

BENCHMARKS:
 BM #1 "□" CUT ON BACK OF CURB NORTH SIDE OF SHORETRAIL DRIVE APPROXIMATELY 150 FT. WEST OF THE INTERSECTION OF SHORETRAIL DR. AND RIDGE VIEW, ALSO AT SOUTH SIDE BASE OF POWER POLE.
 ELEVATION = 550.33
 BM #2 "□" CUT ON BACK OF CURB & OF A CURB INLET ON SOUTH SIDE OF LAKE MEADOWS DR. BETWEEN LAKE MEADOWS DR. BETWEEN LAKE MEADOWS CT. AND LAKE MEADOW CIRCLE IN FRONT OF HOUSE # 709.
 ELEVATION = 484.53

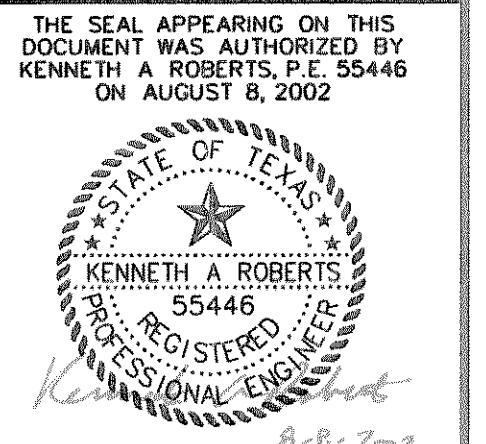

NO.	DATE	REVISIONS	APPROVED			
PAVING PLAN & PROFILE						
WHITTLE WAY						
RIDGE VIEW ADDITION REHAB						
HUITT-ZOLLARS						
CITY OF ROCKWALL, TEXAS						
DESIGN	DRAWN	APPR.	SCALE	DATE	PROJECT NO.	NO.
HZI	HZI	KAR	H1=20' V1=5'	AUGUST 2002	01-3018-01	P-9

