


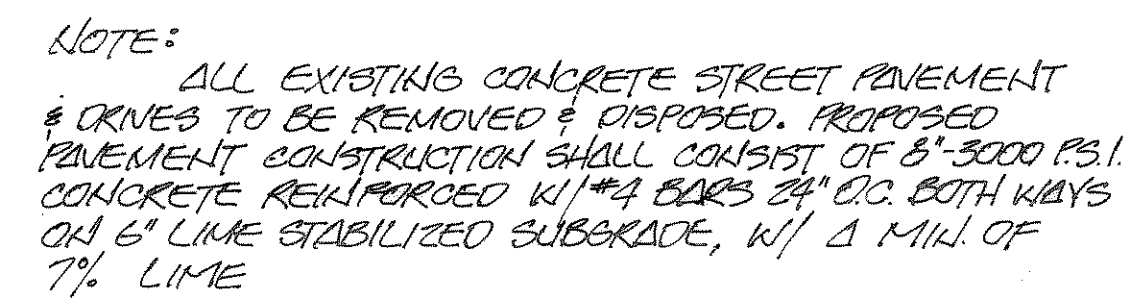



NOTE: PROPOSED PAVEMENT TO BE CONSTRUCTED IN THE SAME LOCATION AS EXISTING PAVEMENT

NOTE: ALL UNDERGROUND UTILITIES TO BE RELOCATED OR ADJUSTED TO NEW PAVEMENT OR PARKWAY GRADE PRIOR TO ANY PAVEMENT CONSTRUCTION

NOTE:
POWER POLES & TELEPHONE BOXES
TO BE RELOCATED BY OTHERS PRIOR TO
CONSTRUCTION

NOTE:
ALL CONSTRUCTION SHALL MEET
CITY OF ROCKWALL SPECIFICATIONS

NOTE:
CONTRACTOR SHALL HAVE ONE
LANE REMAINED OPEN FOR TRAFFIC
AT ALL TIMES

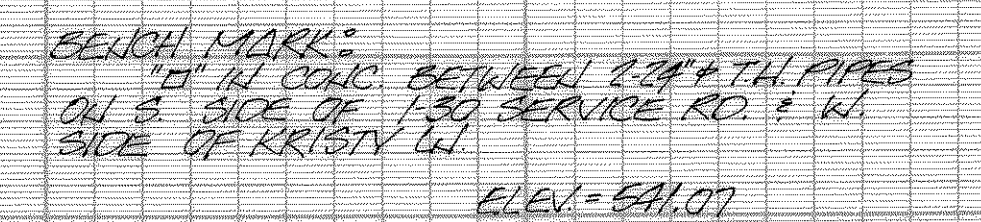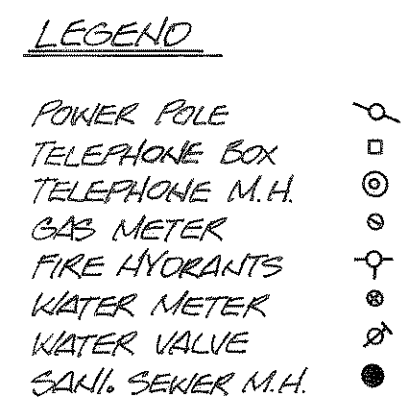

SCALE: $1'' = 20' H.$
 $1'' = 6' V.$

REVISION NO.	REMARKS	DATE
PAVING IMPROVEMENTS KRISTY LANE		
CITY OF ROCKWALL, TEXAS 205 W. RUSK STREET 214-722-1111		
DESIGNED:	SCALE:	
W.L.D.	NOTE	
DRAWN:	APPROVED:	
W.L.D.	<i>W. L. Douphrate II</i>	
JOB NO.	DATE:	SHEET NO.
87006	3-87	52