

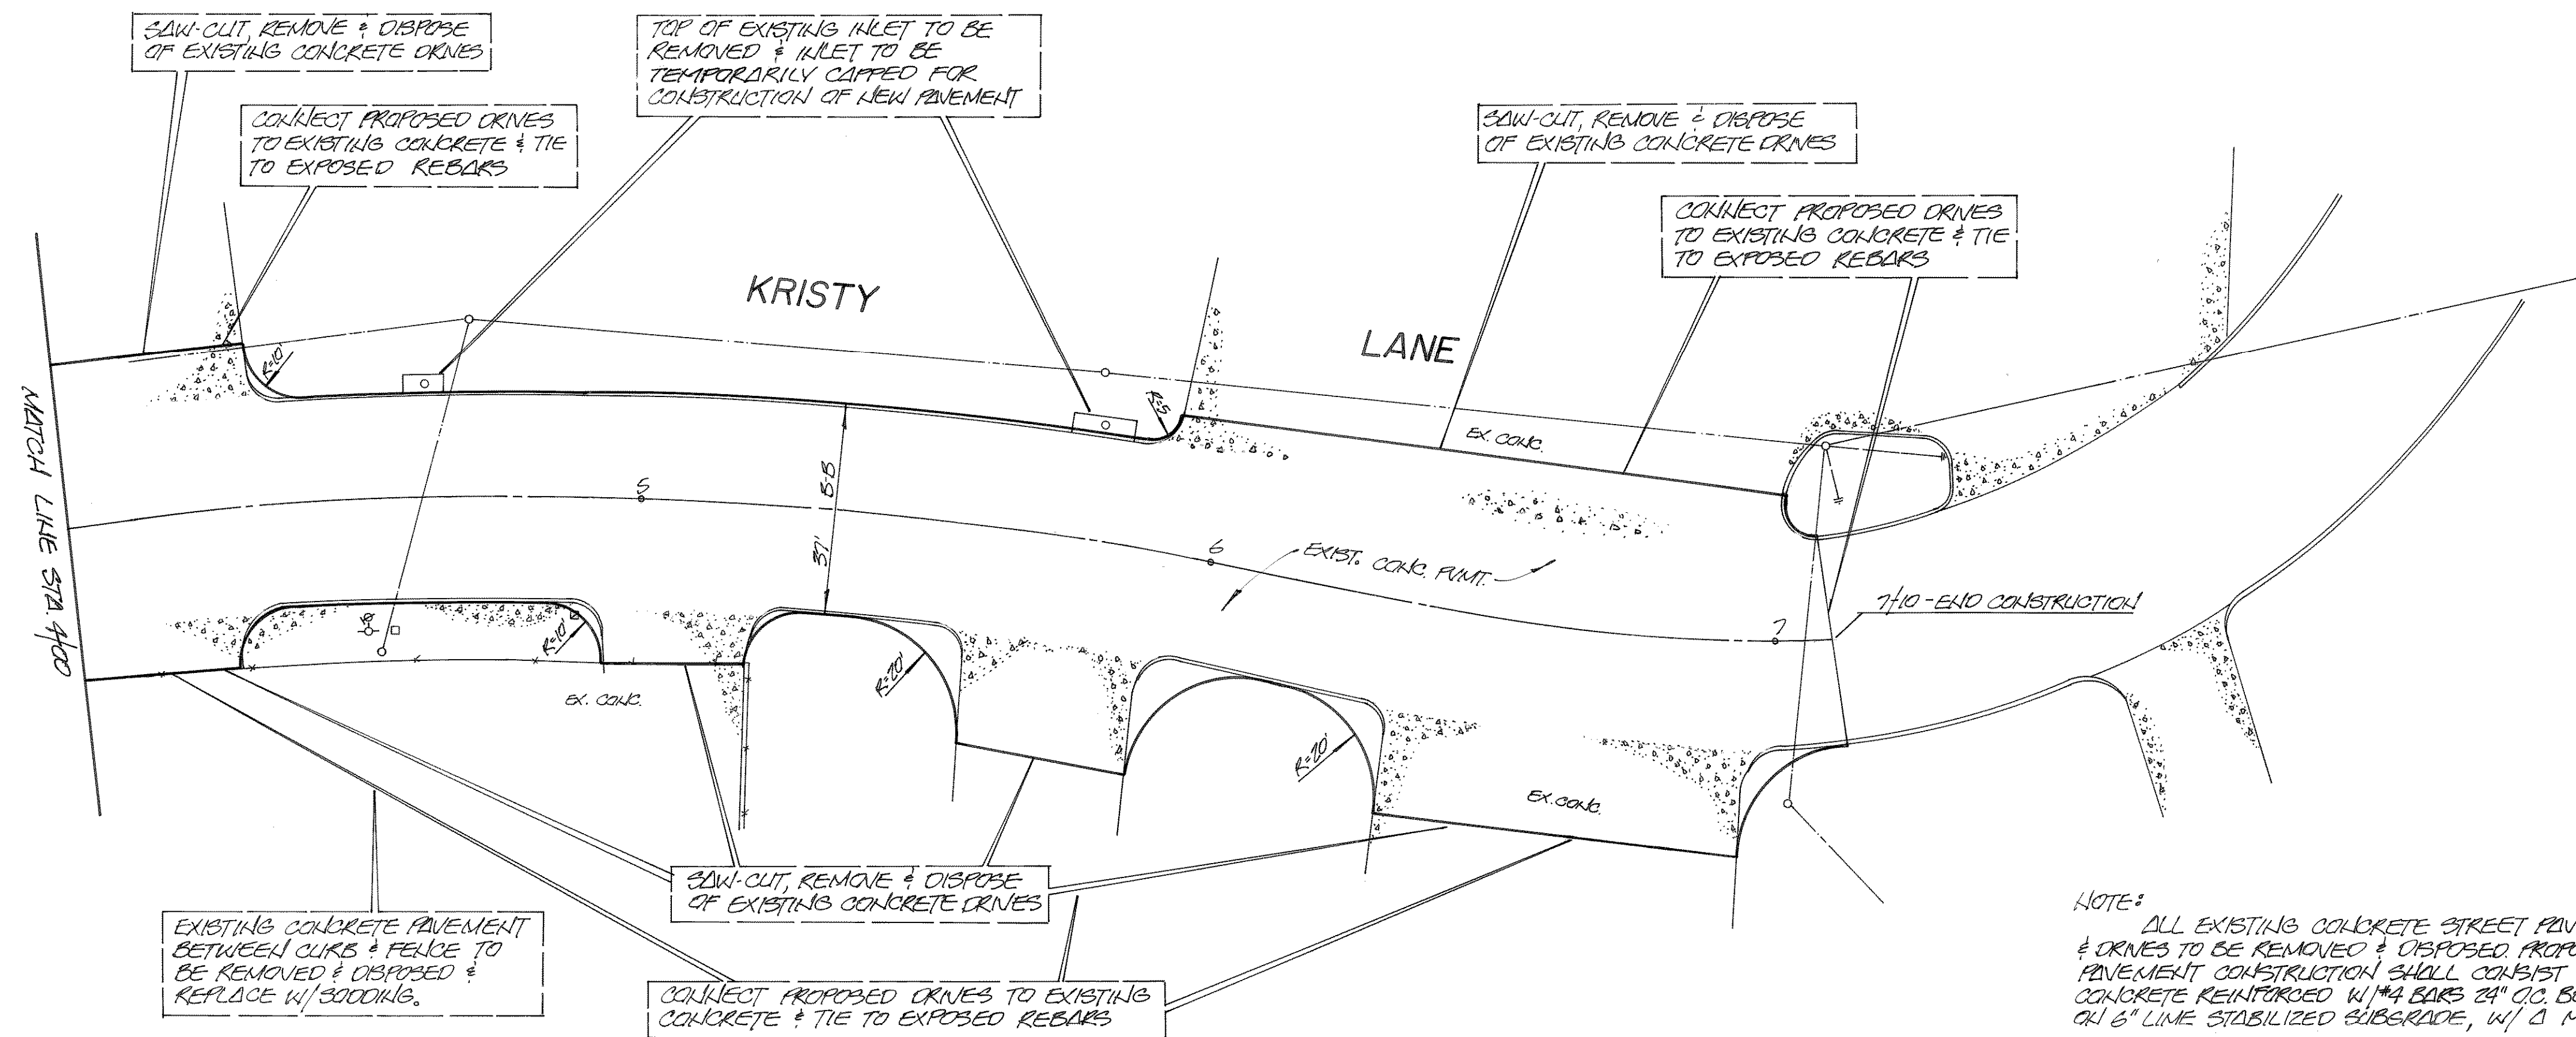


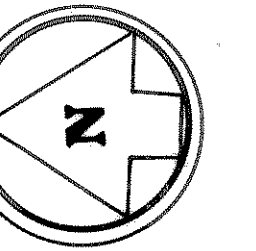

- LEGEND
- POWER POLE
 - TELEPHONE BOX
 - TELEPHONE M.H.
 - GAS METER
 - FIRE HYDRANTS
 - WATER METER
 - WATER VALVE
 - SANIT. SEWER M.H.

NOTE: ALL EXISTING CONCRETE STREET PAVEMENT & CRACKS TO BE REMOVED & DISPOSED. PROPOSED PAVEMENT CONSTRUCTION SHALL CONSIST OF 8" 3000 P.S.I. CONCRETE REINFORCED W/4 BARS 24" O.C. BOTH WAYS. ON 6" LINE STABILIZED SUBGRADE, W/ 2 MIN. OF 7% LIME.

NO ALTERNATE

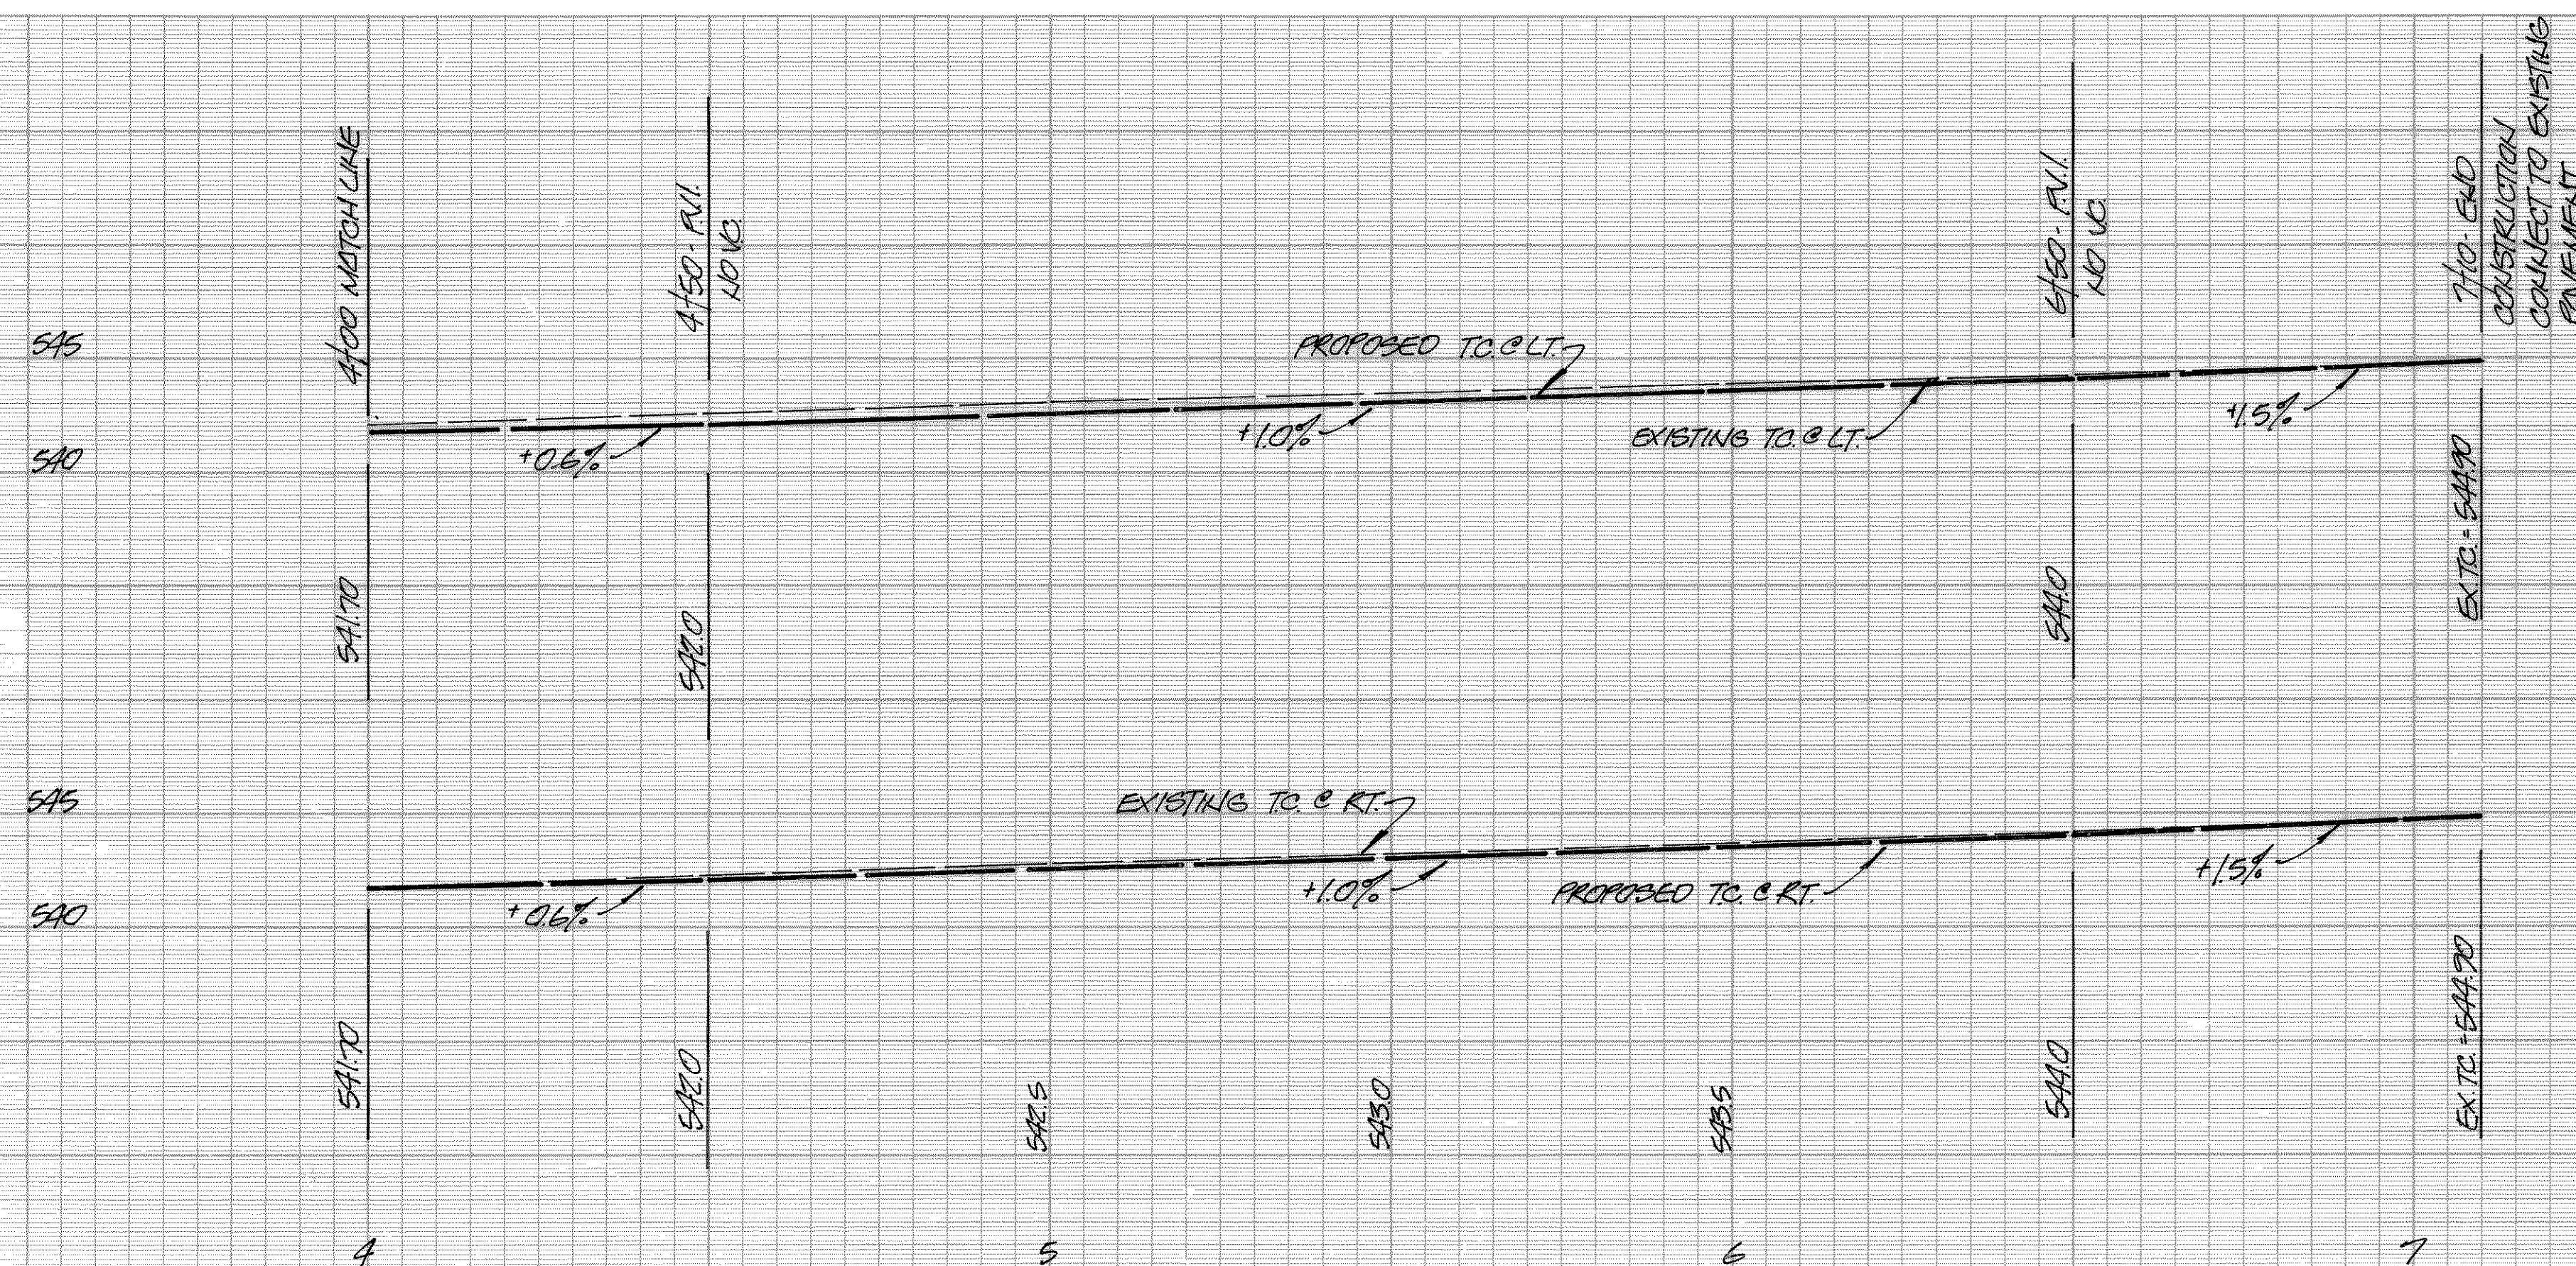

BENCH MARK:
1.0" W. CONC. BETWEEN 2.25\"/>

SCALE: 1\"/>

REVISION NO.	REMARKS	DATE
PAVING IMPROVEMENTS KRISTY LANE		
CITY OF ROCKWALL, TEXAS 205 W. RUSK STREET 214-722-1111		
DESIGNED: W.L.D.	NOTE	
DRAWN: W.L.D.	APPROVED: W.L. Dougherty	
JOB NO. 87006	DATE: 3-87	SHEET NO. 51

