



NOTE:
ALL CONSTRUCTION TO CONFORM
TO CITY OF ROCKWALL STANDARDS

NOTE:
ALL STORM SEWER PIPE TO BE CLASS
III REINFORCED CONCRETE PIPE.

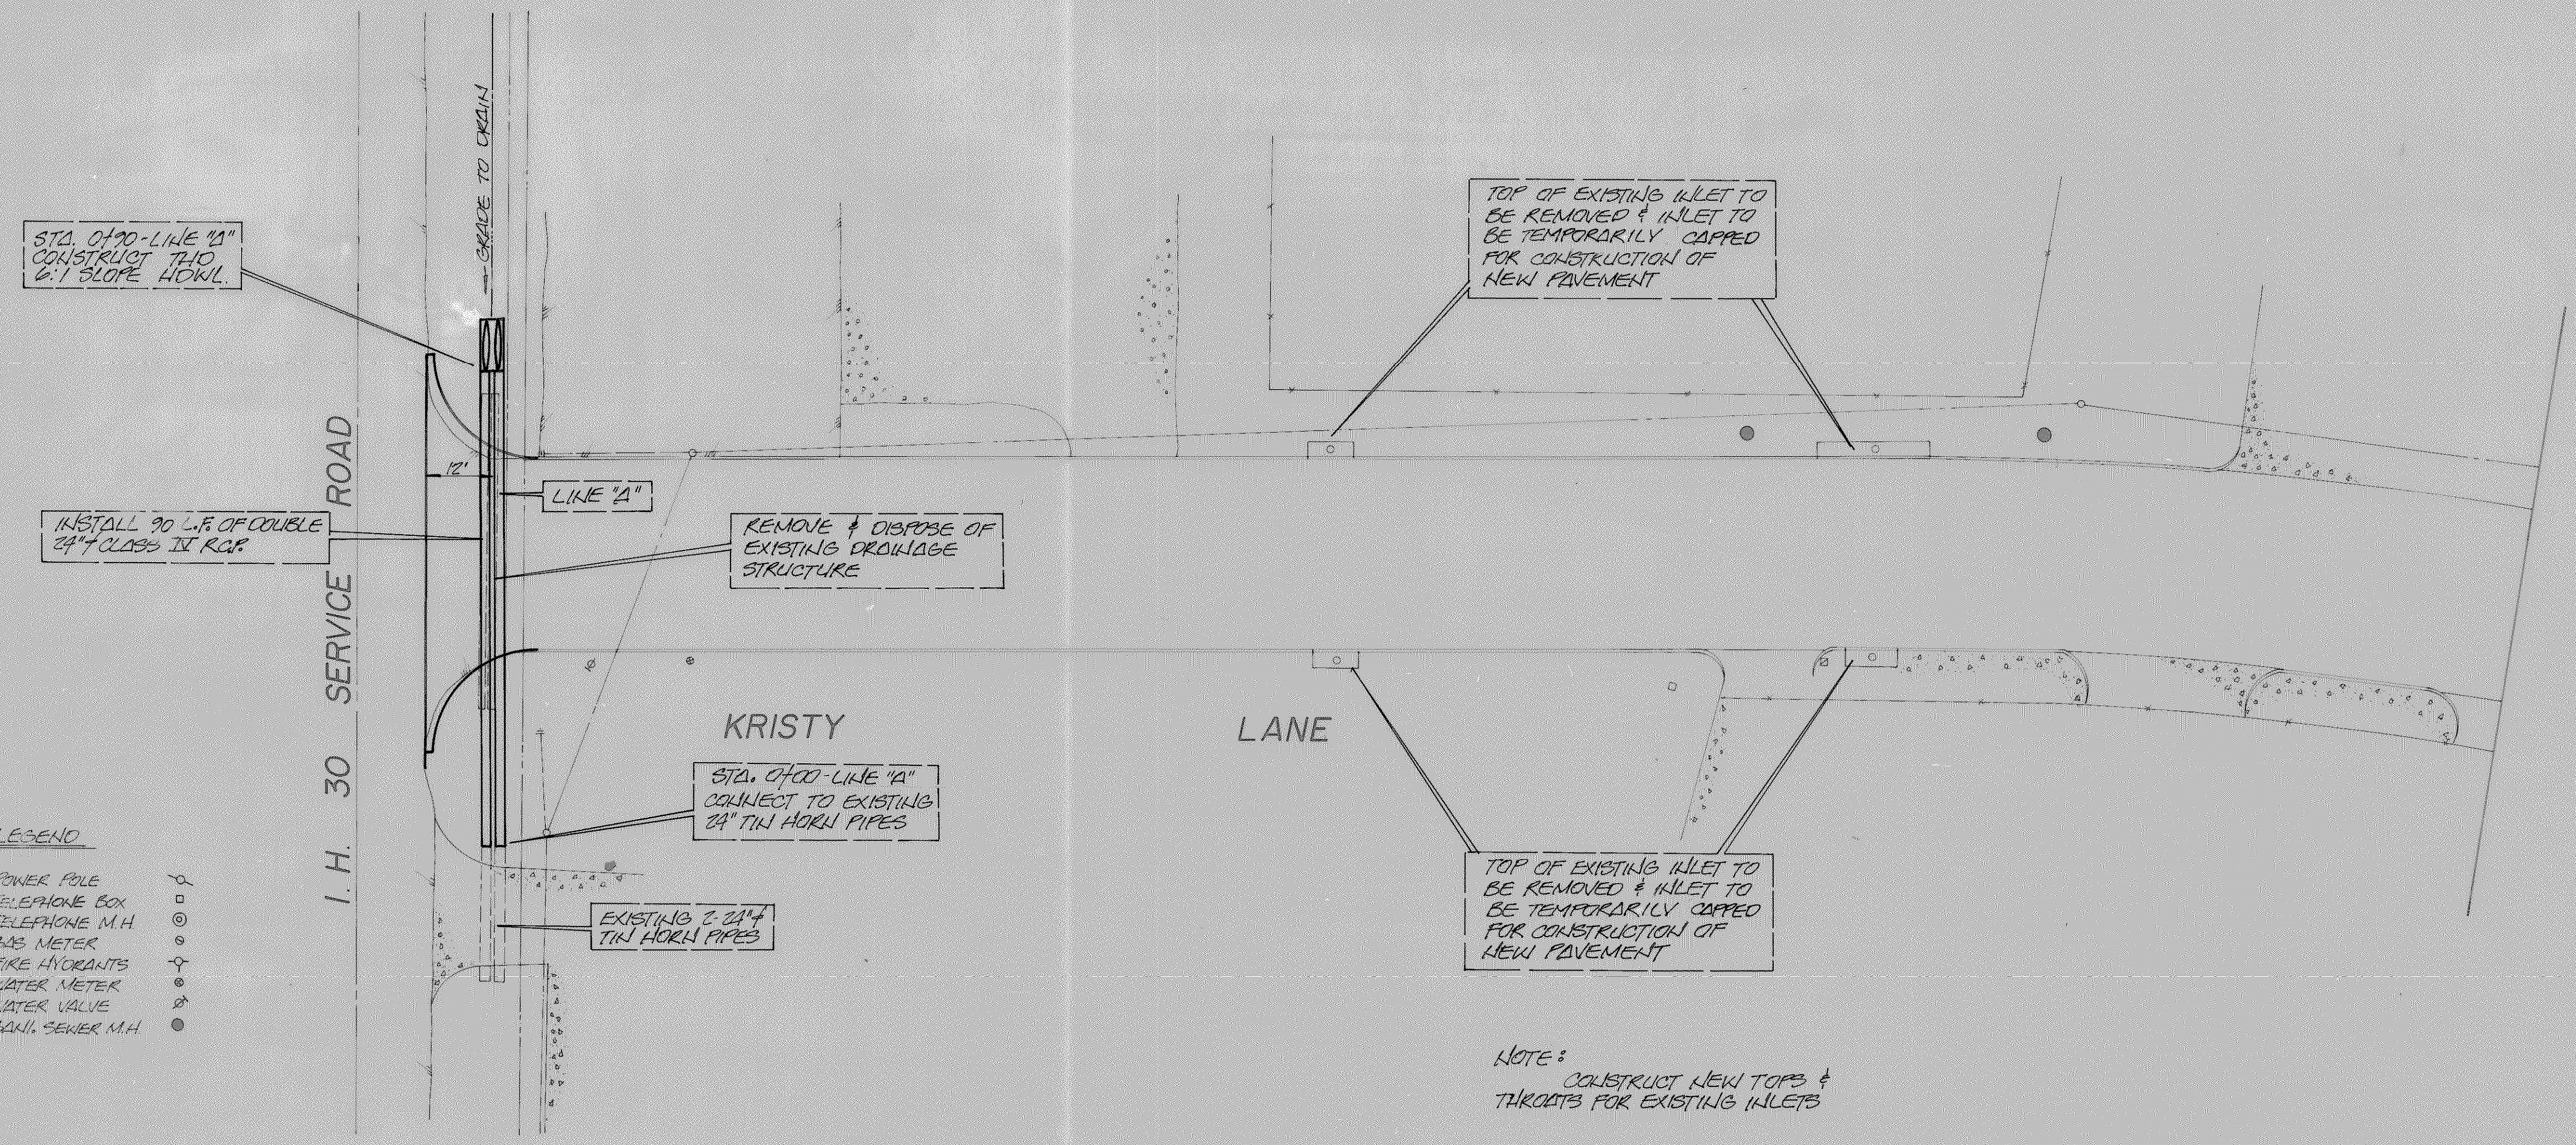

NOTE:
CONSTRUCT NEW TOPS &
THROATS FOR EXISTING INLETS

- LEGEND
- POWER POLE
 - TELEPHONE BOX
 - TELEPHONE M.H.
 - GAS METER
 - FIRE HYDRANTS
 - WATER METER
 - WATER VALVE
 - STORM SEWER M.H.

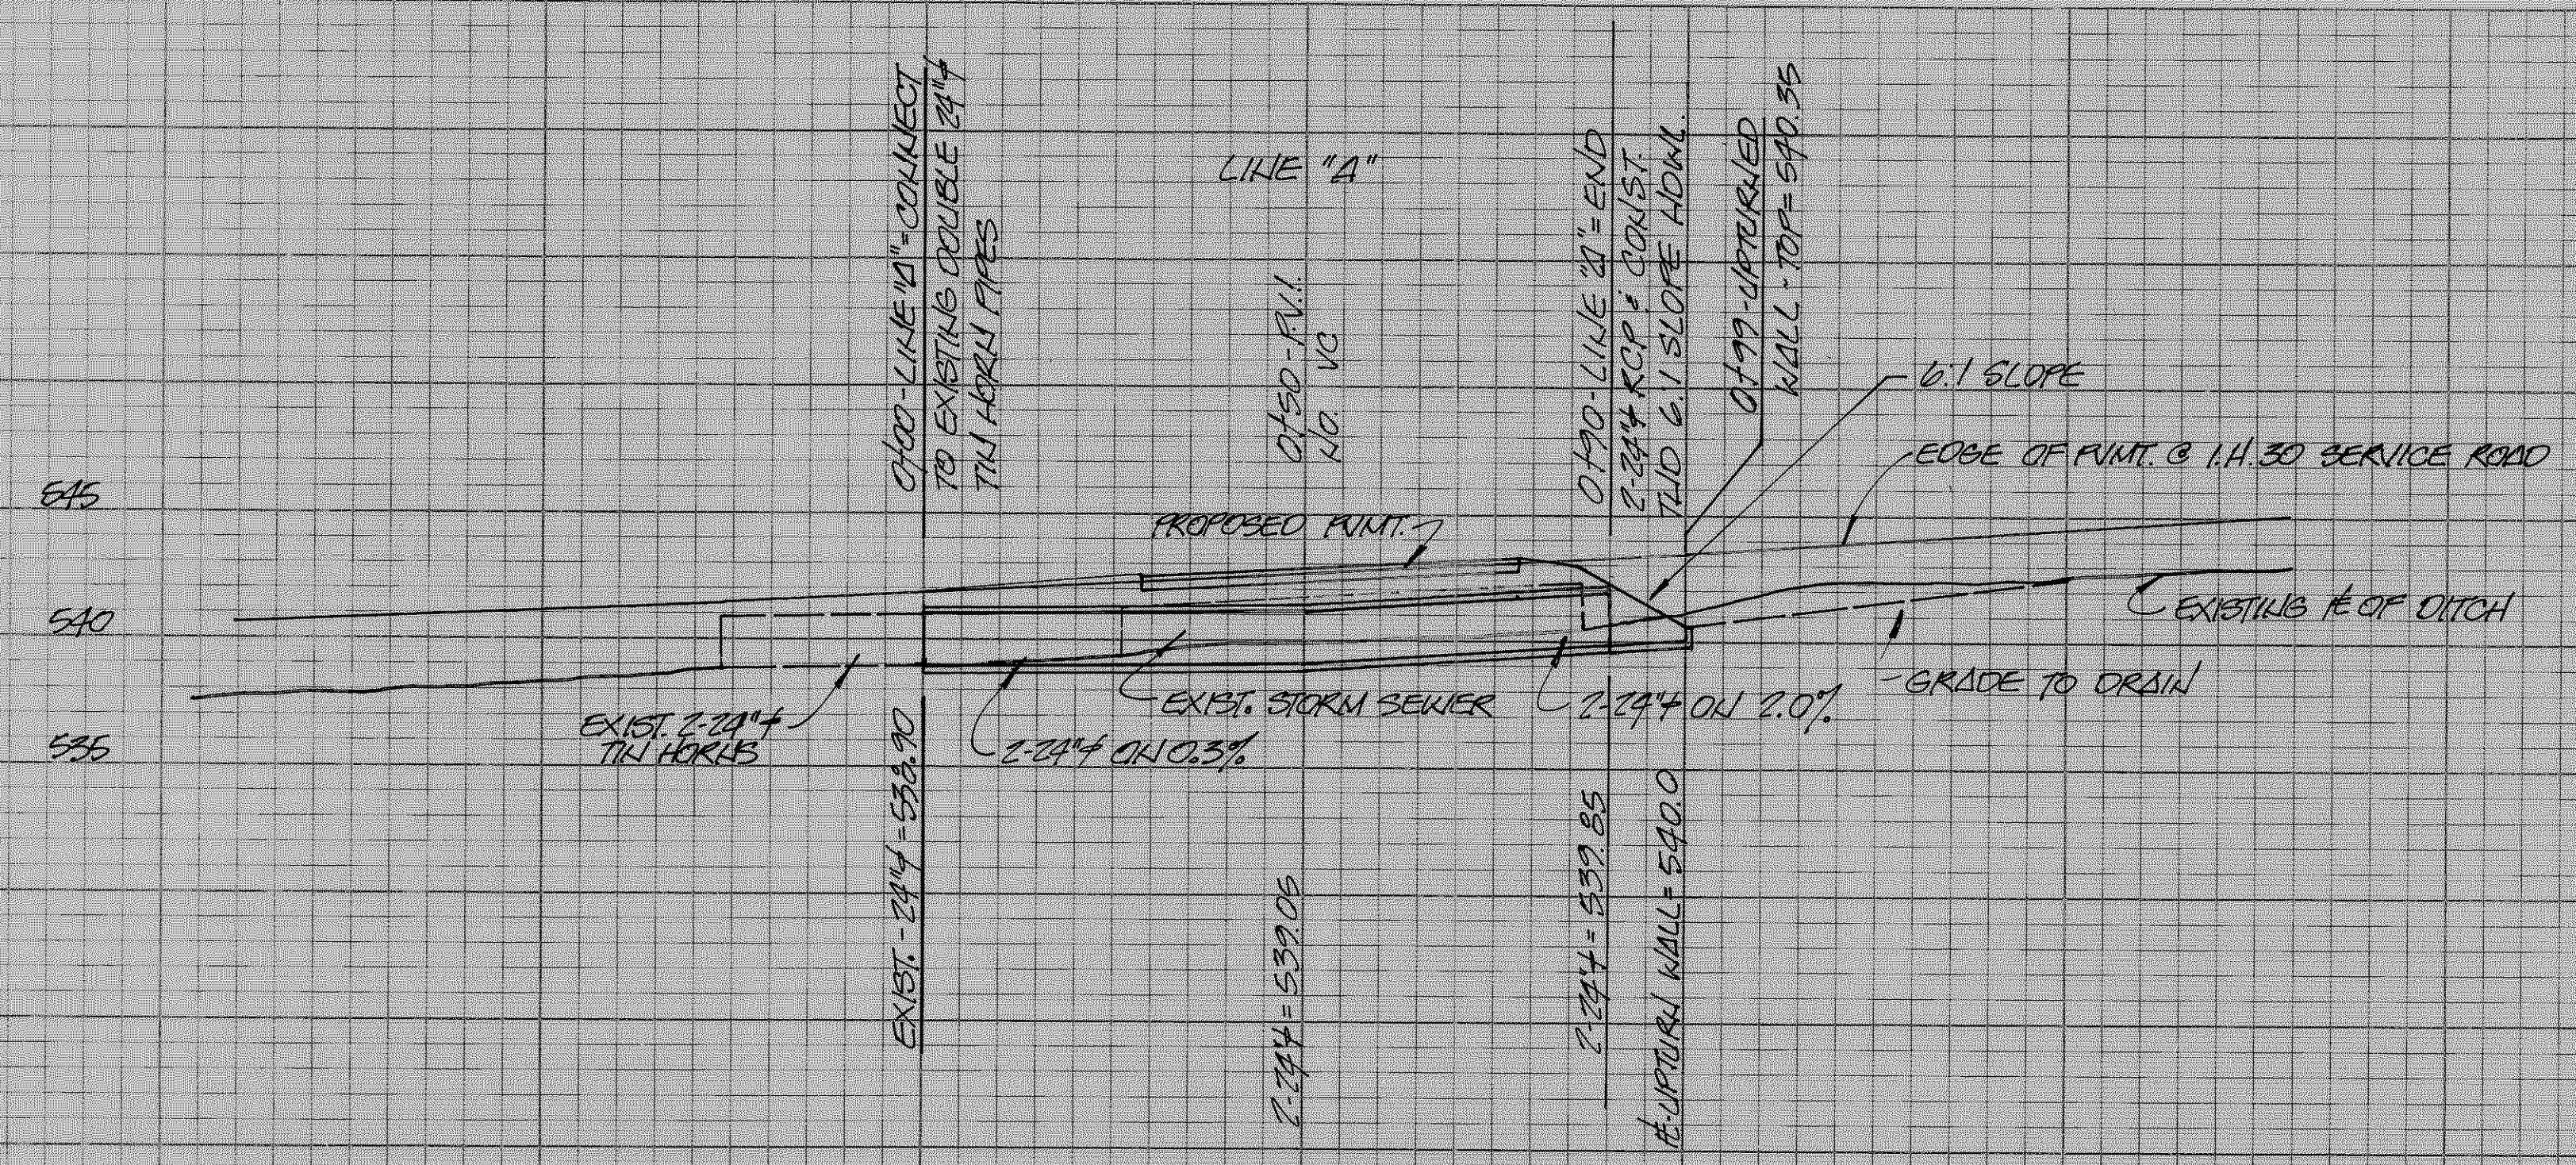

BENCH MARK:
1\"/>

REVISION: 5/23/87
REVISED LENGTH OF STORM SEWER
FROM 100' TO 90' AND 3\"/>

REVISION	NO.	REMARKS	DATE
DRAINAGE IMPROVEMENTS KRISTY LANE			
CITY OF ROCKWALL, TEXAS 205 W. RUSK STREET 214-722-1111			
DESIGNED:	W.L.D.	SCALE:	NOTED
DRAWN:	W.L.D.	APPROVED:	<i>[Signature]</i>
JOB NO.	87006	DATE	3-87
		SHEET NO.	32

