
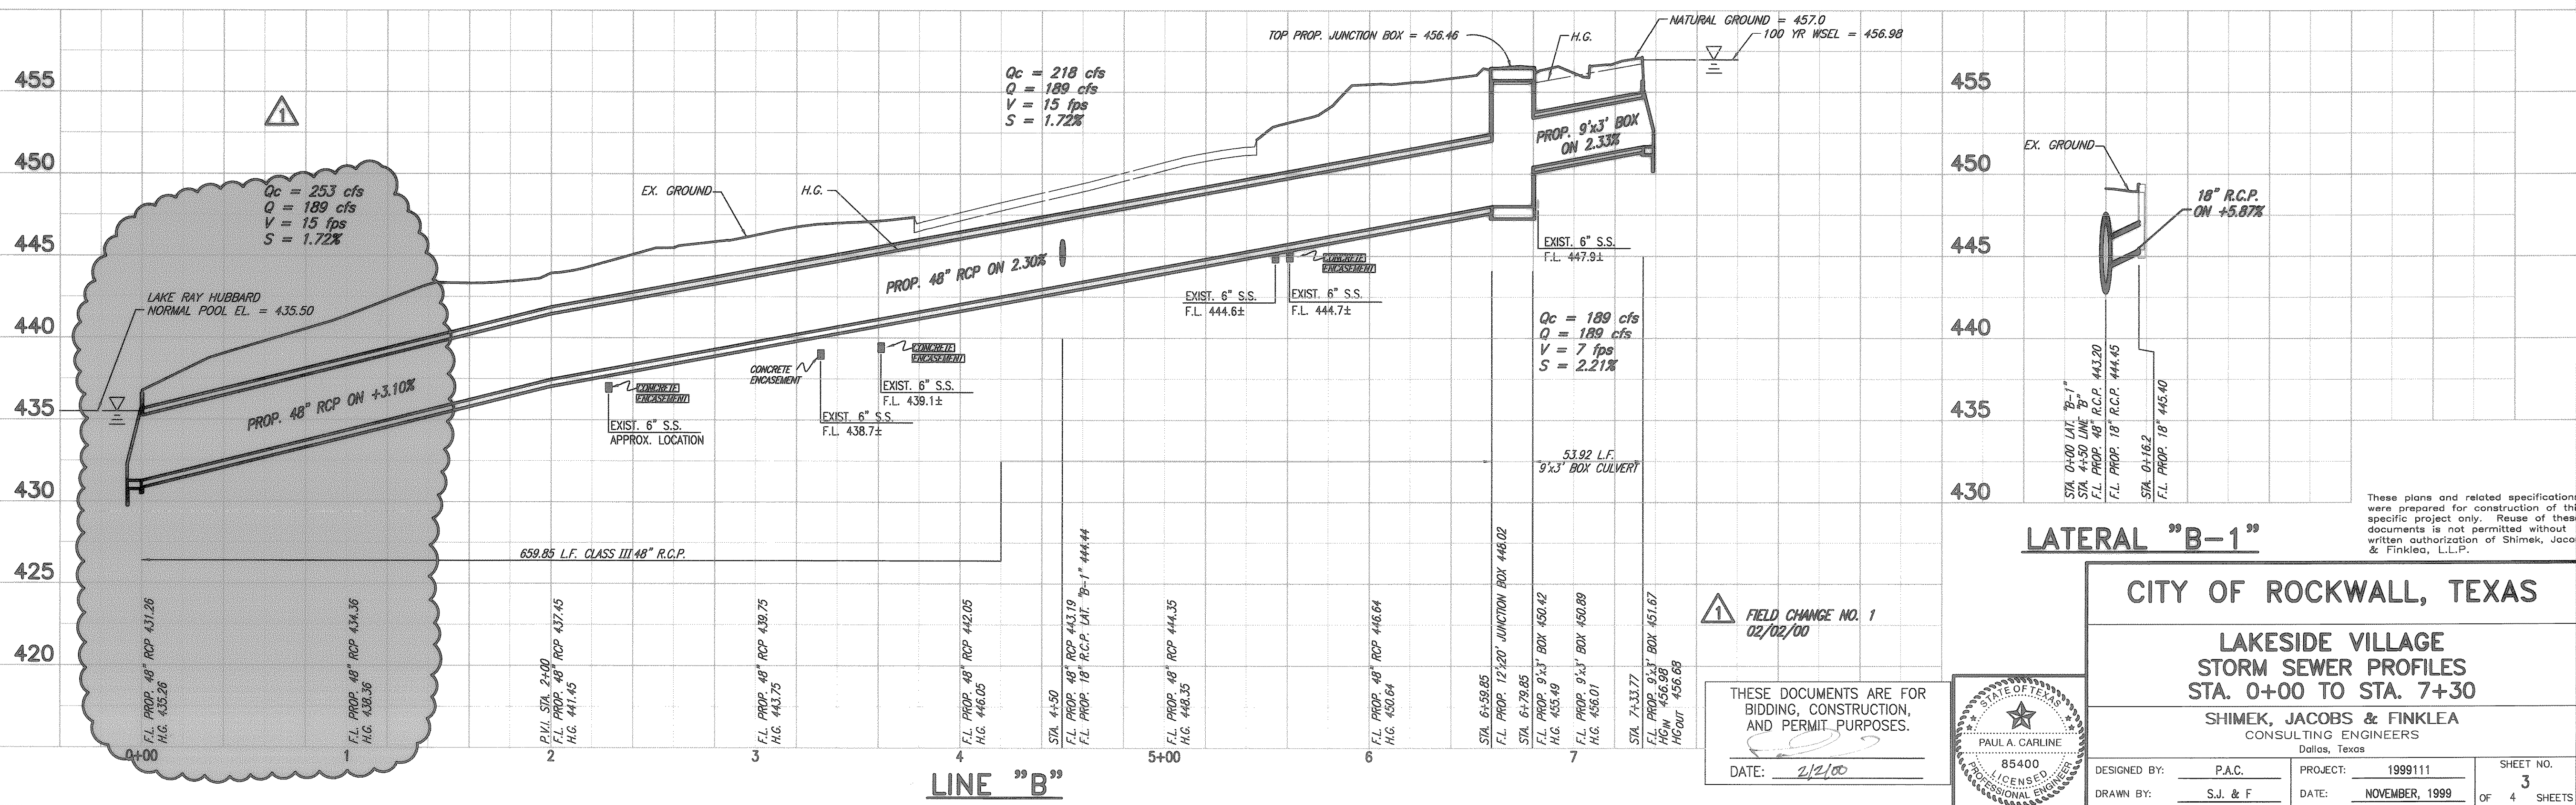


REVISED 02/02/00 CRN H:\PROJECTS\ROCKWALL\99111\SHEETS\99111-03.DWG 07/01/99 PAC

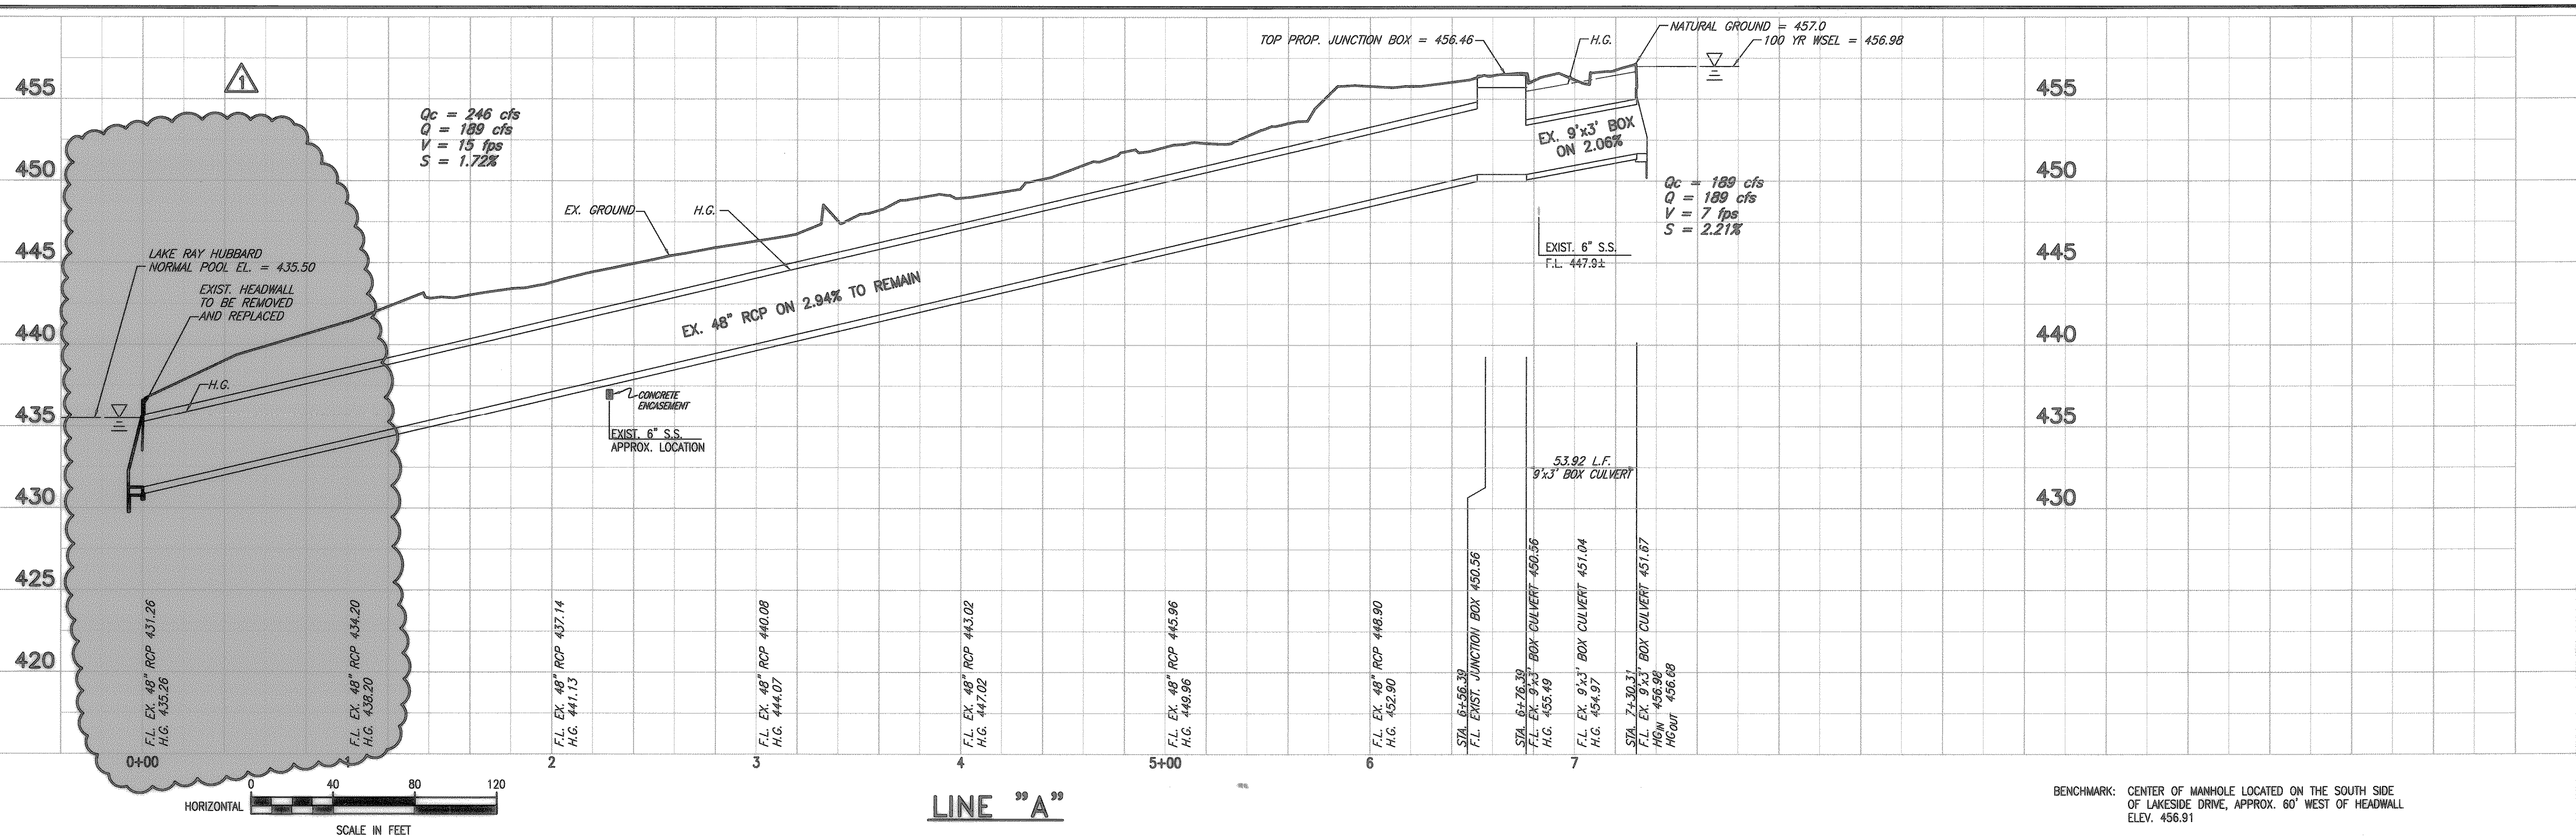

BENCHMARK: CENTER OF MANHOLE LOCATED ON THE SOUTH SIDE OF LAKESIDE DRIVE, APPROX. 60' WEST OF HEADWALL ELEV. 456.91

LATERAL "B-1"

CITY OF ROCKWALL, TEXAS

**LAKESIDE VILLAGE
STORM SEWER PROFILES
STA. 0+00 TO STA. 7+30**


**SHIMEK, JACOBS & FINKLEA
CONSULTING ENGINEERS**
Dallas, Texas

DESIGNED BY: P.A.C.	PROJECT: 1999111	SHEET NO. 3
DRAWN BY: S.J. & F.	DATE: NOVEMBER, 1999	OF 4 SHEETS

FIELD CHANGE NO. 1
02/02/00

THESE DOCUMENTS ARE FOR BIDDING, CONSTRUCTION, AND PERMIT PURPOSES.

DATE: 2/2/00

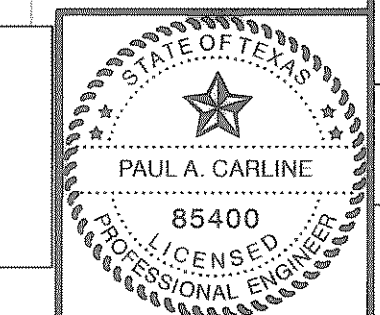

These plans and related specifications were prepared for construction of this specific project only. Reuse of these documents is not permitted without written authorization of Shimek, Jacobs & Finklea, L.L.P.