



PLAN VIEW
Scale: 1/2" = 1'-0"

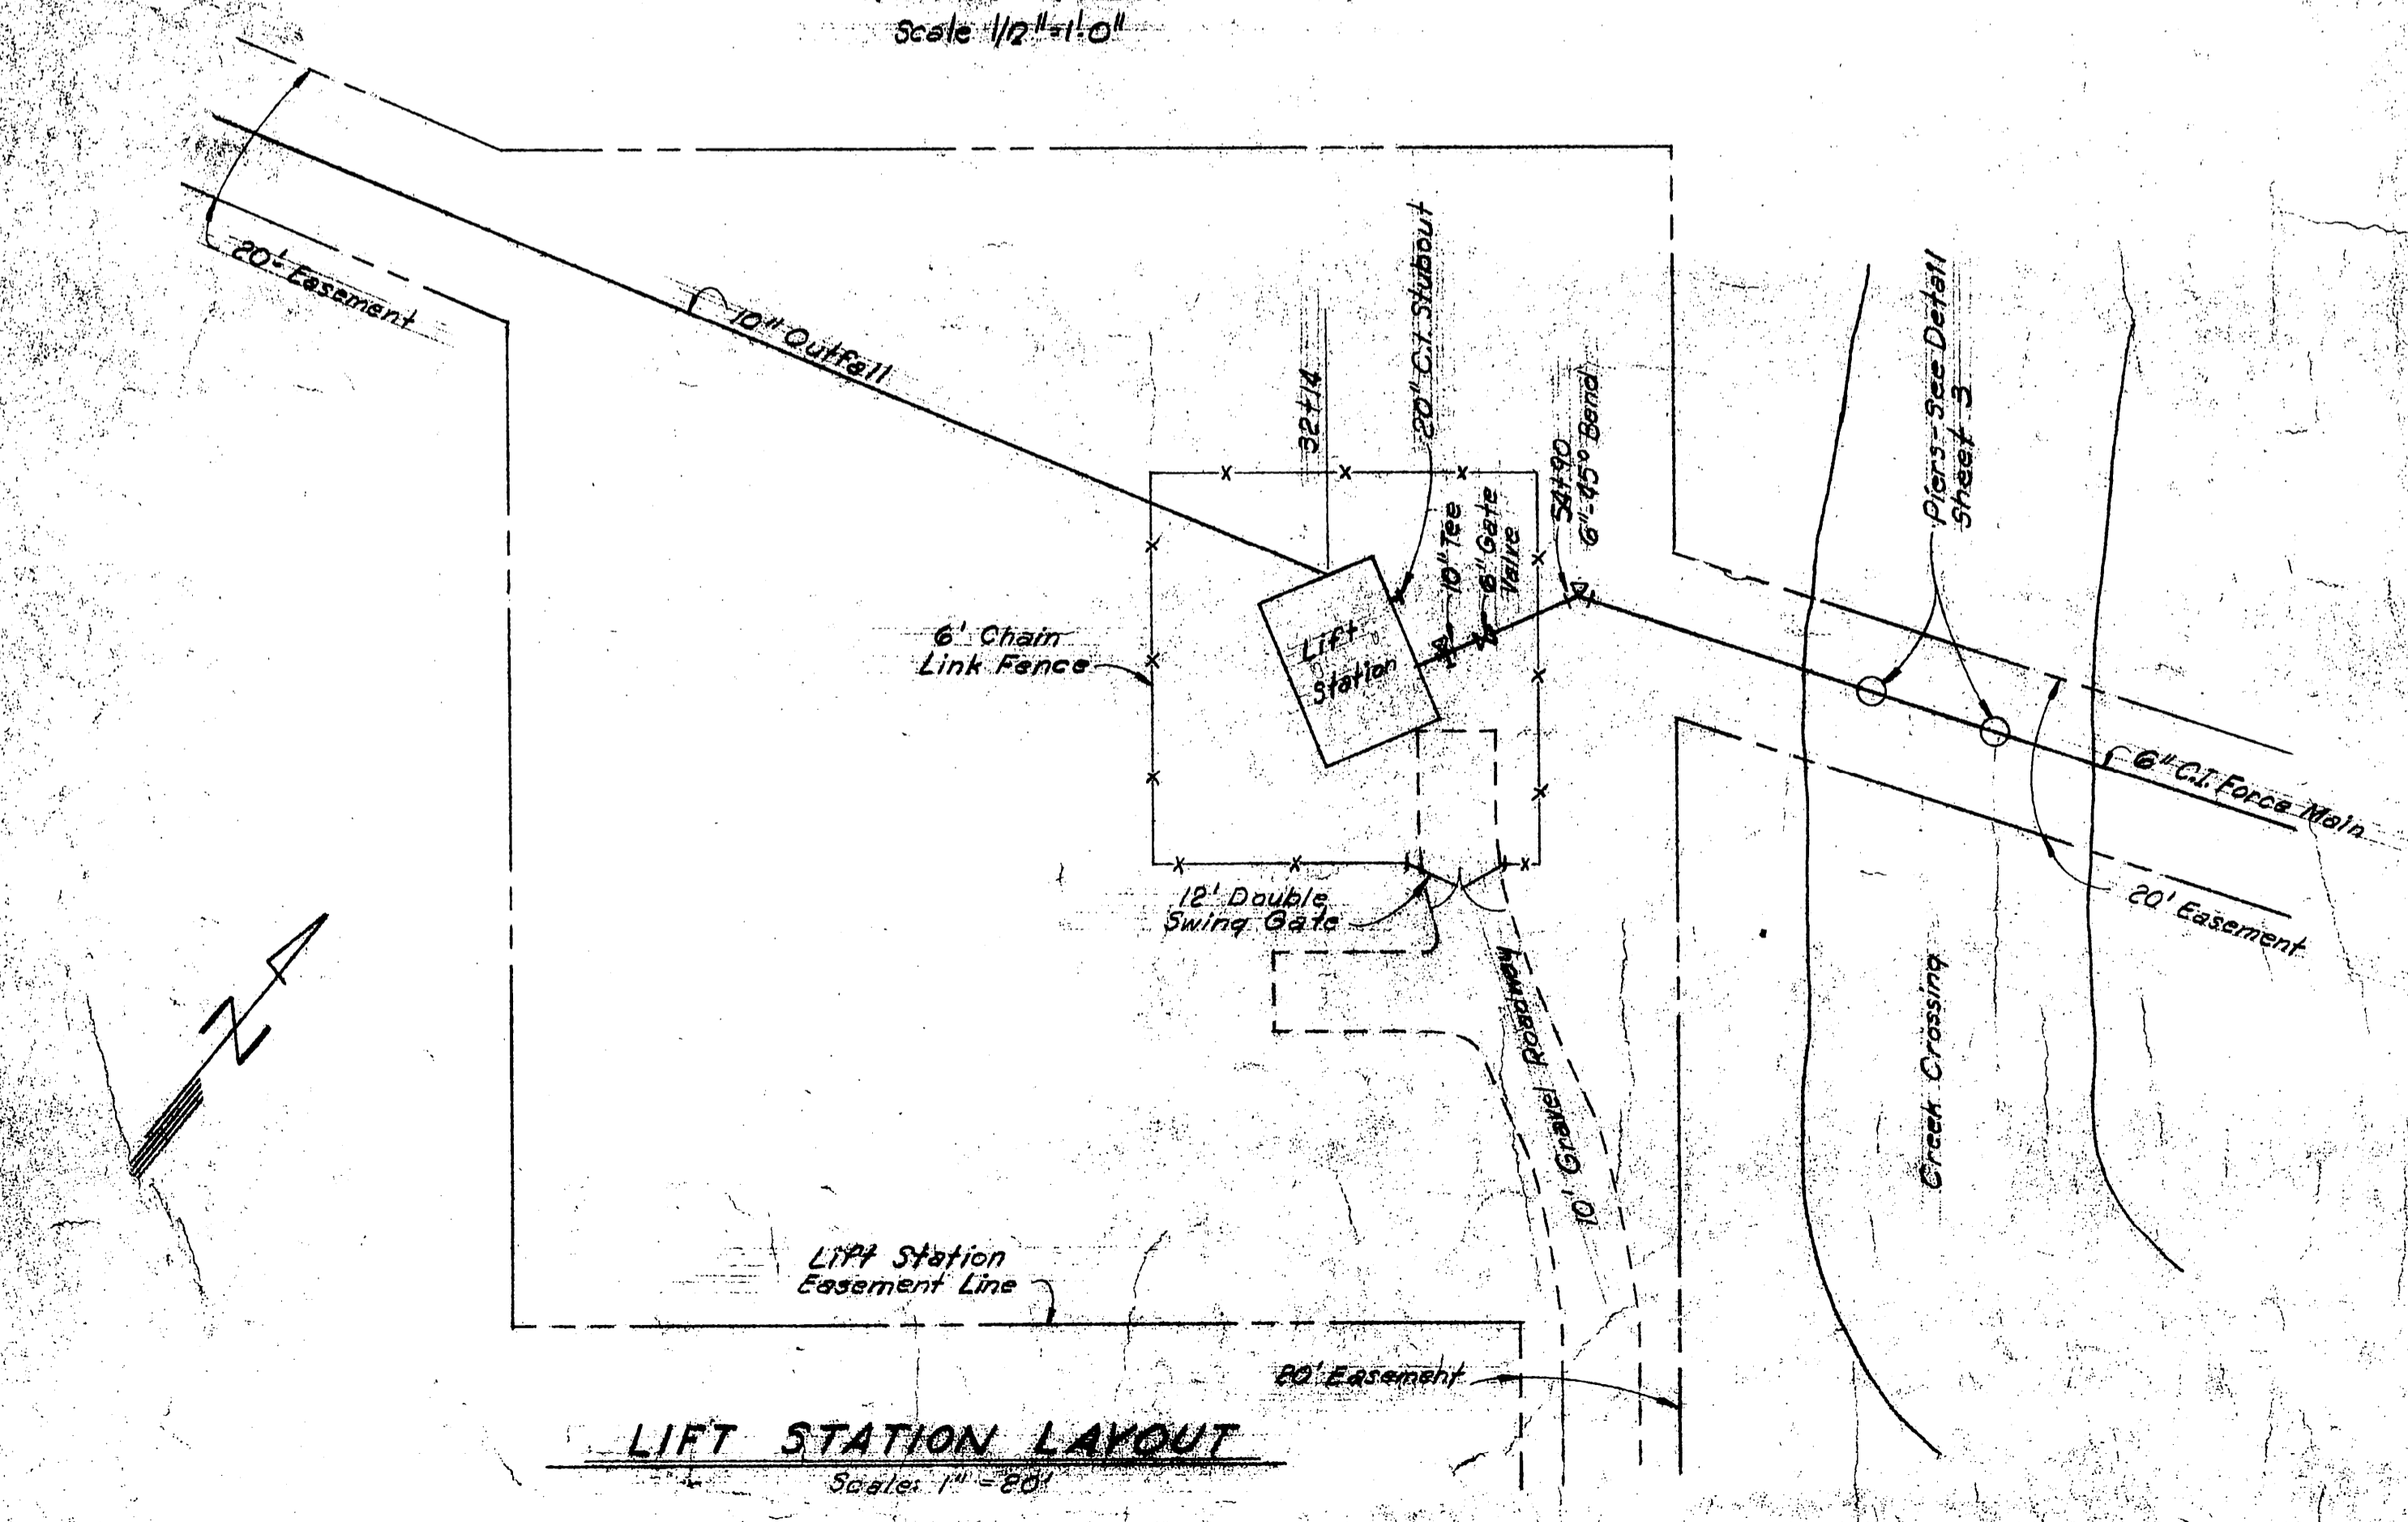

LIFT STATION LAYOUT
Scale: 1" = 20'

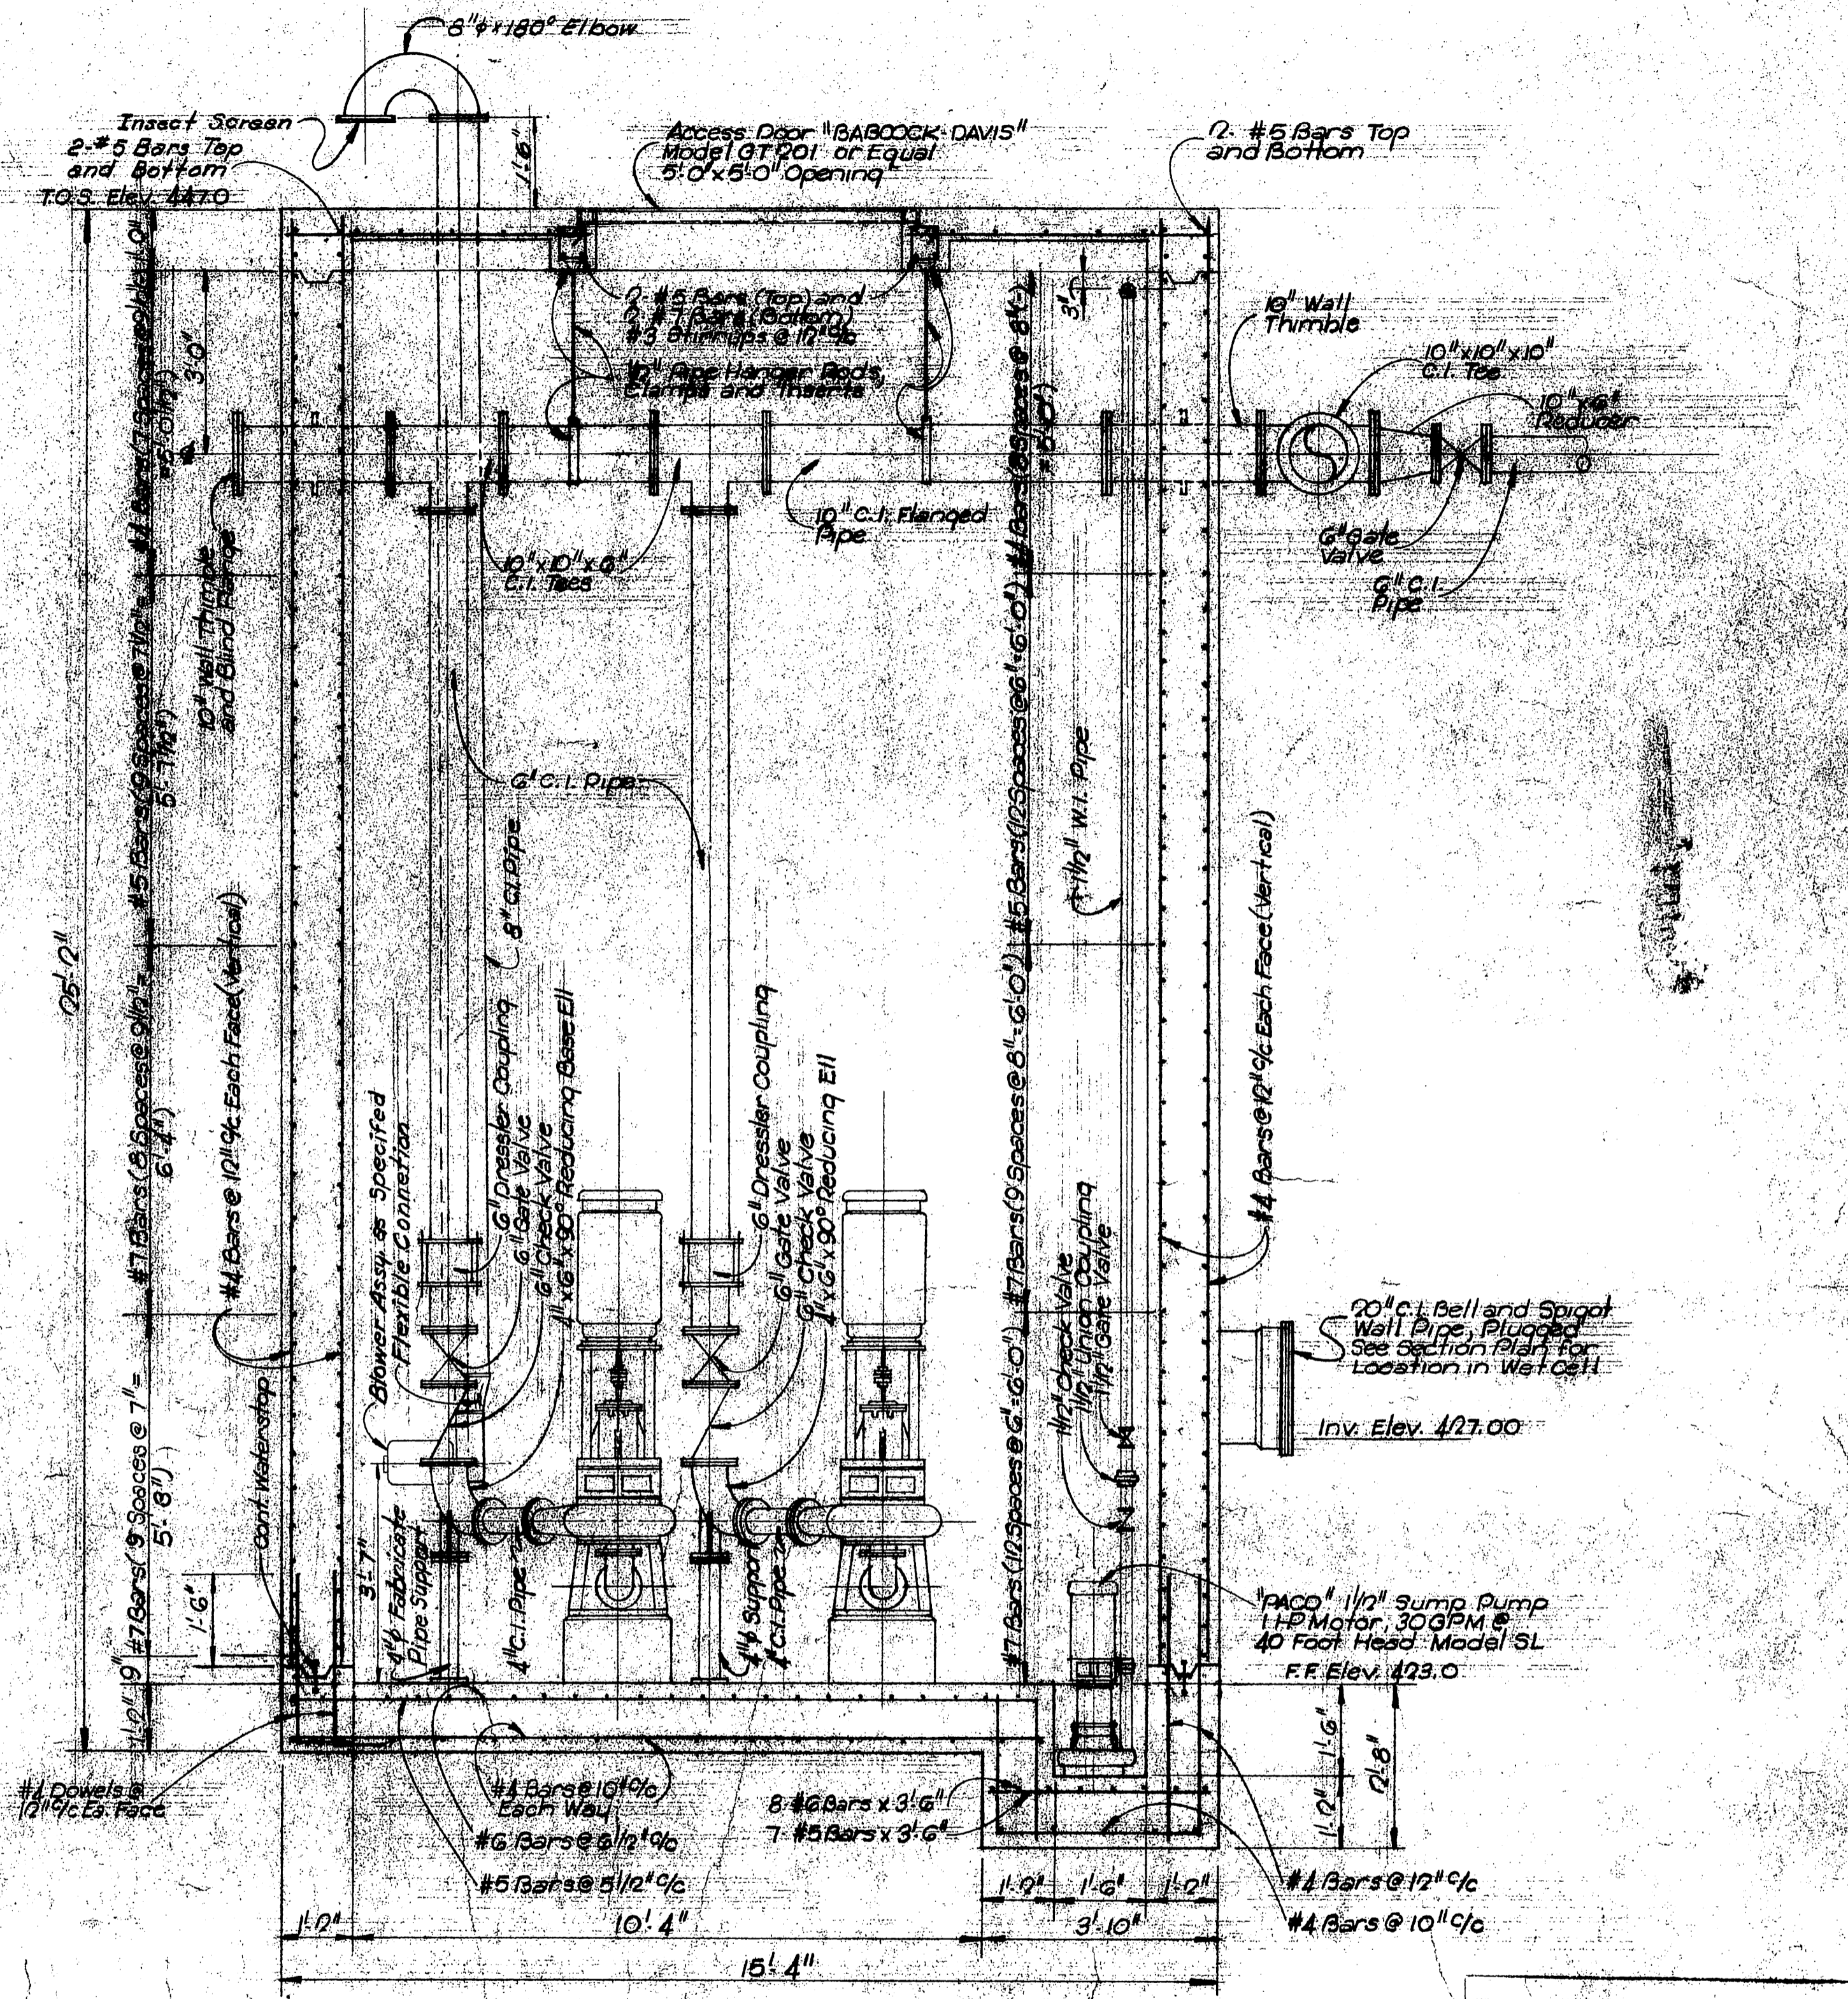

SECTION 'B-B'
Scale: 1/2" = 1'-0"

REVISED AS BUILT
DATE AUG. 1972

ROCKWALL, TEXAS
SEWER SYSTEM IMPROVEMENTS
LAKESIDE VILLAGE OUTFALL

DESIGNED: D.L.D.	FREESE, NICHOLS & ENDRESS	DATE: DEC. 1970
DRAWN: H.E.D.	CONSULTING ENGINEERS	SCALE: AS SHOWN
CHECKED: H.E.D.	FOUNT WORTH, TEXAS	ROK. 70039
QUOTED: R.L.N.		SHEET

