



SECTIONAL PLAN VIEW  
Scale 1/4" = 1'-0"

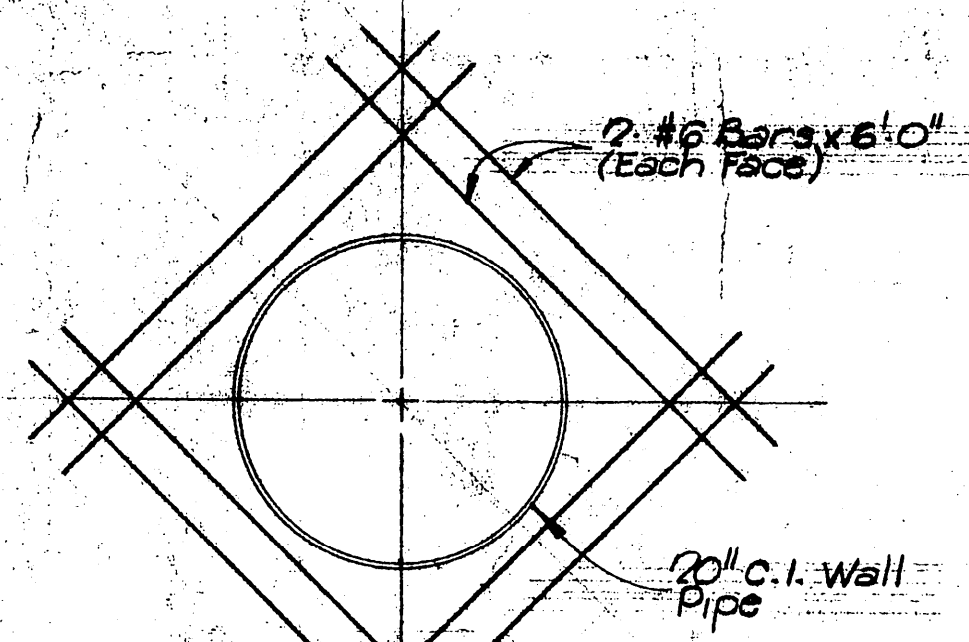

EXTRA REINFORCING REQUIRED AT  
PIPE OPENING  
Scale 1" = 1'-0"

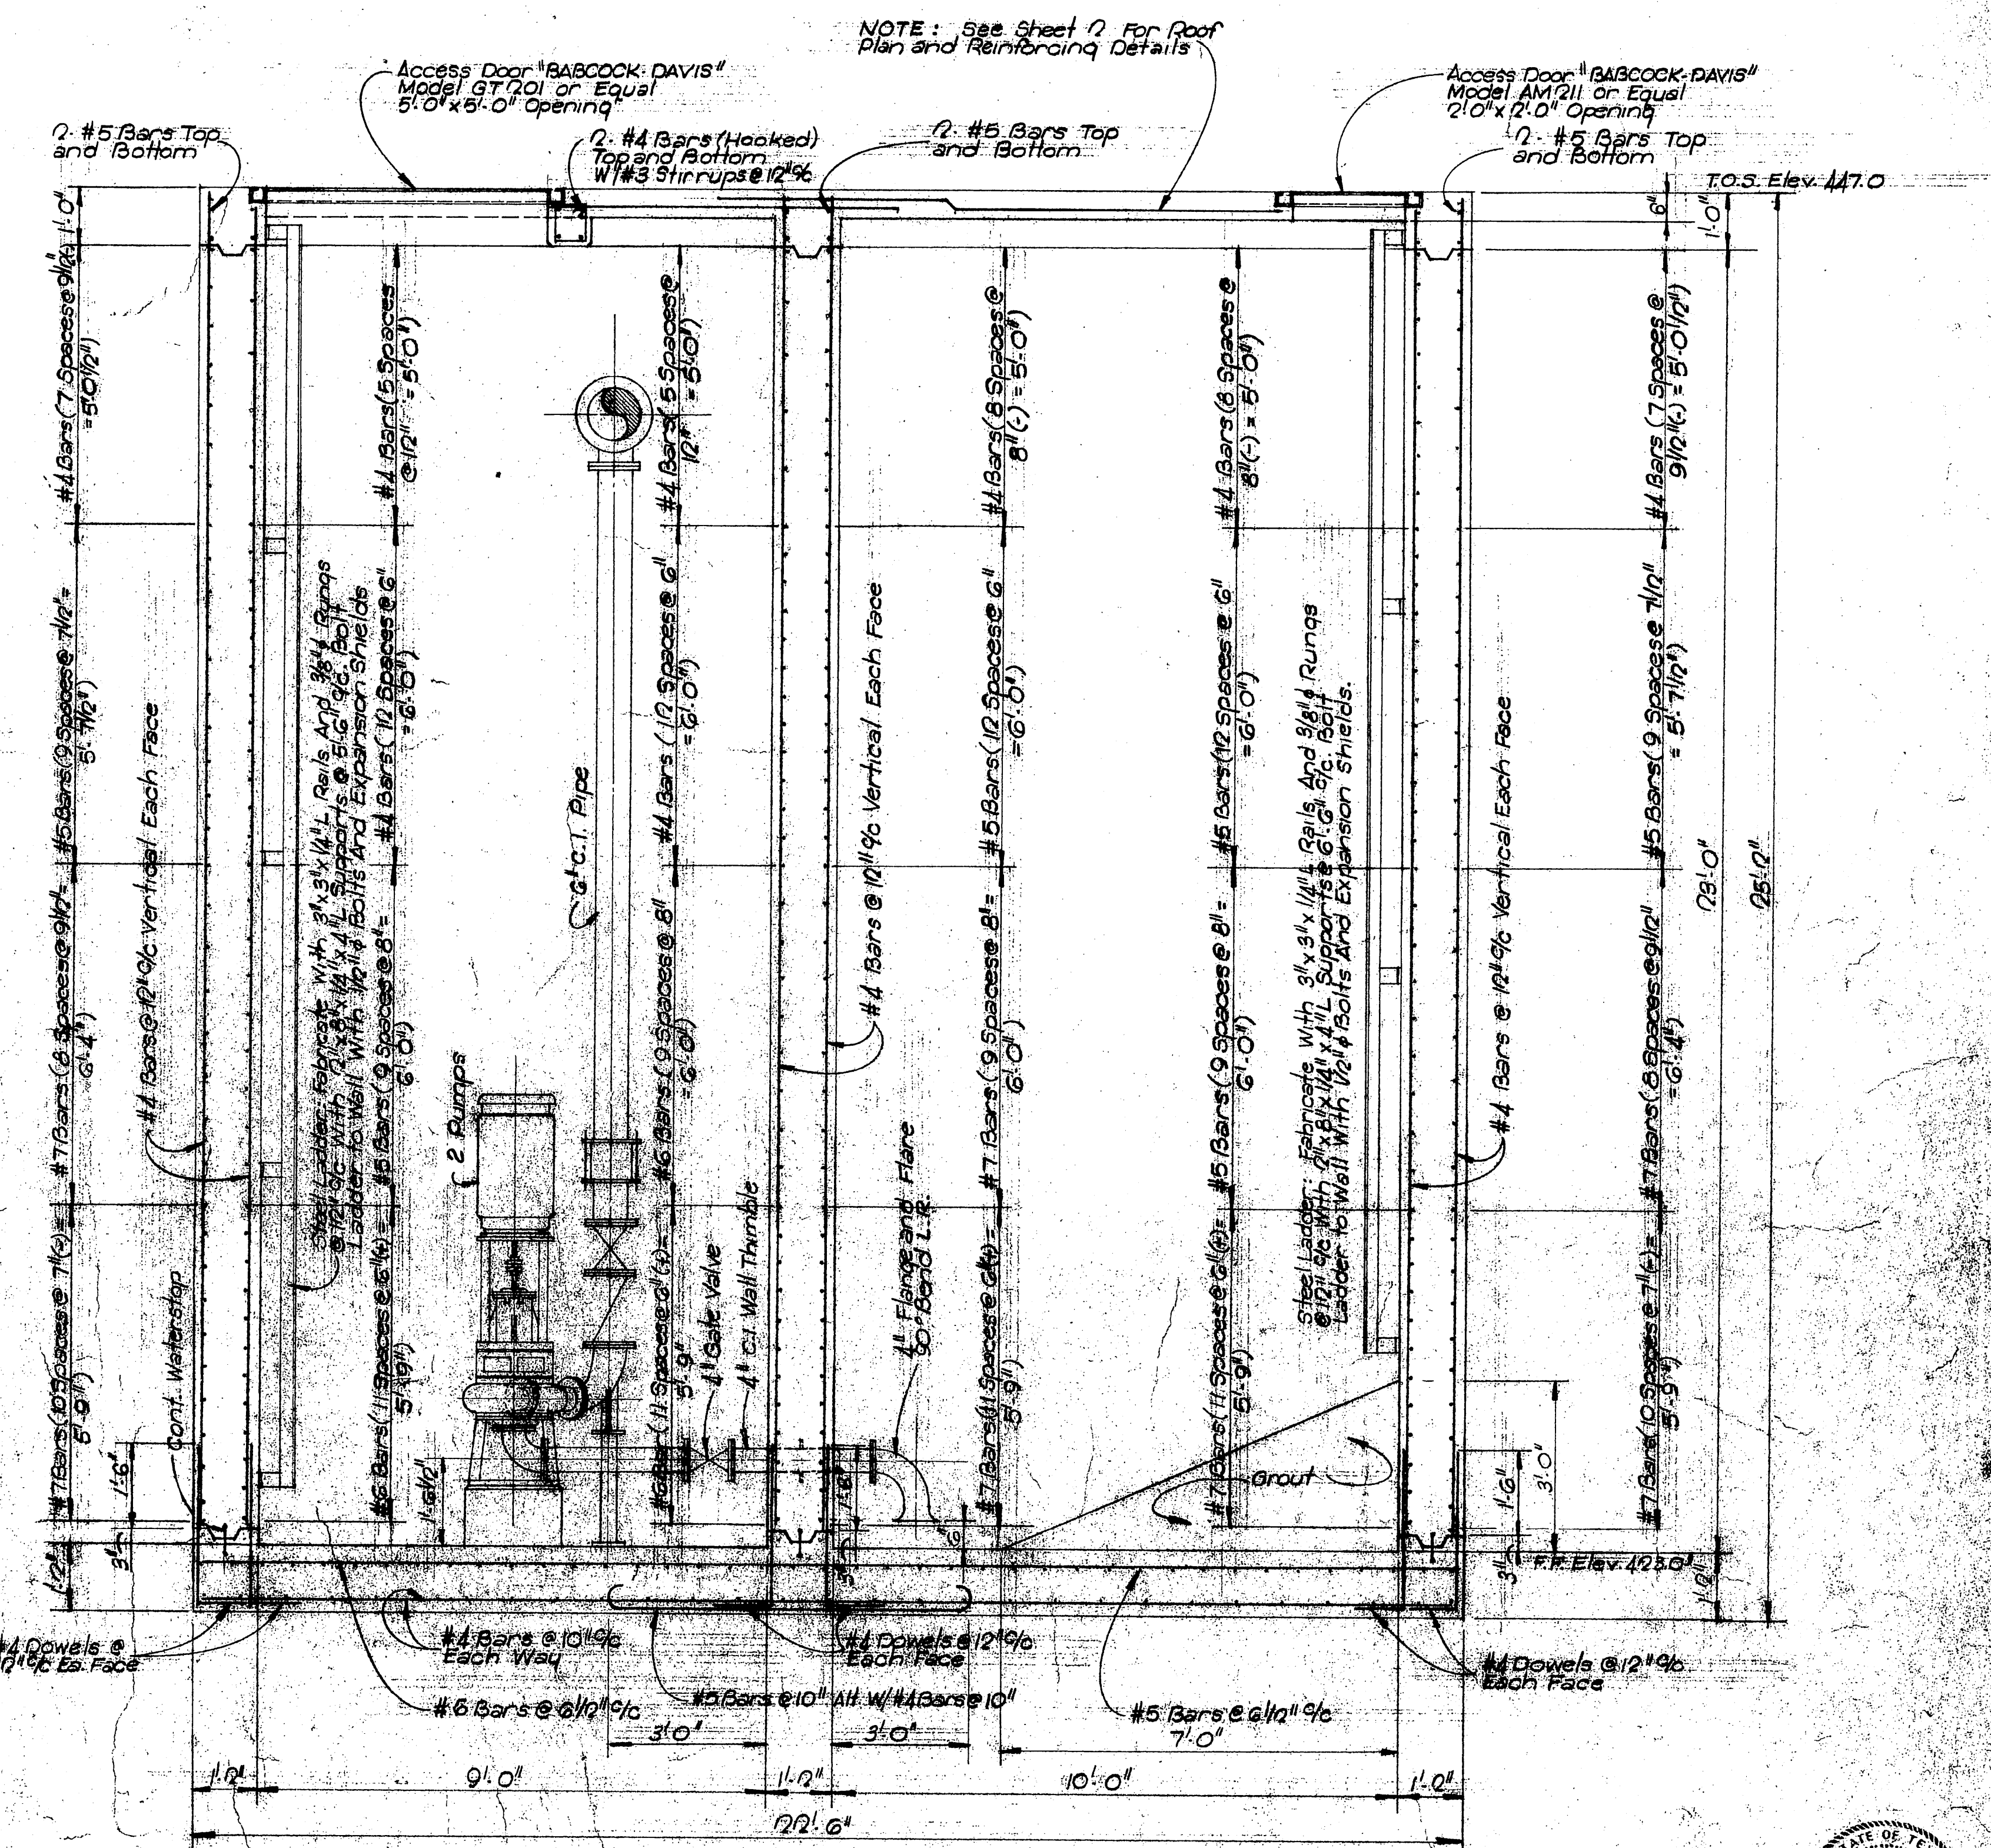


SECTION "A-A"  
Scale 1/4" = 1'-0"

NOTE: See Sheet 2 For Roof  
Plan and Reinforcing Details

NOTE: See SECTIONS A and B  
For Bar's Size and Spacing  
of Wall Reinforcing

Access Door "BABCOCK-DAVIS"  
Model AM211 or Equal  
2'-0" x 2'-0" Opening

REVISED AS BUILT  
DATE AUG. 1972

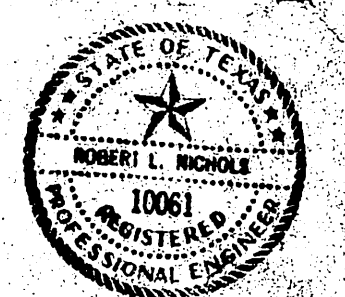

ROCKWALL, TEXAS  
SEWER SYSTEM IMPROVEMENTS  
LAKESIDE VILLAGE OUTFALL

DESIGNED: DLD	FRESE, NICHOLS & ENDRESS	DATE: DEC 1971
DRAWN: HED	CONSULTING ENGINEERS	SCALE: AS SHOWN
TRACED: HED	PORT WORTH, TEXAS	ROK 7003
CHECKED: RLN		SHEET 5 OF 5