



TIME 16.44 FILE: 1.Lift Station 2.dwg

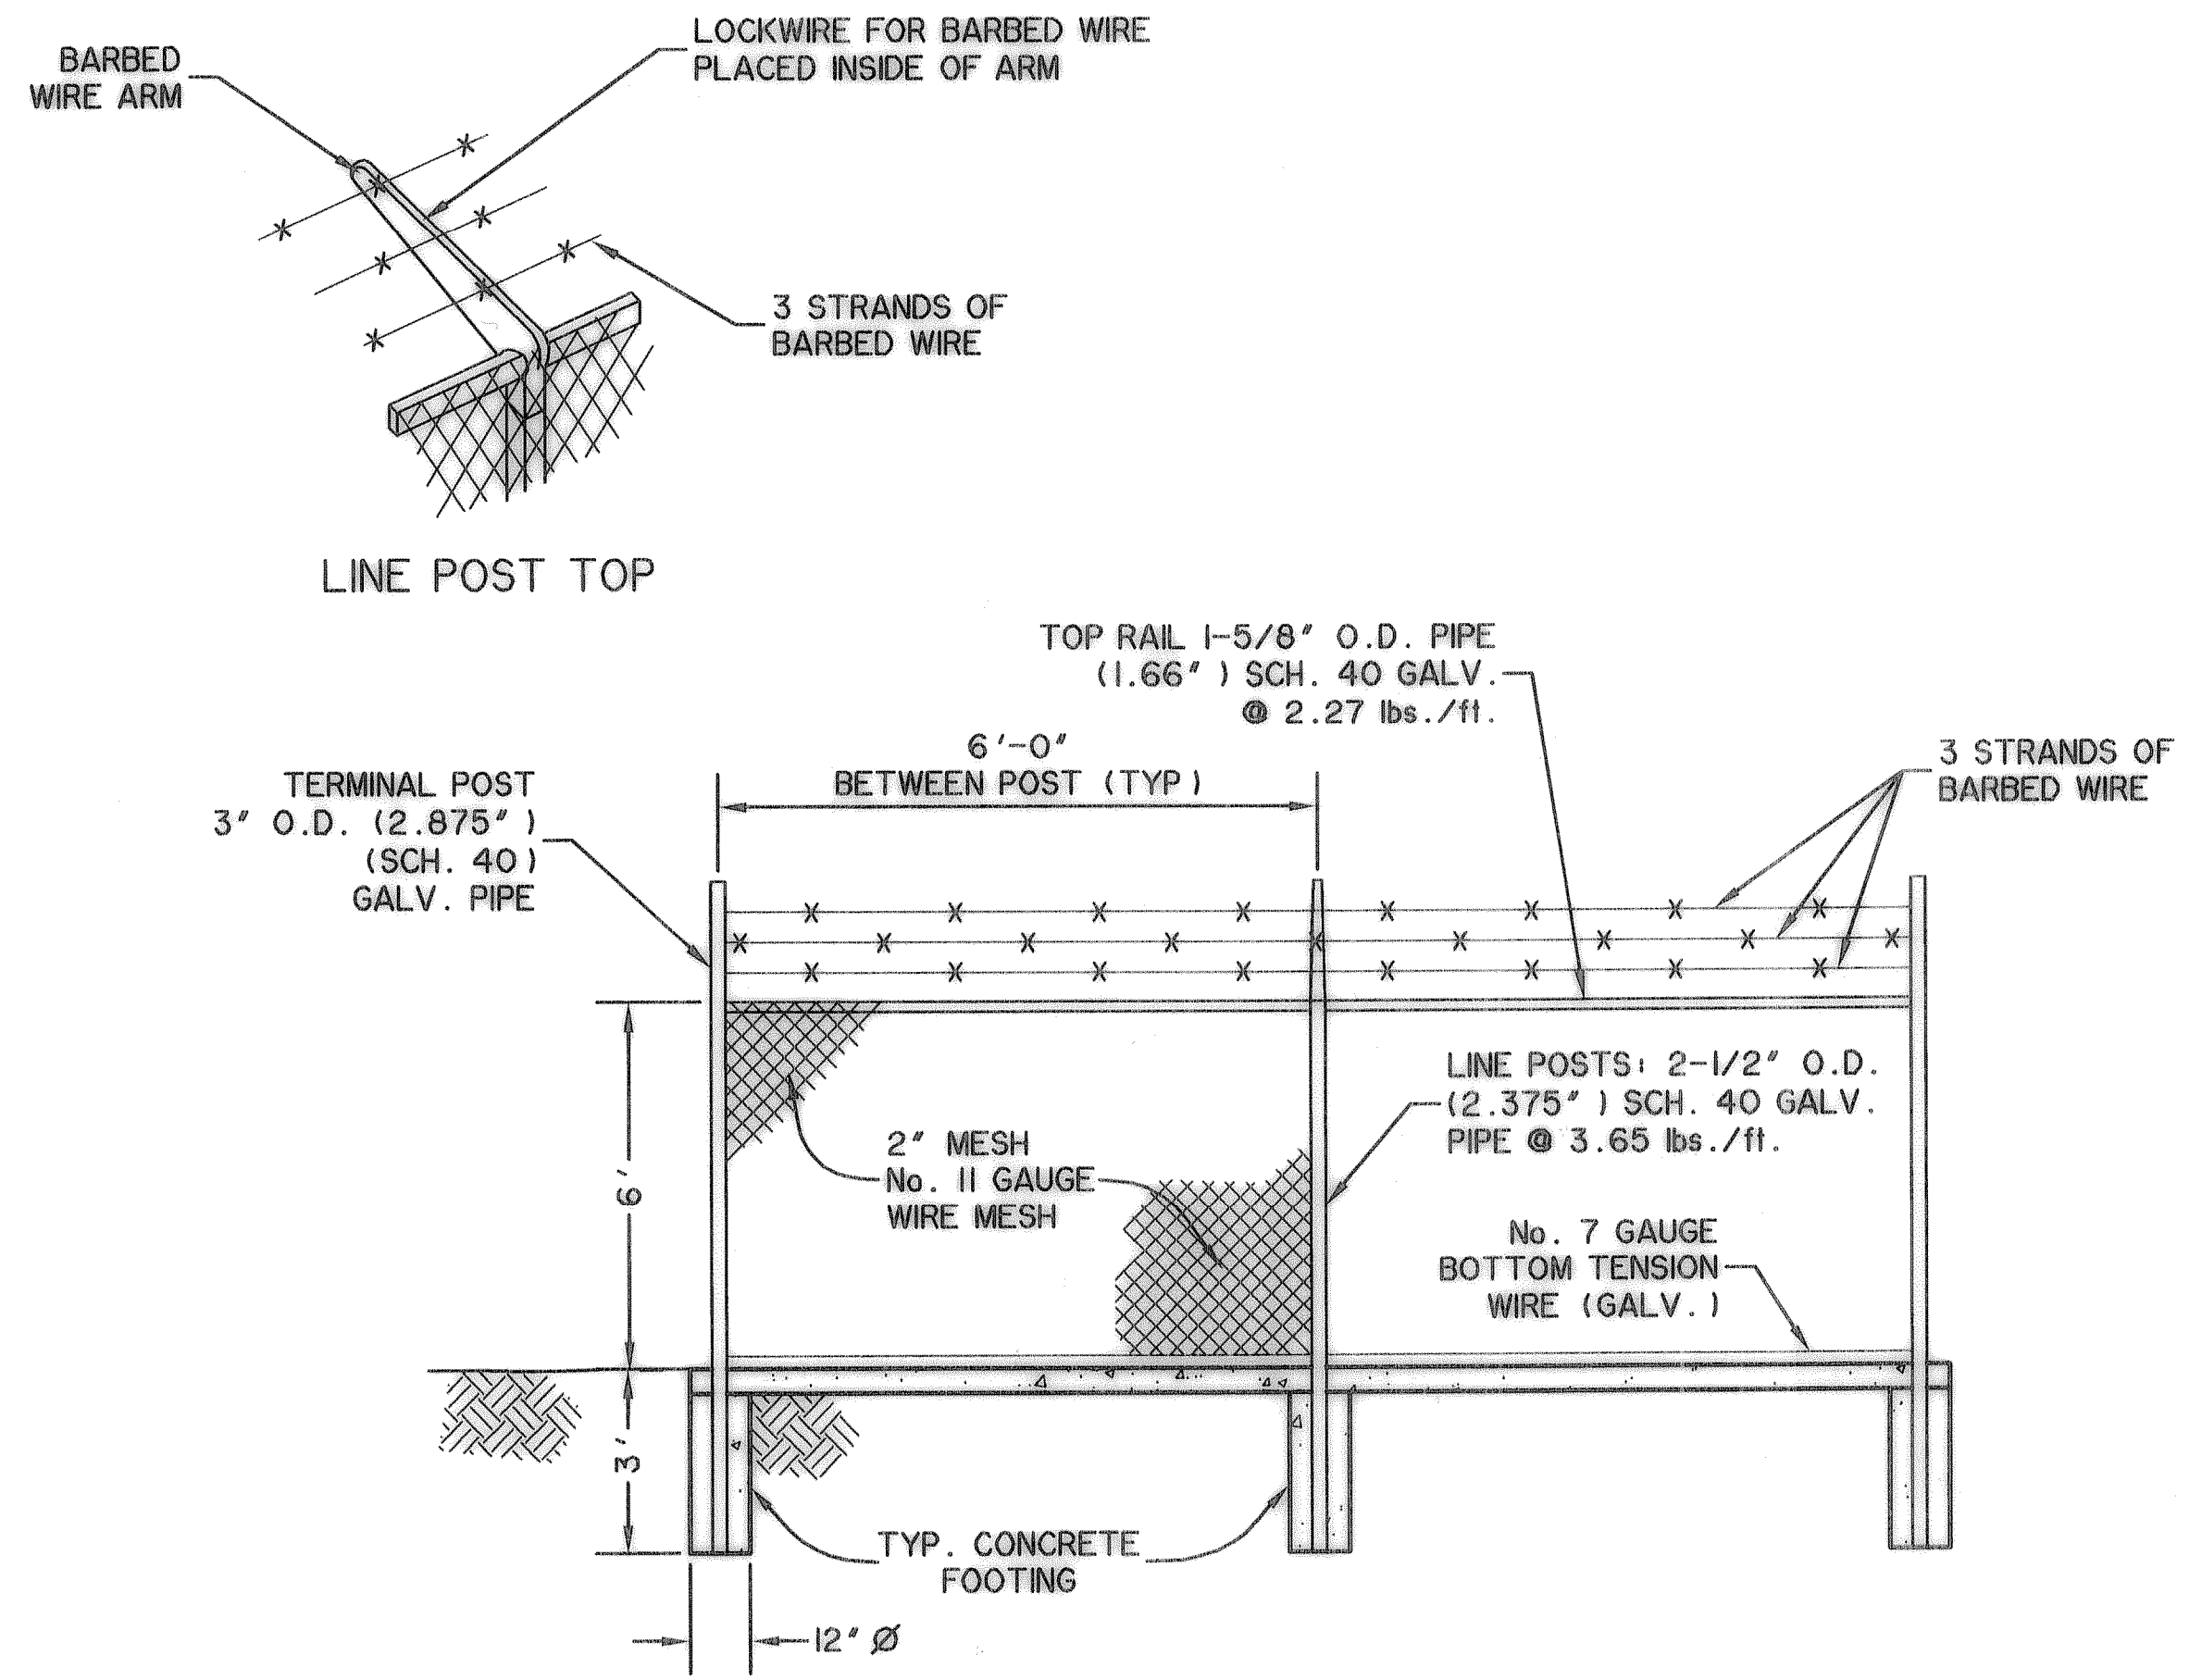

**CHAIN LINK FENCE WITH BARBED WIRE**  
 SCALE: NTS  
**14' SLIDE GATE WITH BARBED WIRE**  
 SUBMIT TO ENGINEER FOR APPROVAL

PREPARED BY:  
**WIA WIER & ASSOCIATES, INC.**  
 ENGINEERS SURVEYORS LAND PLANNERS  
 4300 BELTWAY PLACE SUITE 130 ARLINGTON, TEXAS 76018 METRO (817)467-7700  
 1380 U.S. HIGHWAY 287 N. SUITE 101 WANSFELD, TEXAS 76063 METRO (817)477-8700  
 8721 5th STREET FRISCO, TEXAS 75034 METRO (214)387-8000  
 www.wierassociates.com

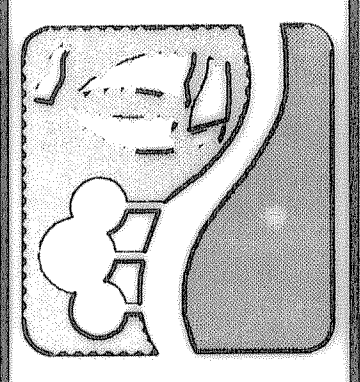

**LONG BRANCH LIFT  
 STATION, FORCE MAIN  
 AND GRAVITY SEWER  
 TO SERVE LOFLAND  
 FARMS PHASE 5B**

**LIFT STATION  
 FENCE DETAILS  
 (PHASE I)**



Copyright ©  
 WIER & ASSOCIATES, INC.  
 LAST SHEET EDIT  
 DATE 10-07-2003  
 WA# 98041  
**SHEET NO.  
 U104**