

ELECTRICAL ABBREVIATIONS

3PDT	3 POLE DOUBLE THROW	NC	NORMALLY CLOSED
A	AMPERE(S)	NEC	NATIONAL ELECTRICAL CODE
AC	ALTERNATING CURRENT	NEMA	NATIONAL ELECTRICAL MANUFACTURERS ASSOCIATION
AFC	ABOVE FINISHED CEILING	NFPA	NATIONAL FIRE PROTECTION ASSOCIATION
AFB	ABOVE FINISHED FLOOR	NFS	NON-FUSED SWITCH
AFG	ABOVE FINISHED GRADE	NIC	NOT IN CONTRACT
AIC	AMPERE INTERRUPTING CAPACITY (ROOT MEAN SQUARE)	NO	NORMALLY OPEN
ALT	ALTERNATE	NTS	NOT TO SCALE
APPROX	APPROXIMATELY	OH	OVERHEAD
ARCH	ARCHITECT	P	POLE(S)
ATS	AUTOMATIC TRANSFER SWITCH	PA	PUBLIC ADDRESS SYSTEM
AUX	AUXILIARY	PF	POWER FACTOR
AWG	AMERICAN WIRE GAGE	PL	PILOT LIGHT
BFC	BELOW FINISHED CEILING	PNL	PANEL
BFG	BELOW FINISHED GRADE	PVC	POLYVINYL CHLORIDE
BLDG	BUILDING	PRC	PVC COATED RIGID CONDUIT
C	CONDUIT	RC	REMOTE CONTROL RECEPTACLE(S)
CB	CIRCUIT BREAKER	REC	RECEPTACLE(S)
CKT	CIRCUIT	RGS	RIGID GALVANIZED STEEL
CLG	CEILING	RVSS	REDUCED VOLTAGE, SOLID STATE
COMM	COMMUNICATIONS	SF	SQUARE FOOT OR FEET
DC	DIRECT CURRENT	SPDT	SINGLE POLE, DOUBLE THROW
DISC	DISCONNECT	SPST	SINGLE POLE, SINGLE THROW
DPDT	DOUBLE-POLE, DOUBLE THROW	SS	START-STOP SWITCH
DPST	DOUBLE-POLE, SINGLE THROW	SW	SWITCH
DWG(S)	DRAWING(S)	SWBD	SWITCHBOARD
EC	EMPTY CONDUIT	TA	TRIP AMPERE(S)
EGS	ENGINE-GENERATOR SET	TEL	TELEPHONE
EHH	ELECTRICAL HANDHOLE	TEMP	TEMPORARY
ELEV	ELEVATION	TJB	TERMINAL J-BOX
EMERG	EMERGENCY	TSW	TWISTED SHIELDED CABLE
EMH	ELECTRICAL MANHOLE	TU	TEXAS UTILITIES ELECTRIC CO.
EMT	ELECTRICAL METAL TUBING	TYP	TYPICAL
EWG	ELECTRICAL WATER COOLER	UG	UNDERGROUND
EX	EXISTING	UL	UNDERWRITERS LABORATORIES, INC.
F	FUSE(S)	UPS	UNINTERRUPTIBLE POWER SUPPLY
FBO	FURNISHED BY OWNER	V	VOLTAGE OR VOLT(S)
FL	FLOOR	VA	VOLT-AMPERE(S)
FLA	FULL LOAD AMPERE(S)	W	WATT(S)
FLEX	FLEXIBLE	WP	WEATHERPROOF
FS	FUSIBLE SWITCH	W	WITH
FVNR	FULL VOLTAGE, NON-REVERSING	W/O	WITHOUT
G	GROUND CONDUCTOR	XFMR	TRANSFORMER
GEC	GROUNDING ELECTRODE CONDUCTOR	XP	EXPLOSION-PROOF
GFI	GROUND FAULT CIRCUIT INTERRUPTOR	Δ	DELTA
GND	GROUND/GROUNDING/GROUNDED	#	NUMBER
HID	HIGH INTENSITY DISCHARGE	∅	PHASE(S)
HOA	HAND-OFF-AUTOMATIC		
HP	HORSEPOWER		
HZ	HERTZ		
IG	ISOLATED GROUND		
IMC	INTERMEDIATE METALLIC CONDUIT		
JBOX	JUNCTION BOX		
KA	KILOAMPERE(S)		
KW	KILOWATT(S)		
KWH	KILOWATT-HOUR(S)		
KV	KILOVOLT		
KVA	KILOVOLT-AMPERE(S)		
KVAR	KILOVOLT-AMPERE(S) REACTIVE		
LPS	LOW PRESSURE SODIUM		
LTG	LIGHTING		
M	METER(S)		
MAX	MAXIMUM		
MCB	MAIN CIRCUIT BREAKER		
MCC	MOTOR CONTROL CENTER		
MCP	MOTOR CIRCUIT PROTECTOR		
MH	METAL HALIDE		
MIN	MINIMUM		
MLO	MAIN LUGS ONLY		

ELECTRICAL CONVENTIONS

(ALL CONVENTIONS MAY NOT APPEAR ON DRAWINGS.)

GENERAL NOTES APPLY TO ELECTRICAL DRAWING SET.
 DRAWING NOTES APPLY TO DRAWING ON WHICH NOTE APPEARS.
 SYMBOL NOTES APPLY TO DRAWING ON WHICH AND WHERE SYMBOL APPEARS.
 WIRE SIZES ARE INDICATED BY AMERICAN WIRE GAGE OR CIRCULAR MILS.

LB-3,5 — PANELBOARD, SWITCHBOARD OR MOTOR CONTROL CENTER DESIGNATION; ARROWHEADS INDICATE NUMBER OF BRANCH CIRCUITS

BRANCH CIRCUIT HOMERUN TO PANELBOARD, SWITCHBOARD OR MOTOR CONTROL CENTER; ARROWHEADS INDICATE NUMBER OF BRANCH CIRCUITS

WIRE AND RACEWAY RUN CONCEALED IN WALL OR CEILING (3-#12 IN 3/4" RACEWAY UNLESS OTHERWISE NOTED)

WIRE AND RACEWAY RUN CONCEALED IN WALL OR CEILING (3-#12 IN 3/4" RACEWAY UNLESS OTHERWISE NOTED)

WIRE AND RACEWAY RUN CONCEALED IN OR BELOW SLAB OR BELOW GRADE (3-#12 IN 3/4" RACEWAY UNLESS OTHERWISE NOTED)

FOR LIGHTING BRANCH CIRCUITS, QUANTITY OF WIRE AND SIZE OF RACEWAY SHALL BE INCREASED AS REQUIRED TO FACILITATE INDICATED SWITCHING AND EMERGENCY LIGHTING OPERATION.

HEAVY WEIGHT LINES INDICATE REMOVAL WORK ON DEMOLITION DRAWINGS AND NEW WORK ON NEW WORK DRAWINGS UNLESS OTHERWISE NOTED.

LIGHT WEIGHT LINES INDICATE EXISTING CONDITIONS UNLESS OTHERWISE NOTED.

2 — NUMBER OR LETTER INDICATES ELEVATION OR SECTION

E2 — SHEET NUMBER WHERE ELEVATION OR SECTION IS TAKEN OR DRAWN

CENTER LINE

DISCONNECT SWITCH

NUMBER OF POLES
 RATING OF SWITCH
 RATING OF FUSES OR NON-FUSIBLE
 NEMA ENCLOSURE TYPE.


3P/60A/NF/3R

LEGEND

- ⊖ — NEMA 5-20R DUPLEX RECEPTACLE MOUNTED AT 18" A.F.F. OR AS NOTED
- ⊖ — NEMA 5-20R GROUND FAULT INTERRUPTING DUPLEX RECEPTACLE MOUNTED 18" A.F.F. OR AS NOTED.
- ⊖ — SINGLE POLE TOGGLE SWITCH MOUNTED AT 48" A.F.F.
- ⊖ — ELECTRICAL PANELBOARD
- ⊖ — MOTOR: NUMBER IN CENTER INDICATES HORSEPOWER
- ⊖ — COMBINATION DISCONNECT SWITCH/MOTOR STARTER
- ⊖ — NON FUSED DISCONNECT SWITCH
- ⊖ — FUSED DISCONNECT SWITCH
- ⊖ — FUSE RATING
 SWITCH RATING
- ⊖ — CIRCUIT BREAKER
 FRAME
- ⊖ — TRIP RATING
- ⊖ — NORMALLY CLOSED CONTACT
- ⊖ — NORMALLY OPEN CONTACT
- ⊖ — DRAW-OUT CONTACTS
- ⊖ — LIMIT SWITCH-NORMALLY OPEN SHOWN
- ⊖ — MOMENTARY OFF PUSHBUTTON
- ⊖ — MOMENTARY ON PUSHBUTTON
- ⊖ — MAINTAINED PUSHBUTTON
- ⊖ — N.O. FLOAT SWITCH
- ⊖ — FLOW SWITCH
- ⊖ — N.O.T.C. (NORMALLY OPEN TIMED CLOSE)
- ⊖ — TEMPERATURE SWITCH
- ⊖ — LIQUID LEVEL SWITCH (FLOAT SWITCH)
- ⊖ — CURRENT TRANSFORMER
- ⊖ — FUSE
- ⊖ — GROUND
- ⊖ — OVERLOADS
- ⊖ — CIRCUIT BREAKER
- ⊖ — SURGE OR PF CAPACITOR
- ⊖ — LIGHTNING ARRESTER
- ⊖ — SWITCH
- ⊖ — TRANSFORMER
- ⊖ — CONDUIT EMBEDDED IN CONCRETE OR BELOW GRADE
- ⊖ — EXPOSED CONDUIT
- ⊖ — IDENTIFICATION TAG RELATING TO RISER DIAGRAM
- ⊖ — NOTE "?" BY SYMBOL
- ⊖ — WIRING OR EQUIPMENT SHOWN TO BE REMOVED ON ONE-LINE DIAGRAM
- ⊖ — PLC INPUT NO.1
- ⊖ — PLC OUTPUT NO.1

ELECTRICAL ABBREVIATIONS, CONVENTIONS, AND LEGEND

CAMPOS ENGINEERING, INC.
 CONSULTING ENGINEERS
 7430 Greenville Avenue
 Dallas, Texas 75231
 (214) 991-8298 (FAX)
 E-MAIL: campos@camposengineering.com
 PROJECT NO: 04399.00

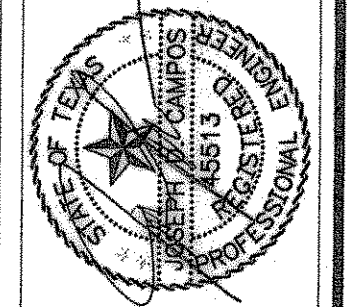

THE SEAL APPEARING ON THIS DOCUMENT WAS AUTHORIZED BY JOSEPH D. CAMPOS TEXAS P.E. NO. 45513 ON 1-17-00

DOUPHRATE & ASSOCIATES, INC.
 ENGINEERING • PROJECT MANAGEMENT • SURVEYING
 2231 RIDGE RD., # 200 ROCKWALL, TEXAS 75087
 PHONE: (972)771-9004 FAX: (972)771-9005

ELECTRICAL ABBREVIATIONS, CONVENTIONS AND LEGEND

RECORD DRAWINGS:
 THE INTENT OF THE OWNER AND ENGINEER WAS TO CONSTRUCT THESE FACILITIES ACCORDING TO THESE PLANS AS APPROVED BY THE CITY OF Rockwall. THE LINES AND GRADES WERE SET ON THE GROUND FOR CONSTRUCTION ACCORDING TO SAID PLANS. THE CITY OF Rockwall INSPECTED THE CONSTRUCTION. THE OWNER NOR ENGINEER DID NOT VERIFY LINES OR GRADES AFTER CONSTRUCTION. WE ARE NOT AWARE OF ANY CHANGES OR REVISIONS TO THESE PLANS DURING CONSTRUCTION EXCEPT AS NOTED

REVISION	
WLD.	CHECKED
KEB.	DRAWN
1/28/98	DATE
972MA	PROJECT
E1	