



**PUMP 3 CONTROL SCHEMATIC**

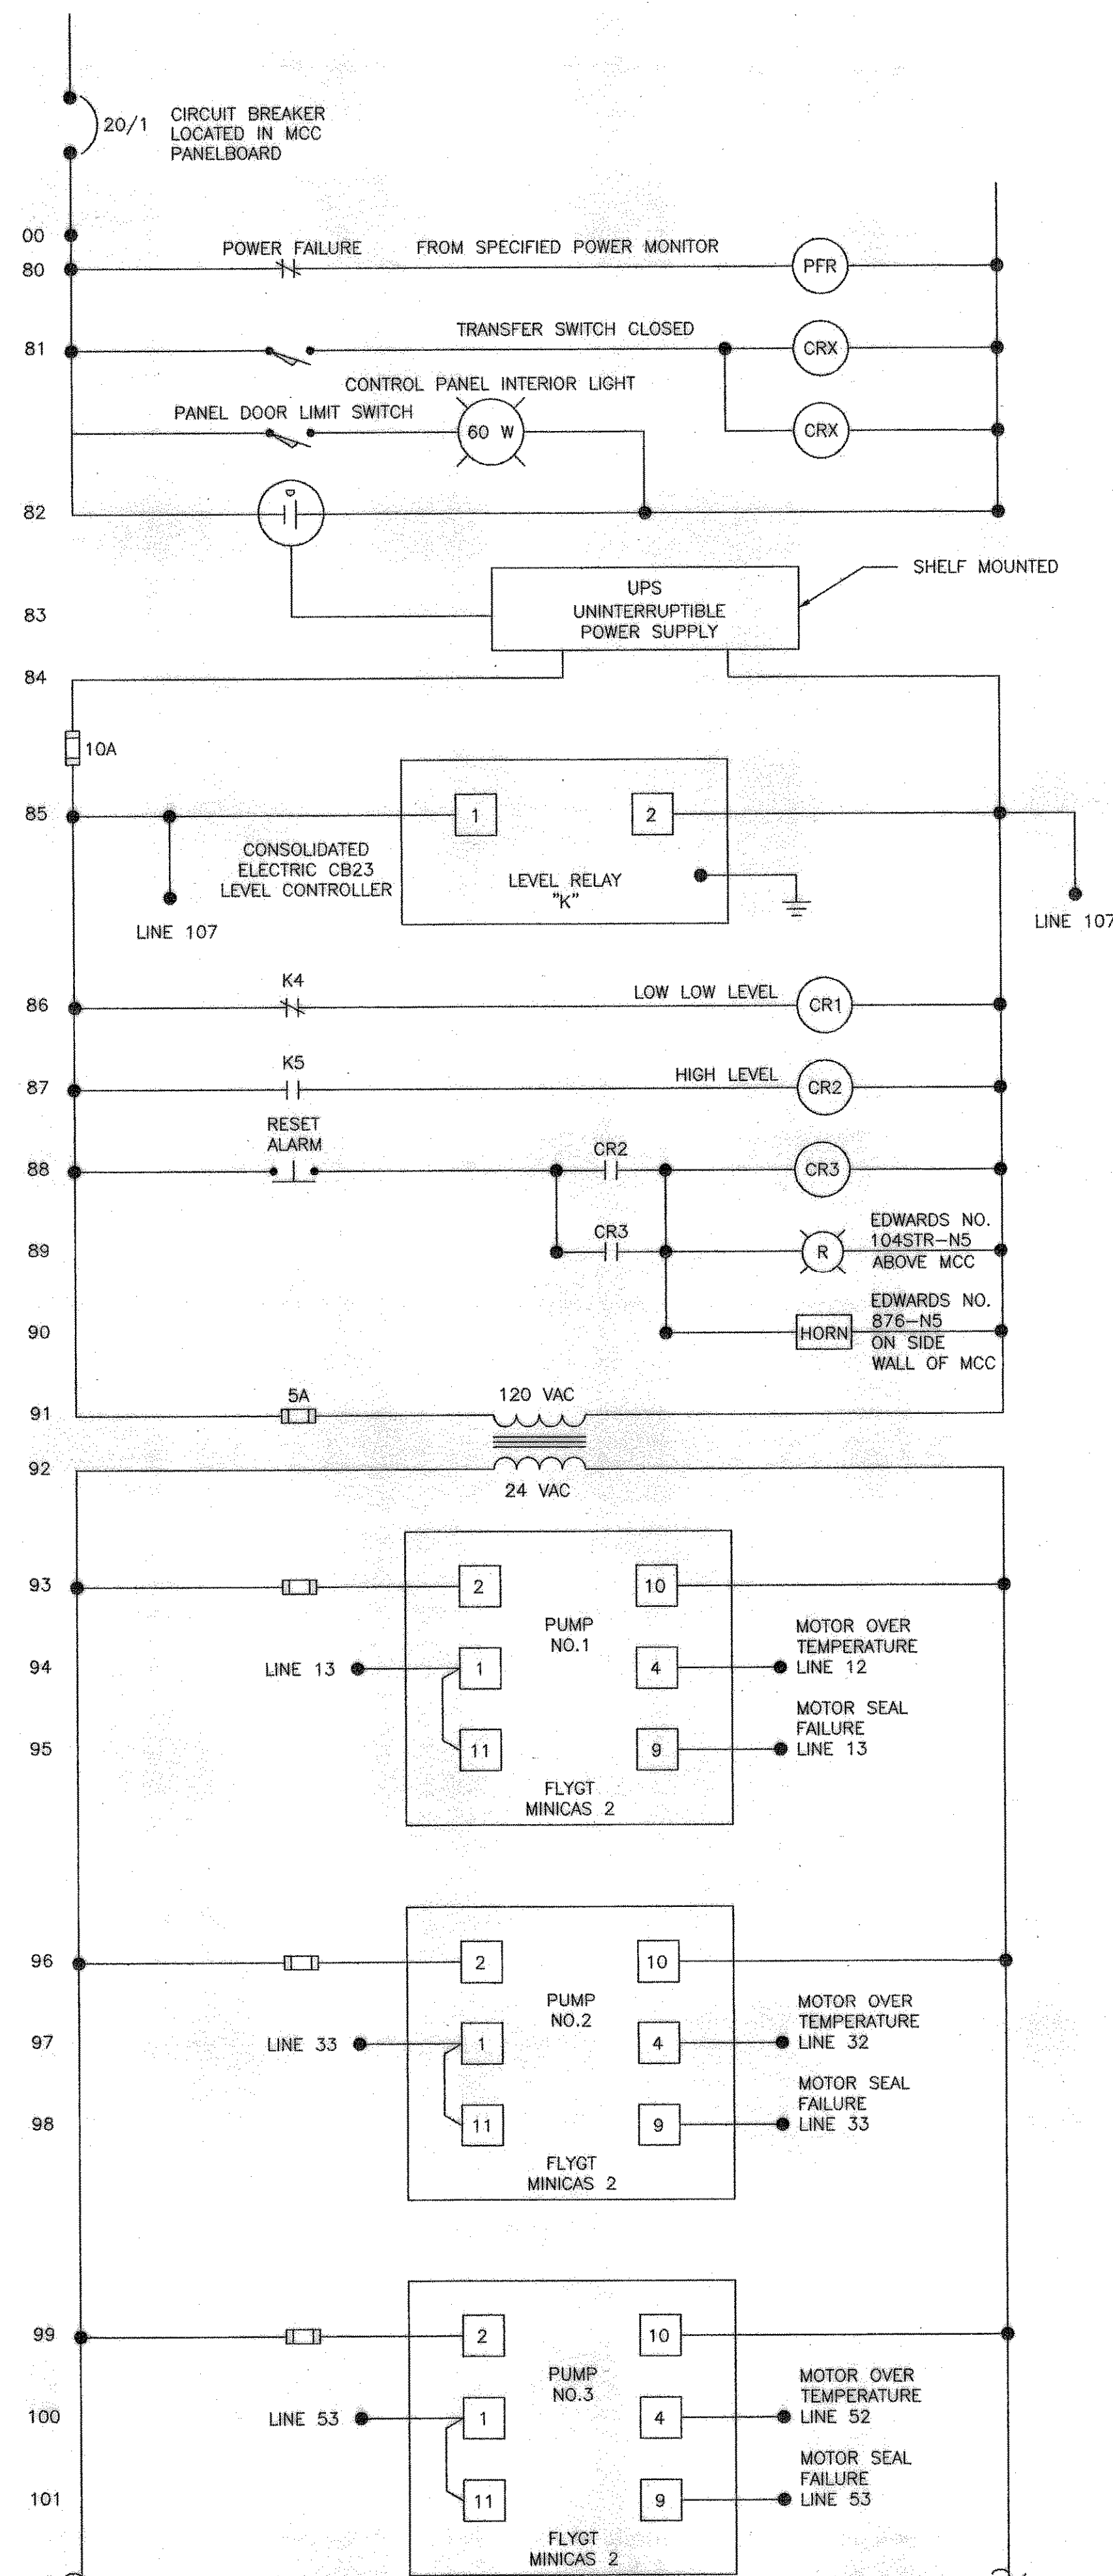

**LIFT STATION ALARM AND SCADA SCHEMATIC**

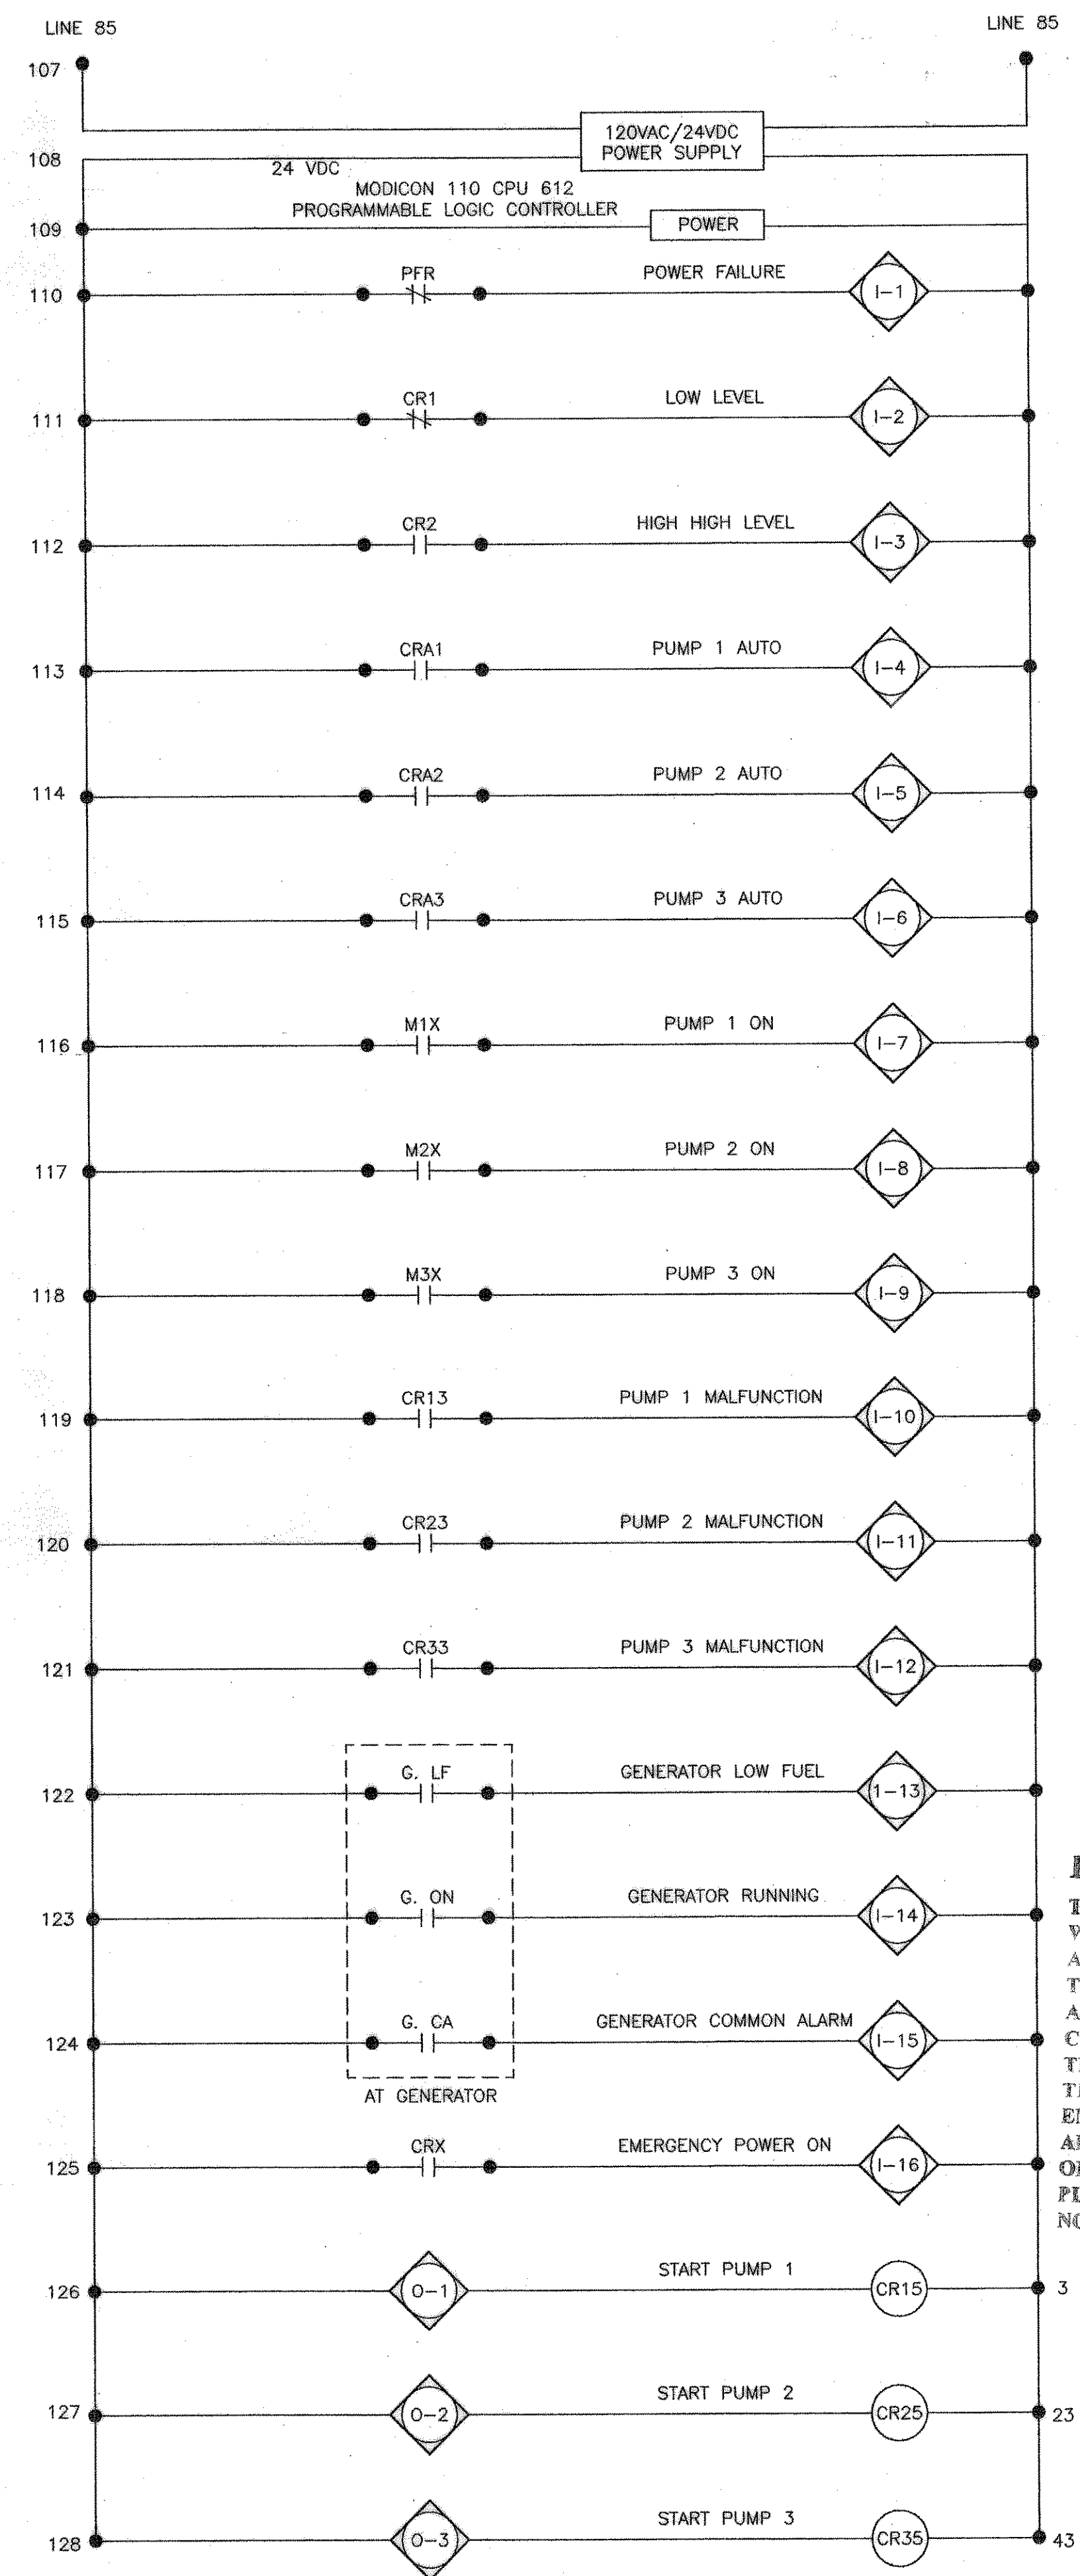

**PROGRAMMABLE LOGIC CONTROLLER SCHEMATIC WIRING**

**RECORD-DRAWINGS:**

THE INTENT OF THE OWNER AND ENGINEER WAS TO CONSTRUCT THESE FACILITIES ACCORDING TO THESE PLANS AS APPROVED BY THE CITY OF Rockwall. THE LINES AND GRADES WERE SET ON THE GROUND FOR CONSTRUCTION ACCORDING TO SAID PLANS. THE CITY OF Rockwall INSPECTED THE CONSTRUCTION. THE OWNER NOR ENGINEER DID NOT VERIFY THE GRADES AFTER CONSTRUCTION. WE ARE NOT AWARE OF ANY CHANGES OR REVISIONS TO THESE PLANS DURING CONSTRUCTION EXCEPT AS NOTED.

THE SEAL APPEARING ON THIS DOCUMENT WAS AUTHORIZED BY JOSEPH D. CAMPOS TEXAS P.E. NO. 40513 ON 1-17-00


DOUPHRATE & ASSOCIATES, INC.  
ENGINEERING • PROJECT MANAGEMENT • SURVEYING  
2231 RIDGE RD., # 200 ROCKWALL, TEXAS 75087  
PHONE: (972) 771-9004 FAX: (972) 771-9005

**SCHEMATICS 2**

REVISION	DATE	BY
WLD.		
CHECKED		
KER.		
DRAWN		
1/28/98		
DATE		
972MA		
PROJECT		

**E6**

CAMPOS ENGINEERING, Inc.  
CONSULTING ENGINEERS  
1300 Greenville Avenue, Suite 1300  
Rockwall, Texas 75087  
(972) 968-6291  
(972) 968-6292  
PROJECT NO. 94399.00

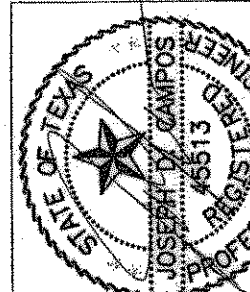

THE SEAL APPEARING ON THIS DOCUMENT WAS AUTHORIZED BY JOSEPH D. CAMPOS TEXAS P.E. NO. 40513 ON 1-17-00

DOUPHRATE & ASSOCIATES, INC.  
ENGINEERING • PROJECT MANAGEMENT • SURVEYING  
2231 RIDGE RD., # 200 ROCKWALL, TEXAS 75087  
PHONE: (972) 771-9004 FAX: (972) 771-9005

**SCHEMATICS 2**

REVISION	DATE	BY
WLD.		
CHECKED		
KER.		
DRAWN		
1/28/98		
DATE		
972MA		
PROJECT		

**E6**

1/19/02

1/19/02

1/19/02

1/19/02