

CITY OF ROCKWALL

" THE NEW HORIZON "


MYERS PARK WATER LINE

MAYOR
Ken Jones

CITY COUNCIL

Bob Cotti
Tim McCallum
Terry Raulston
John King
Billy Morris
Larry Dobbs

PROJECT

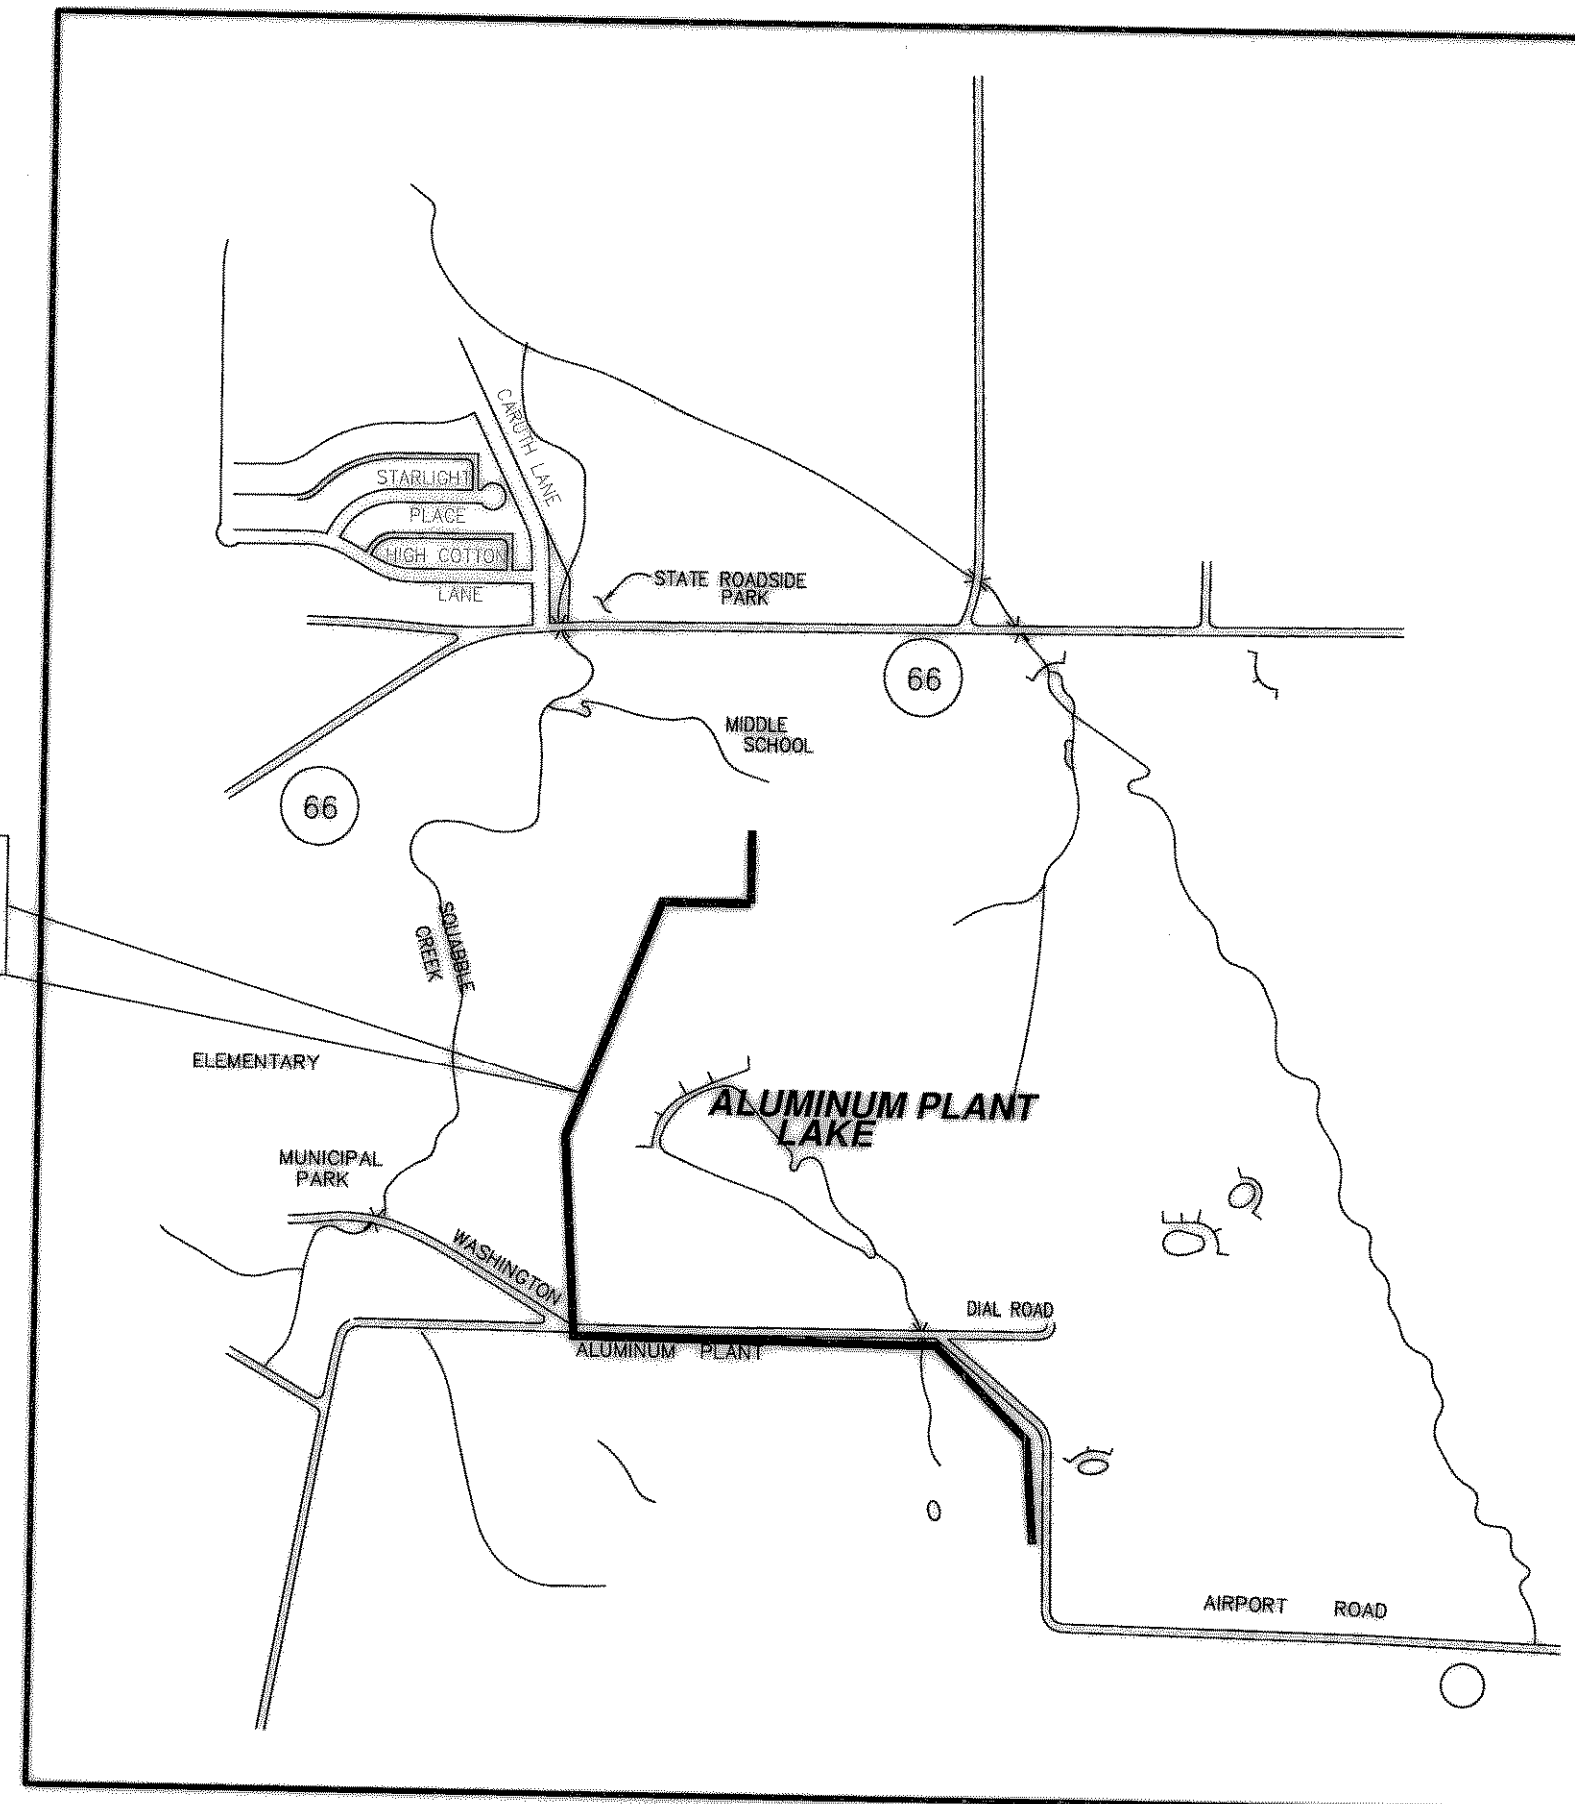


CONTRACTOR SHALL OBTAIN COPIES OF THE LATEST CITY OF ROCKWALL STANDARD DETAILS AND NORTH CENTRAL TEXAS COUNCIL OF GOVERNMENT STANDARD SPECIFICATIONS FOR PUBLIC WORKS CONSTRUCTION WITH ROCKWALL AMENDMENTS. CONTRACTOR SHALL HAVE ONE COPY ON THE PROJECT AT ALL TIMES.

INDEX OF DRAWINGS

SHEET NO.	TITLE
C	COVER SHEET
1	WATER PLAN STA. 0+00 TO 14+00 LINE "A"
2	WATER PLAN STA. 14+00 TO 25+06.17 LINE "A"
	WATER PLAN STA. 0+00 TO 5+00 LINE "B"
3	WATER PLAN STA. 5+00 TO 20+00 LINE "B"
4	NOTES


NOTE:

CONTRACTOR TO VERIFY IN THE FIELD THE LOCATION OF ALL EXISTING UTILITIES PRIOR TO CONSTRUCTION. INFORMATION PROVIDED WITHIN THESE PLANS DOES NOT RELIEVE THE CONTRACTOR OF THE FULL AND TOTAL RESPONSIBILITY FOR THE PROTECTION OF EXISTING UTILITIES NOR ANY DAMAGES CAUSED BY SAID CONTRACTOR DURING CONSTRUCTION.

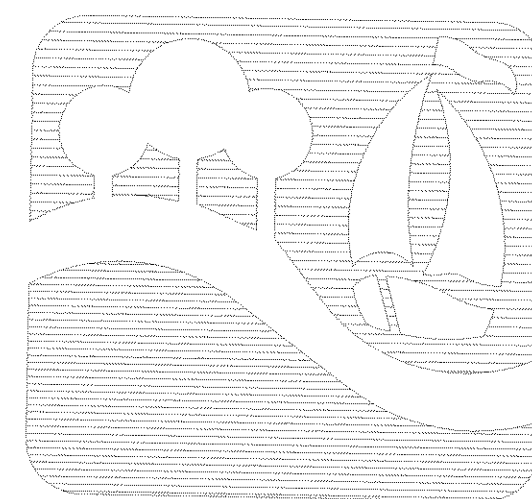

ROCKWALL, TEXAS

THE SEAL APPEARING ON THIS DOCUMENT WAS AUTHORIZED BY CHARLES A. TODD TEXAS P.E. NO. 55647 ON

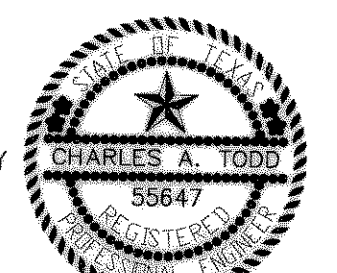

Charles A. Todd
11-3-03