
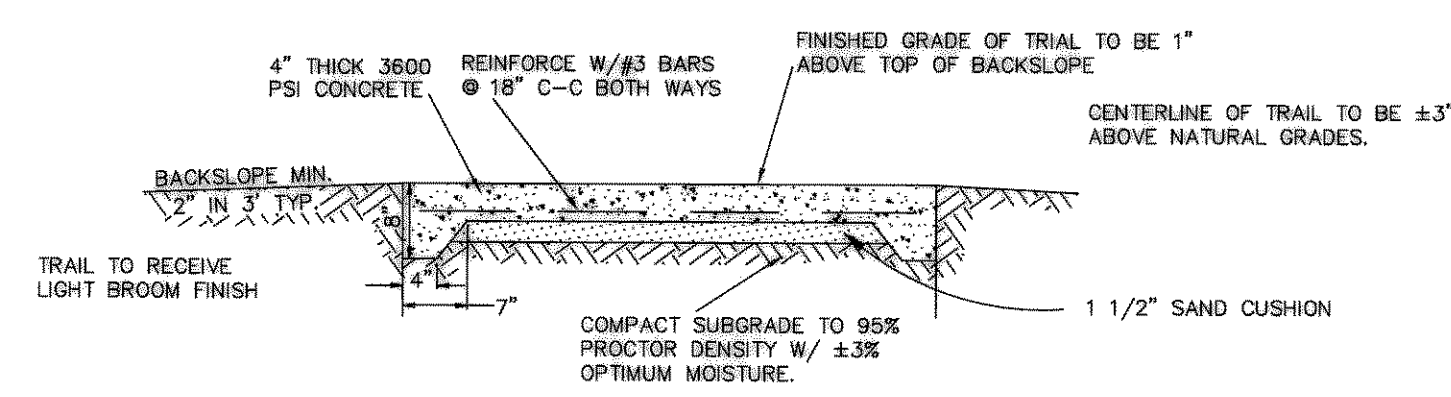


- NOTE:**
1. THE GENERAL CONTRACTOR AND ALL SUB-CONTRACTORS SHALL VERIFY THE SUITABILITY OF ALL EXISTING AND PROPOSED SITE CONDITIONS INCLUDING GRADES AND DIMENSIONS BEFORE COMMENCEMENT OF ANY CONSTRUCTION. IN THE EVENT OF ANY CONFLICT AND PRIOR TO COMMENCEMENT OF ANY CONSTRUCTION IMMEDIATELY NOTIFY ENGINEER. MINOR ADJUSTMENTS OF FINISH GRADE TO ACCOMPLISH SPOT DRAINAGE ARE ACCEPTABLE, IF NECESSARY, UPON PRIOR APPROVAL OF ENGINEER.
 2. THE CONTRACTOR SHALL BE RESPONSIBLE FOR LOCATING ALL EXISTING STRUCTURES, UTILITIES, AND SERVICES PRIOR TO EXCAVATION AND CONSTRUCTION.
 3. THE CONTRACTOR SHALL BE RESPONSIBLE FOR COORDINATING WITH UTILITY COMPANIES FOR THE RELOCATION OF ANY EXISTING UTILITIES.
 4. THE CONTRACTOR SHALL USE ALL NECESSARY PRECAUTIONS TO AVOID CONTACT WITH OVERHEAD AND UNDERGROUND POWER LINES.
 5. CONTRACTOR SHALL REPLACE ALL SIGNAGE AND MAILBOXES THAT HAVE TO BE REMOVED DURING CONSTRUCTION.
 6. CONTRACTOR IS RESPONSIBLE FOR RESTORING EXISTING CONDITIONS TO ALL DISTURBED AREAS (GRASS, PAVING, ROCK, ASPHALT, ETC)
 7. LINE "B" (THROUGH THE PARK) THE CONTRACTOR SHALL DEVIATE FROM ORIGINAL ALIGNMENT ONE TO TWO FEET AS NEEDED TO MISS TREES, IF MORE DEVIATION IS NEEDED CALL PROJECT ENGINEER.
 8. ALL WATERLINE TO BE C900 CLASS 200 PVC.
 9. CONTRACTOR TO FURNISH TRAFFIC CONTROL PLAN.

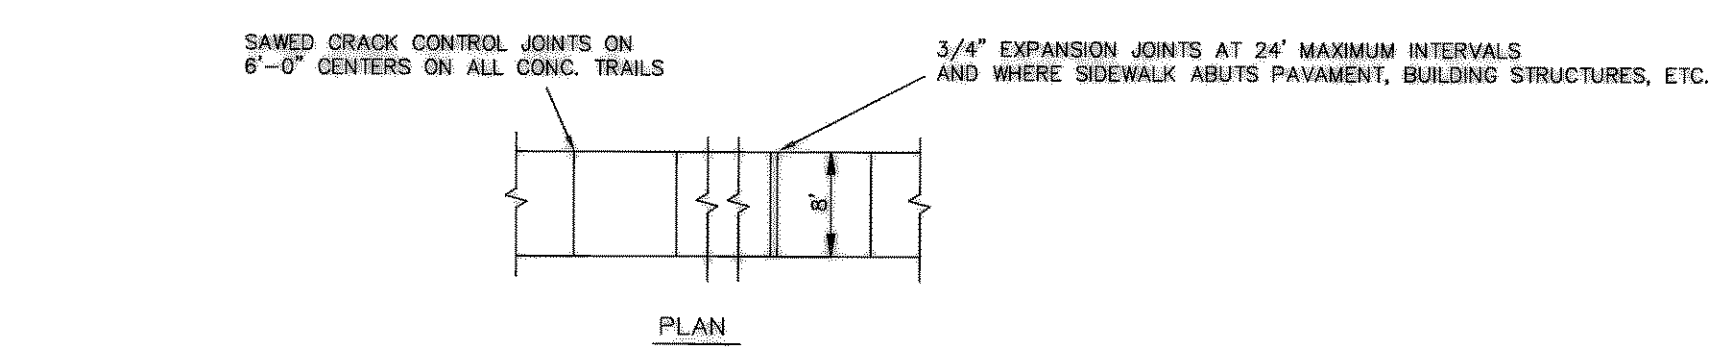

NOTE: CROSS SLOPE OF TRAIL TO BE ±1% WITH TERRAIN BUT NOT TO EXCEED 2%
 RUNNING SLOPE OF TRAIL TO BE LESS THAN 5% IN ALL AREAS
 ALTER TRAIL SECTION ELEVATION TO ALLOW CROSS DRAINAGE AS INSTRUCTED BY THE ENGINEER.

CONCRETE TRAIL DETAIL
 N.T.S.

LINE "B" STA. 5+00 TO 20+00
12" WATER LINE
 ROCKWALL, TEXAS
 CITY OF ROCKWALL
 "THE NEW HORIZON"

REVISION NO.	REMARKS	DATE

DESIGNED: A.J.W.	THE SEAL APPEARING ON THIS DOCUMENT WAS AUTHORIZED BY CHARLES A. TODD TEXAS P.E. NO. 55647 ON
DRAWN: ACAD	
JOB NO.	
DATE: 7/29/03	SHEET NO. 3 of 4

