


- LEGEND**
- POWER POLE
 - TELEPHONE BOX
 - TELEPHONE M.H.
 - GAS METER
 - FIRE HYDRANT
 - WATER METER
 - WATER VALVE
 - SOIL. SEWER M.H.

NOTE: ALL CONSTRUCTION TO CONFORM TO CITY OF ROCKWALL STANDARDS

NOTE: ALL STORM SEWER TO BE CLASS III REINFORCED CONCRETE PIPE

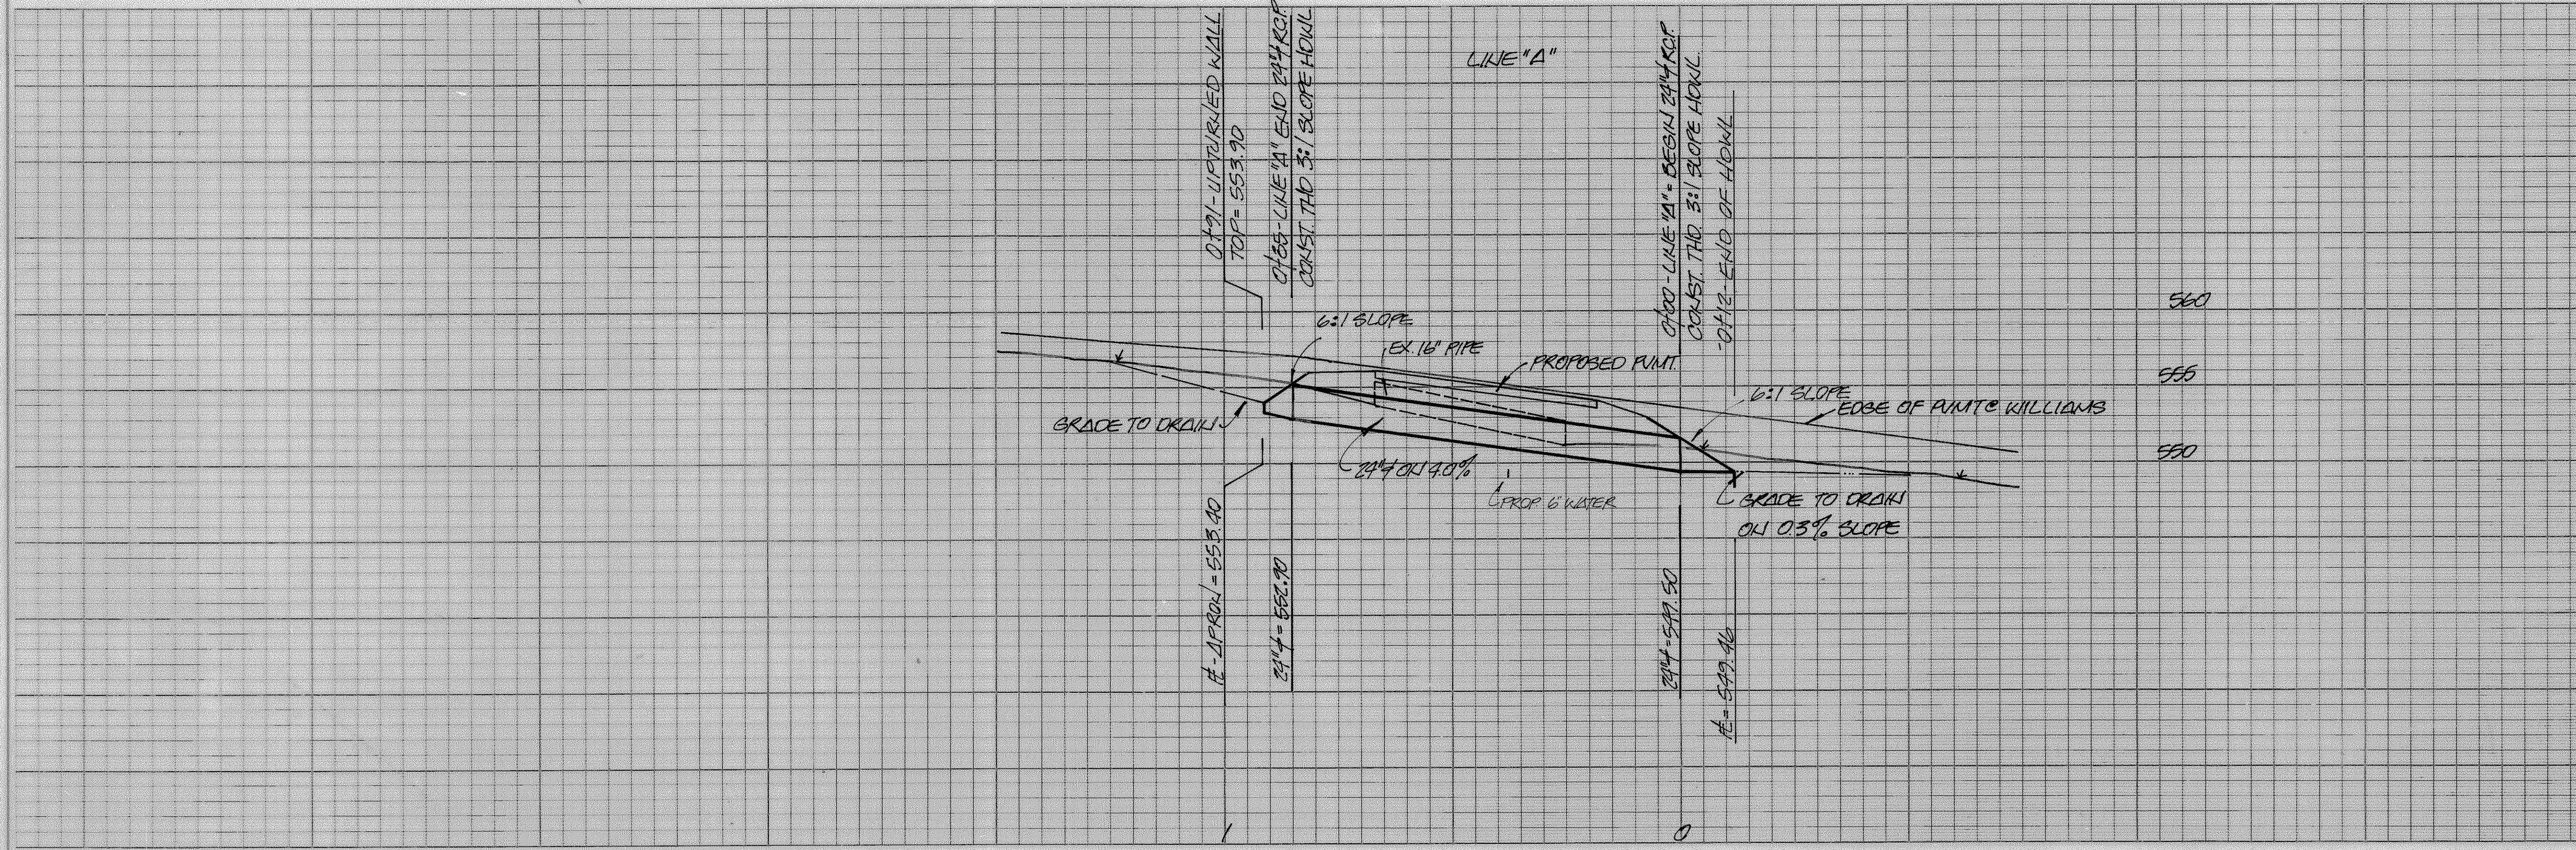

BENCH MARK:
R.S. 567.14 PIP ON S.E. COR.
14 FT. OF E. WILLIAMS & S. CLARK
ELEV. 562.73

REVISION: 6/23/87
REVISED 3:1 TO 6:1 O&I SLOPE
HOWL & ADDED UP-TURNED WALL

REVISION NO.	REMARKS	DATE
DRAINAGE IMPROVEMENTS NASH STREET		
CITY OF ROCKWALL, TEXAS 205 W. RUSK STREET 214-722-1111		
DESIGNED: W.L.D.	SCALE: NOTED	
DRAWN: W.L.D.	APPROVED: <i>W.L. Doughty II</i>	
JOB NO: 87002	DATE: 3-87	SHEET NO: 29

