

NOTE: STREET CONSTRUCTION - 6" 3000 P.S.I. CONCRETE W/ #3 BARS 24" C.C. EA. WAY ON 6" STABILIZED LIME SUBGRADE W/ A MIN. OF 7% LIME.
 ALTERNATE - 6" H.M.A.C. (4" TYPE "B" & 2" TYPE "D") W/ 24" CURB & GLITTER (3000 P.S.I. CONCRETE) ON 8" STABILIZED LIME SUBGRADE W/ A MIN. OF 8% LIME

NOTE: ALL PROPOSED DRIVE APPROACHES SHALL BE 12' WIDE & EXTENDED TO R.O.W. LINE EXCEPT AS NOTED ON PLANS. DRIVES SHALL BE CONSTRUCTED OF 6" 3000 P.S.I. CONCRETE REINFORCED W/ #3 BARS 24" C.C. BOTH WAYS

NOTE: ALL RADIUS ON DRIVES WILL BE 5' EXCEPT AS NOTED ON PLANS

NOTE: ALL UNDERGROUND UTILITIES TO BE RELOCATED OR ADJUSTED TO NEW PAVEMENT OR PARKWAY GRADE PRIOR TO ANY PAVEMENT CONSTRUCTION.


NOTE: ALL EXISTING DRAINAGE PIPES TO BE REMOVED & SALVAGED EXCEPT AS NOTED ON THE STORM SEWER DESIGN PLANS.

NOTE: POWER POLES & TELEPHONE BOXES TO BE RELOCATED BY OTHERS PRIOR TO CONSTRUCTION


NOTE: ALL CONSTRUCTION SHALL MEET CITY OF ROCKWALL SPECIFICATIONS

NOTE: REMOVE & RECONSTRUCT EXISTING SIDEWALKS AS REQUIRED TO CONSTRUCT NEW DRIVEWAYS

NOTE: CONTRACTOR SHALL HAVE ONE LANE REMAINED OPEN FOR TRAFFIC AT ALL TIMES

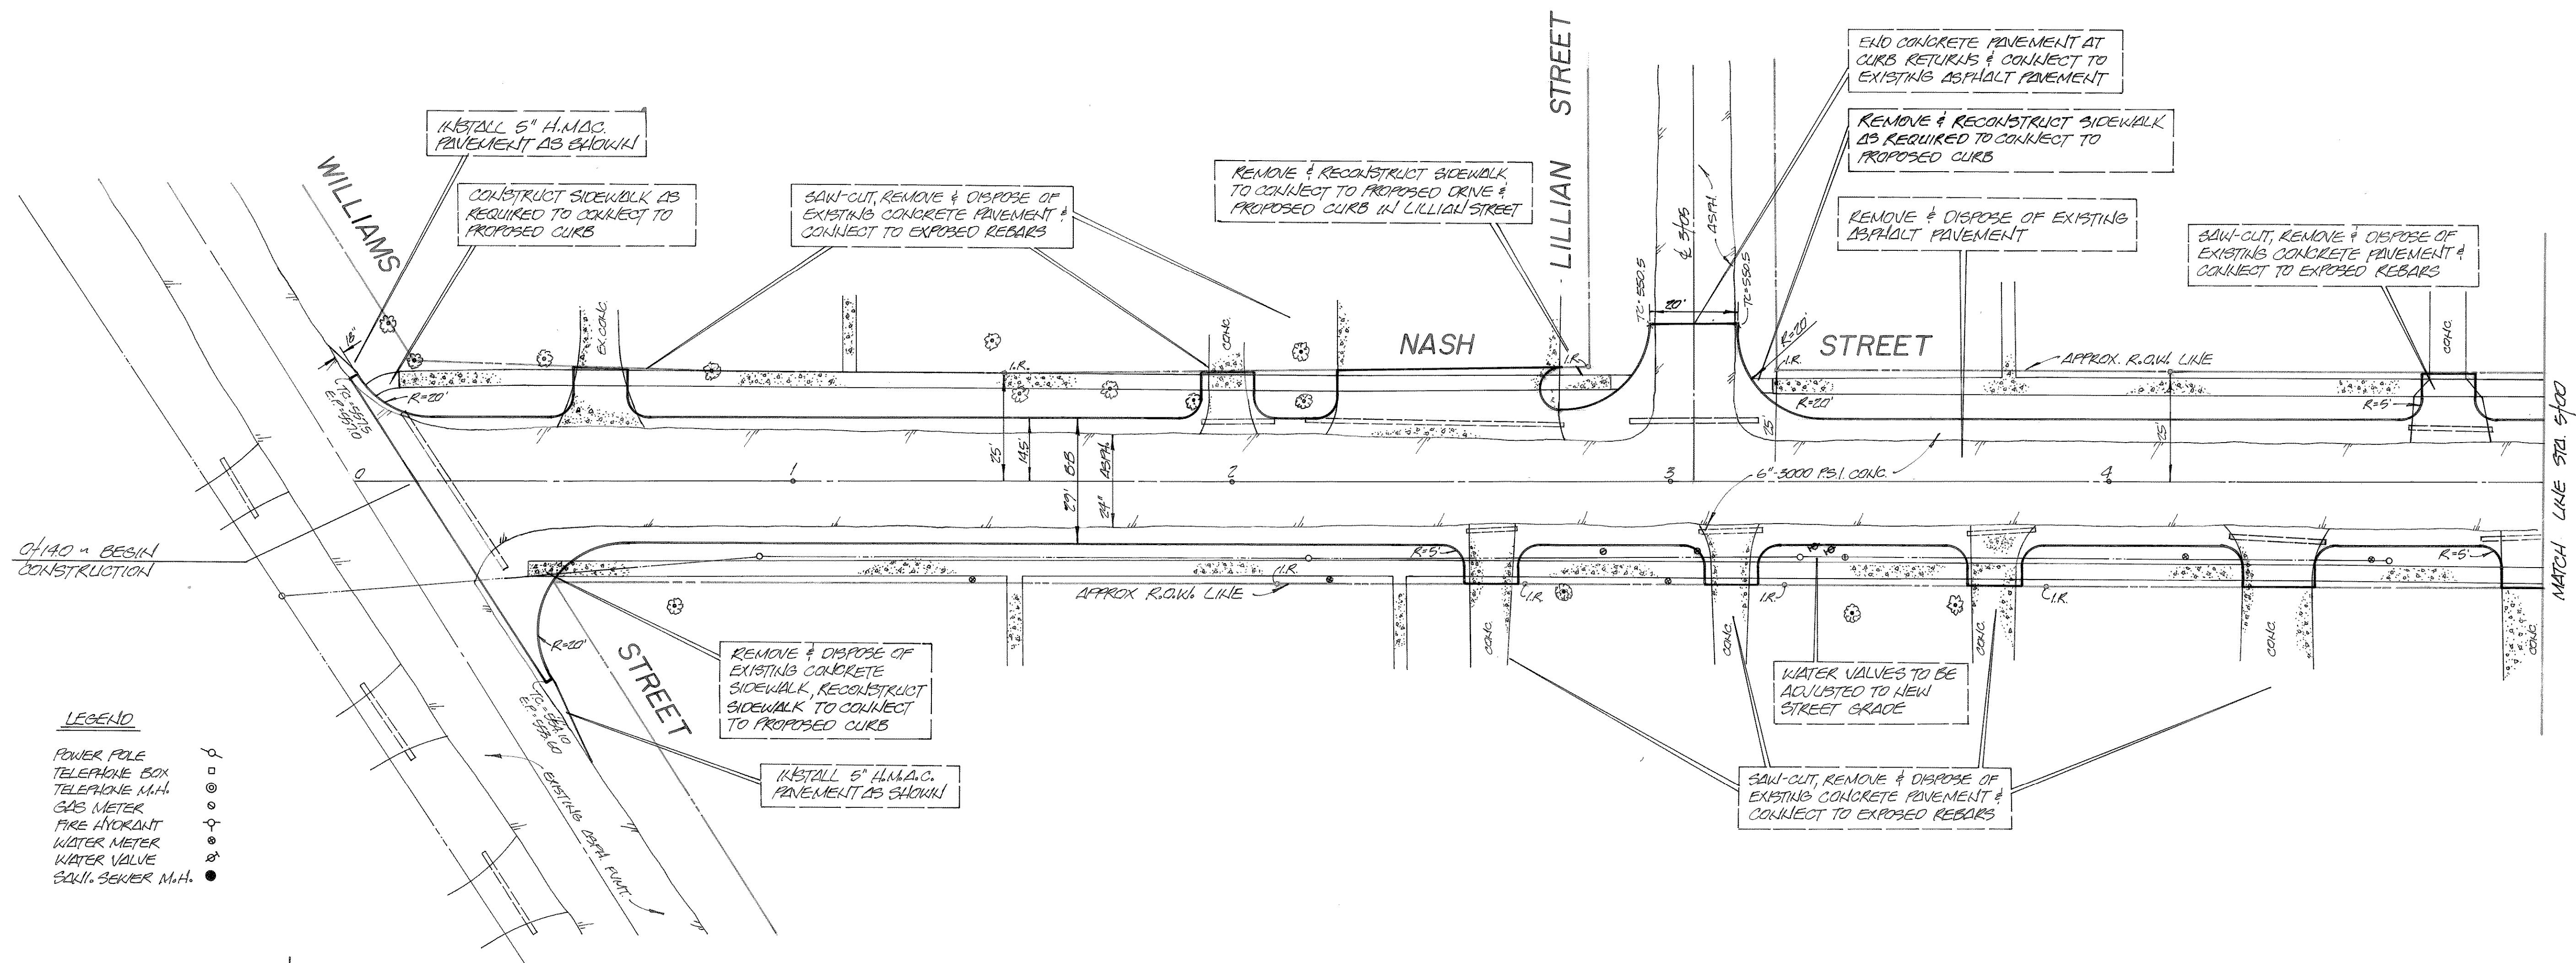

LEGEND
 POWER POLE
 TELEPHONE BOX
 TELEPHONE M.H.
 GAS METER
 FIRE HYDRANT
 WATER METER
 WATER VALVE
 EQUI. SEWER M.H.

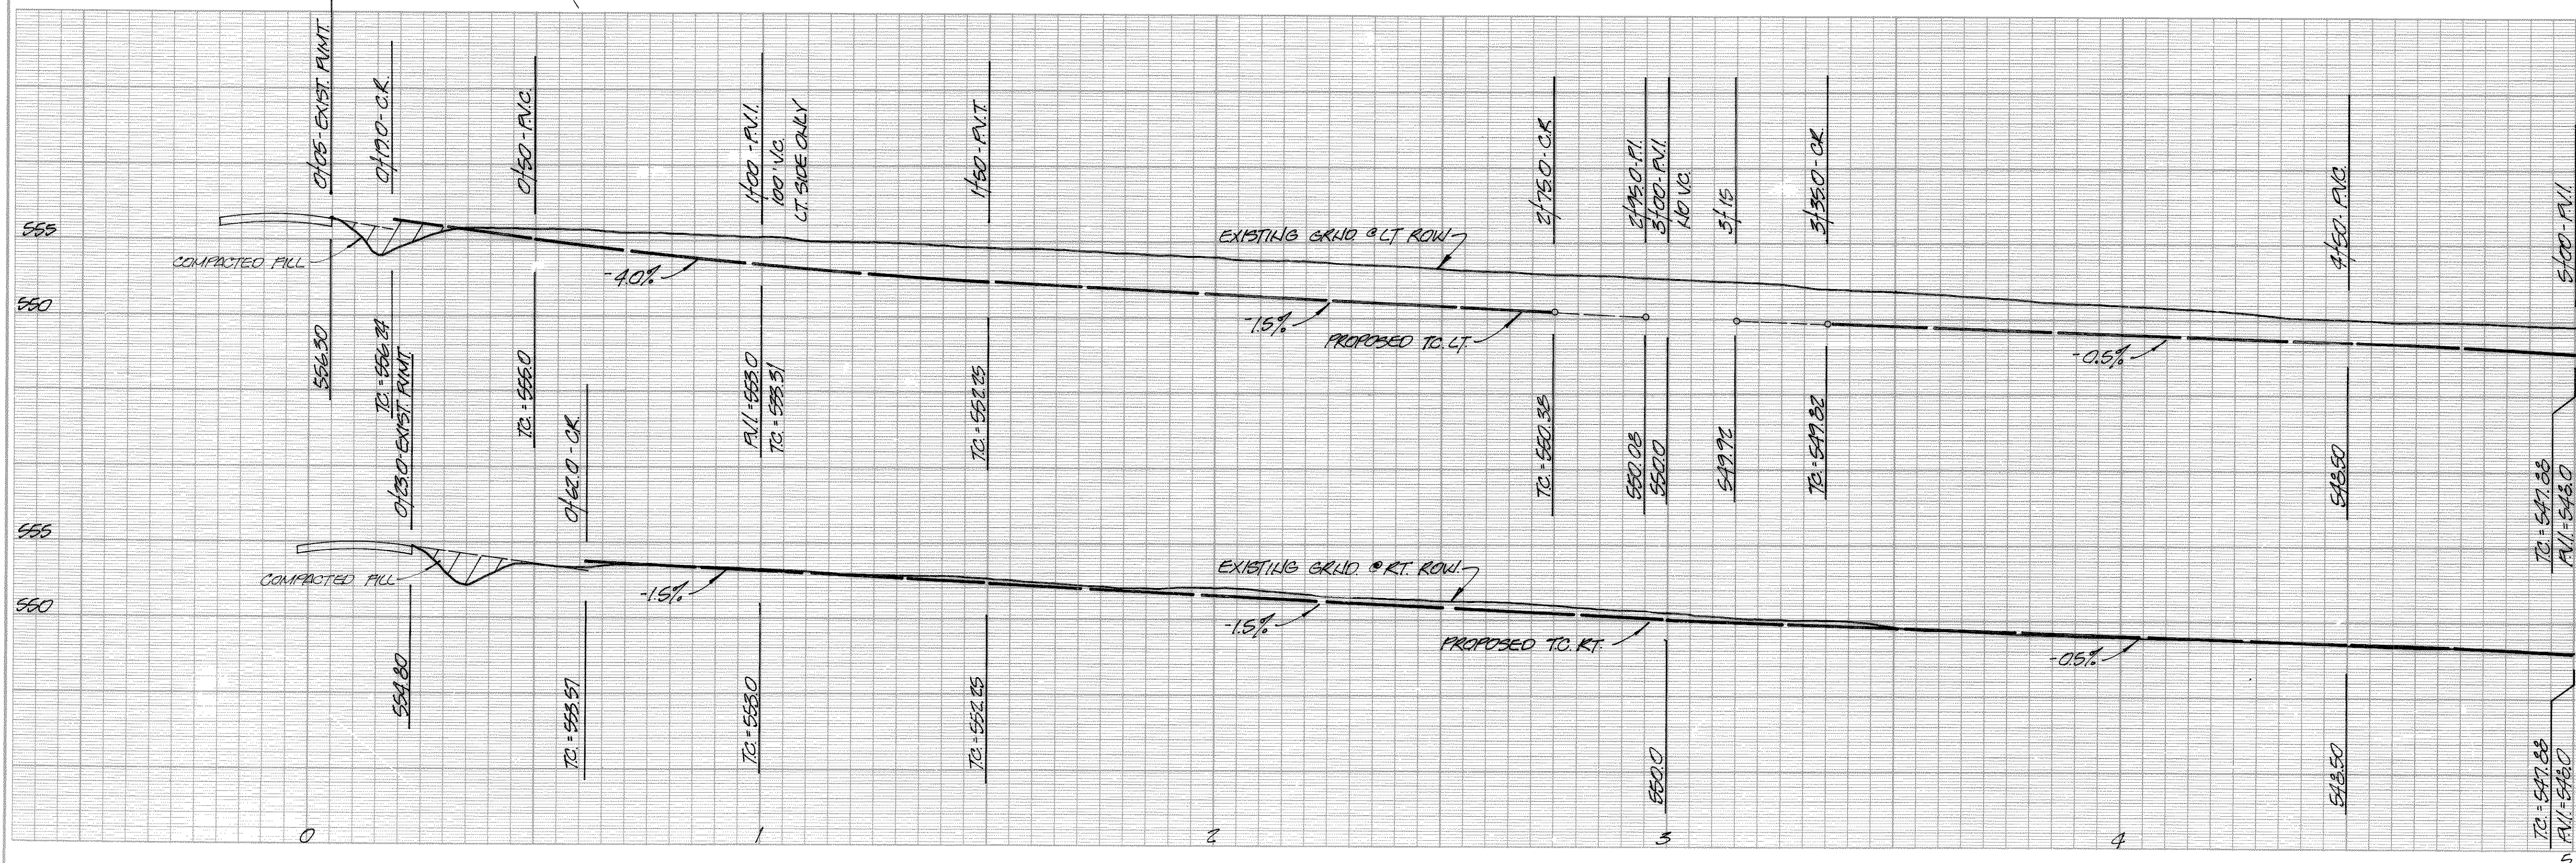

BENCH MARK:
 CR. MARK IN RR ON SE. COR.
 INT. OF E. WILLIAMS & B. OF CLARK
 ELEV. = 562.93

SCALE: 1" = 20' H
 1" = 8' V

REVISION NO.	REMARKS	DATE
PAVING IMPROVEMENTS NASH STREET		
CITY OF ROCKWALL, TEXAS 205 W. RUSK STREET 214-782-1111		
DESIGNED:	SCALE:	NOTE
W.L.D.		
DRAWN:	APPROVED:	
W.L.D.	<i>W.L. Douphrate II</i>	
JOB NO. 87002	DATE: 3-87	SHEET NO. 25

