

CITY OF ROCKWALL, TEXAS

CONSTRUCTION PLANS FOR

NEIGHBORHOOD DRAINAGE IMPROVEMENTS PHASE 2

COUNCIL MEMBERS

BILL CECIL, MAYOR
CLIFF SEVIER, MAYOR PRO-TEM
GLEN FARRIS
MARGO NIELSEN
MARK RUSSO
MATT SCOTT
DAVID SWEET

CITY MANAGER

JULIE COUCH

ASSISTANT CITY MANAGER

RICHARD CROWLEY

CITY ENGINEER

CHUCK TODD, P.E.




BIRKHOFF, HENDRICKS & CONWAY, L.L.P.
CONSULTING ENGINEERS
Dallas, Texas

SEPTEMBER 2008

This record drawing is a compilation of the sealed engineering drawing for this project, modified by addenda, change orders and information furnished by the contractor. The information shown on the record drawings that was provided by the contractor or others not associated with the design engineer cannot be verified for accuracy or completeness. This original sealed drawings are on file at the offices of Birkhoff, Hendricks & Conway, L.L.P.

BY RYC DATE 5/12/09

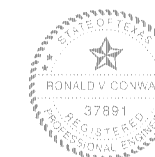

Ronald V. Conway
9/9/08