

# CITY OF ROCKWALL, TEXAS

CONSTRUCTION PLANS FOR

## NEIGHBORHOOD DRAINAGE IMPROVEMENTS PHASE 2

### COUNCIL MEMBERS

**BILL CECIL, MAYOR**  
**CLIFF SEVIER, MAYOR PRO-TEM**  
**GLEN FARRIS**  
**MARGO NIELSEN**  
**MARK RUSSO**  
**MATT SCOTT**  
**DAVID SWEET**

### CITY MANAGER

**JULIE COUCH**

### ASSISTANT CITY MANAGER

**RICHARD CROWLEY**

### CITY ENGINEER

**CHUCK TODD, P.E.**




**BIRKHOFF, HENDRICKS & CONWAY, L.L.P.**  
 CONSULTING ENGINEERS  
 Dallas, Texas

SEPTEMBER 2008

*This record drawing is a compilation of the sealed engineering drawing for this project, modified by addenda, change orders and information furnished by the contractor. The information shown on the record drawings that was provided by the contractor or others not associated with the design engineer cannot be verified for accuracy or completeness. This original sealed drawings are on file at the offices of Birkhoff, Hendricks & Conway, L.L.P.*

BY RTC DATE 5/12/09

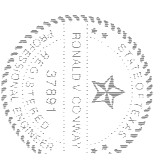

*Ronald V. Conway*  
 9/2/08