



DRAINAGE AREA DATA					
AREA	ACREAGE	C	I (MIN)	I (in./hr.)	Q(cfs.)
4	21.00	0.5	15	9.0	94.5

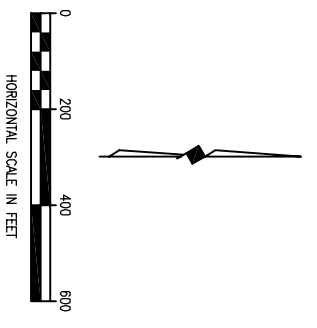

This record drawing is a completion of the sealed engineering drawing for this project, modified by the addenda, change orders and information furnished by the contractor. The information shown on the record drawings that was provided by the contractor or others not associated with the design engineer cannot be verified for accuracy or completeness. This original sealed drawings are on file at the offices of Birkhoff, Hendricks & Conway, L.L.P.
 BY RYC DATE 5/12/09

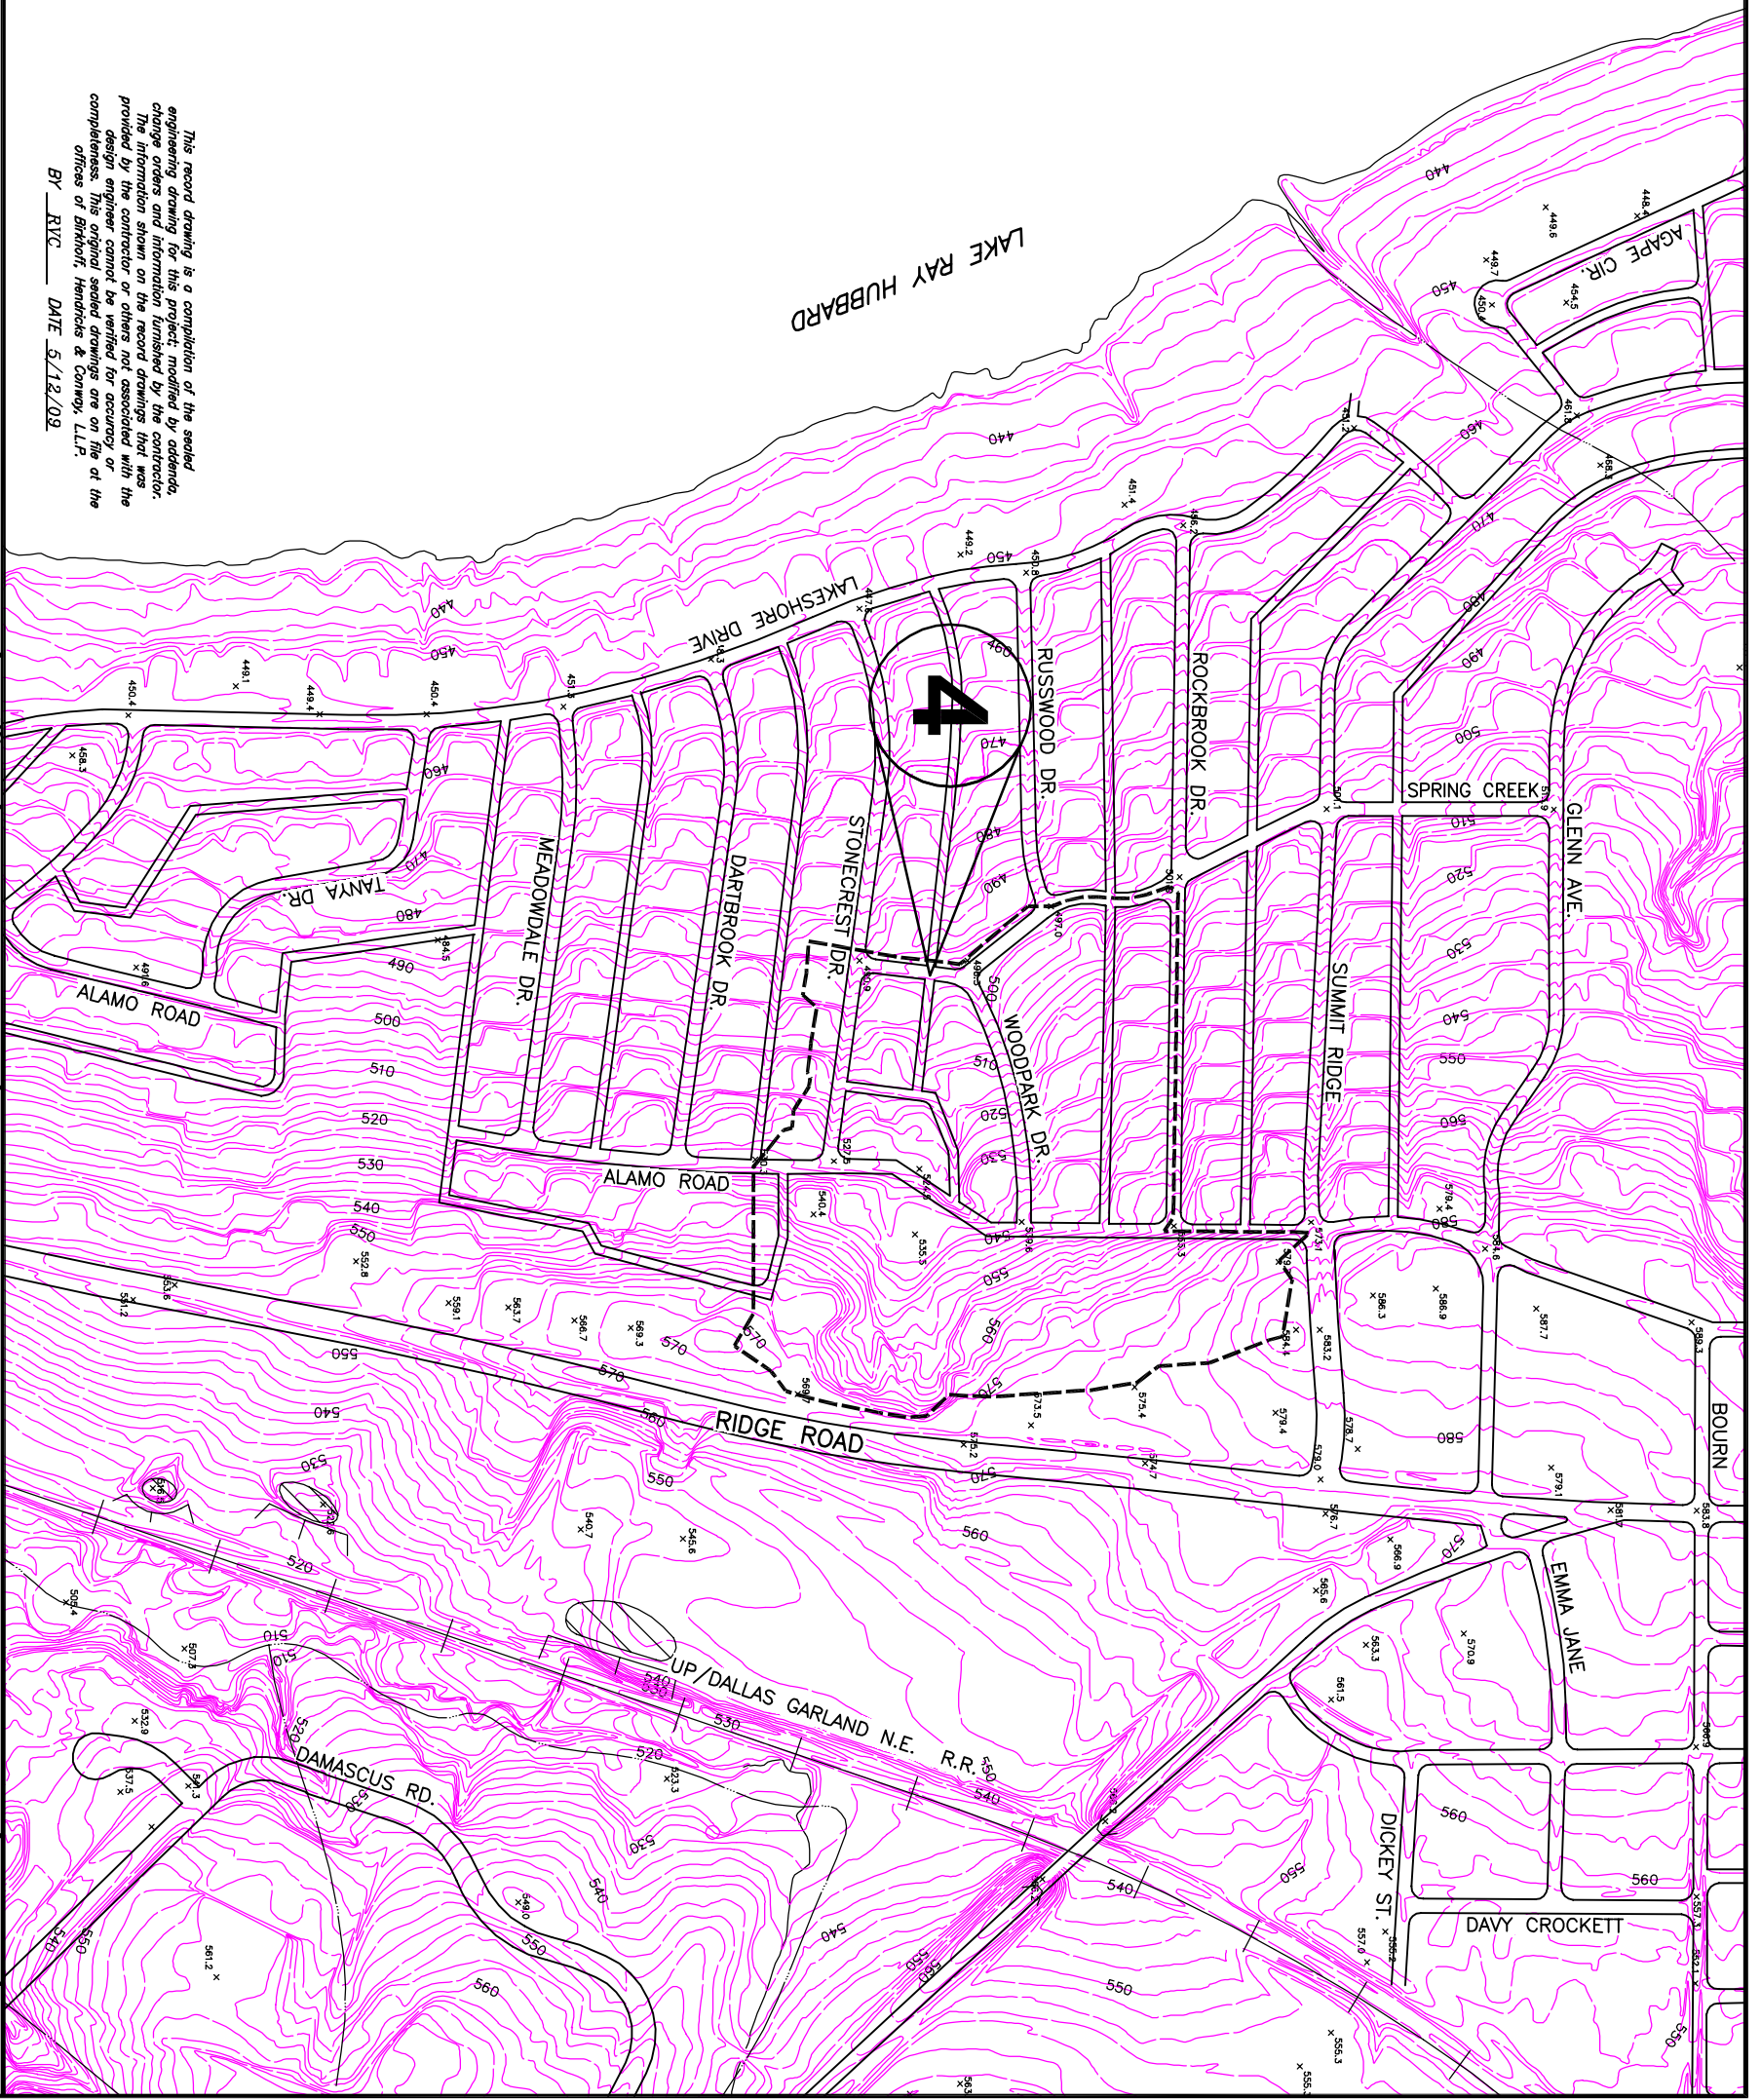

BIRKHOFF, HENDRICKS & CONWAY, L.L.P.
 CONSULTING ENGINEERS
 7502 Greenville Ave., Suite 220
 Dallas, Texas
 (214) 361-7900



Ronald V. Conway
 9/15/05

CITY OF ROCKWALL, TEXAS
 NEIGHBORHOOD DRAINAGE IMPROVEMENTS - PHASE 2
 DRAINAGE AREA MAP
 DRAINAGE SITE 4

BHC PROJECT NO. 2006-182
 SHEET NO. 4
 SEPTEMBER 2008