


T.B.M.:  
PK NAIL SET IN CONCRETE FLUME  
JUST EAST OF ALLEY,  
ELEV. 100.00

T.B.M.:  
CENTER OF INLET LID IN WEST  
SIDE OF LAKESHORE DRIVE AT  
CONCRETE FLUME,  
ELEV. 103.27

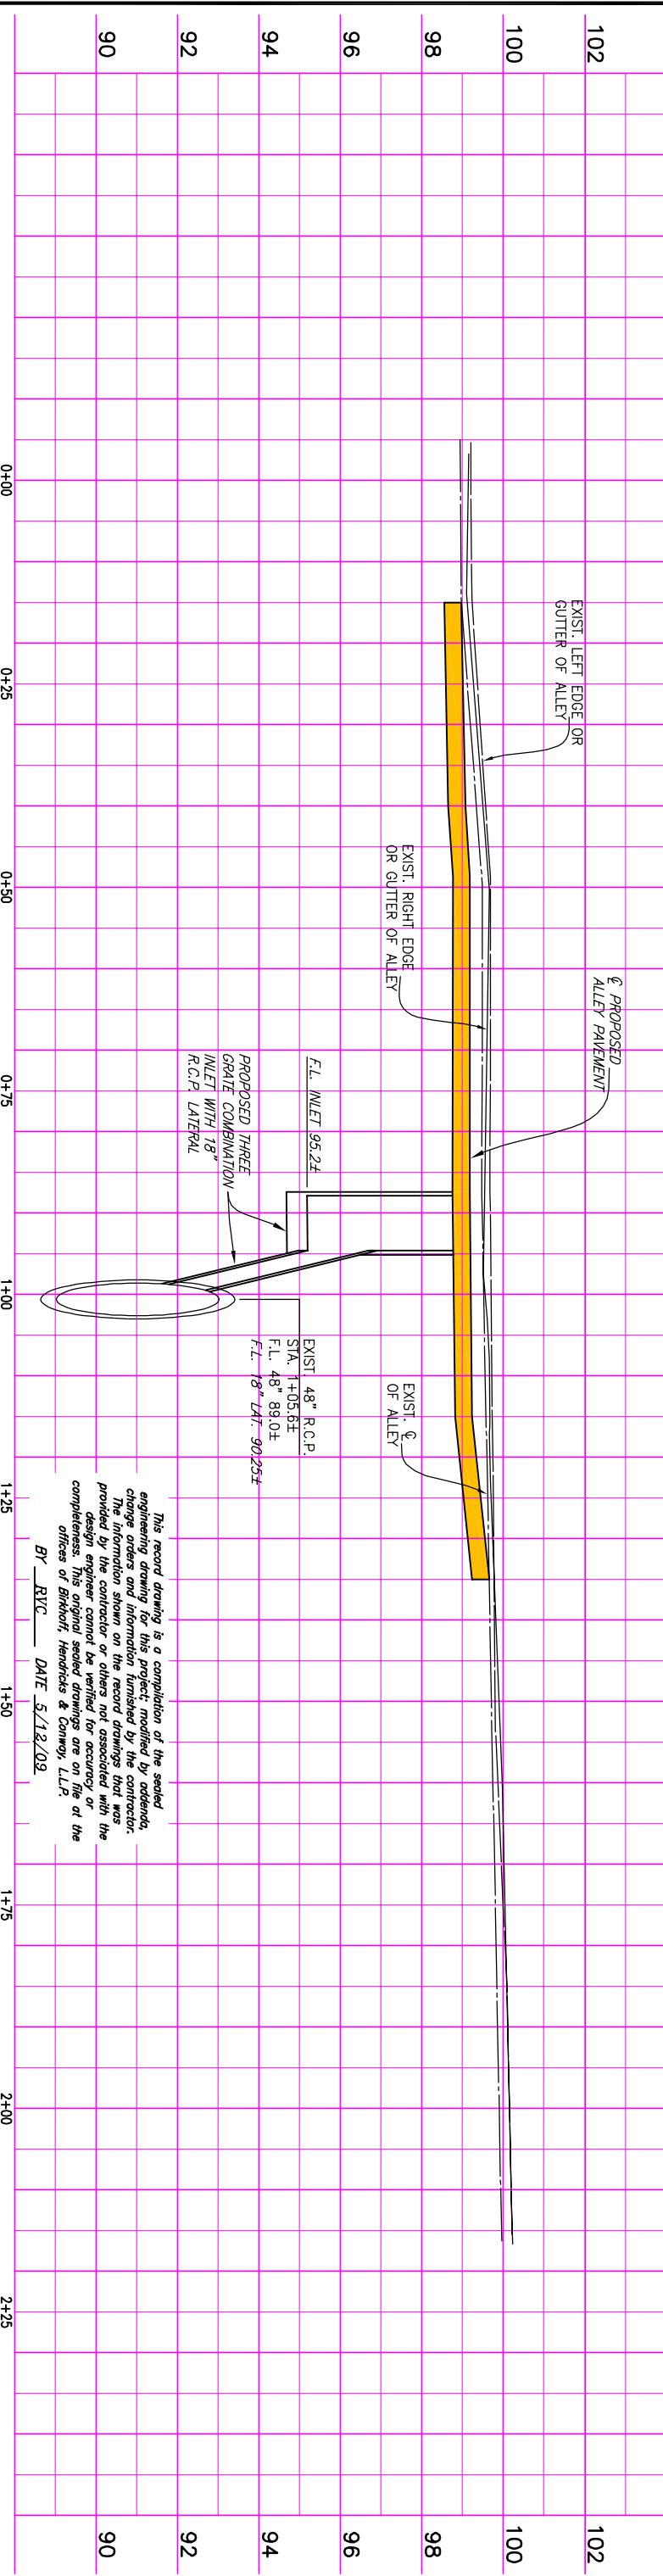

This record drawing is a compilation of the sealed engineering drawing for this project, modified by the addenda, change orders and information furnished by the contractor. The information shown on the record drawings that was provided by the contractor or others not associated with the design engineer cannot be verified for accuracy or completeness. This original sealed drawings are on file at the offices of Birkhoff, Hendricks & Conway, L.L.P.

BY RYC DATE 5/12/09

<p style="text-align: center;"><b>BIRKHOFF, HENDRICKS &amp; CONWAY, L.L.P.</b></p> <p style="text-align: center;">CONSULTING ENGINEERS</p> <p style="text-align: center;">7502 Greenville Ave., Suite 220 Dallas, Texas (214) 361-7900</p>	<p style="text-align: center;">PLOT SCALE: 1:2</p> <p style="text-align: center;">PLOT STYLE: 11x17.ctb</p> <p style="text-align: center;">PLOTTED BY: WHANS ON 5/13/2009</p>
<p style="text-align: center;"><b>CITY OF ROCKWALL, TEXAS</b></p> <p style="text-align: center;">NEIGHBORHOOD DRAINAGE IMPROVEMENTS - PHASE 2</p> <p style="text-align: center;"><b>DRAINAGE SITE 3 IMPROVEMENTS</b></p> <p style="text-align: center;"><b>ALLEY BETWEEN STONEBRIDGE DR. AND LAKESHORE DR.</b></p>	<p style="text-align: center;">BHC PROJECT NO. 2006-182</p> <p style="text-align: center;">SEPTEMBER 2008</p>
<p style="text-align: center;">9/15/08</p>	<p style="text-align: center;">SHEET NO. <b>7</b></p>