


These plans and related specifications were prepared for construction of this specific project only. Reuse of these documents is not permitted without written authorization of Birkhoff, Hendricks, & Conway, L.L.P.

SHEET NO.	SHEET DESCRIPTION
1	TITLE SHEET
2	LOCATION MAP & SHEET INDEX
3	DRAINAGE AREA MAP - DRAINAGE SITES 1, 11, 12 & 17
4	DRAINAGE AREA MAP - DRAINAGE SITES 2, 16 & 19
5	DRAINAGE AREA MAP - DRAINAGE SITES 5, 8, 18 & 20
6	DRAINAGE AREA MAP - DRAINAGE SITES 7 & 13
7	INLET DESIGN CALCULATIONS
8	DRAINAGE SITE 1 IMPROVEMENTS - LAKESHORE DR. NORTH OF SHORETRAIL DR.
9-12	DRAINAGE SITE 2 IMPROVEMENTS - LAKESHORE DR. NEAR STONECREST DR.
13	DRAINAGE SITE 5 IMPROVEMENTS - HEATH ST. WEST OF FANNIN ST.
14	DRAINAGE SITE 7 IMPROVEMENTS - ALLEY EAST OF ALAMO RD. AT BECKY LN.
15	DRAINAGE SITE 8 IMPROVEMENTS - CARRIAGE TR. NEAR WESTWAY DR.
16	DRAINAGE SITE 11 IMPROVEMENTS - ALLEY EAST OF LAKESHORE DR. NEAR FOREST TRACE
17	DRAINAGE SITE 12 IMPROVEMENTS - ALLEY NORTH OF BOYDSTUN DR. AT RIVERVIEW DR.
18	DRAINAGE SITE 13 IMPROVEMENTS - ALLEY EAST LAKESHORE DR. NEAR LAKEVIEW DR.
19	DRAINAGE SITE 16 IMPROVEMENTS - ALLEY NORTH OF MEADOWDALE AT ALAMO RD.
20	DRAINAGE SITE 17 IMPROVEMENTS - ALLEY NORTH OF SUMMIT RIDGE AT SPRING CREEK
21	DRAINAGE SITE 18 IMPROVEMENTS - ALLEY WEST OF VALLEY DR. AT WESTWAY DR.
22	DRAINAGE SITE 19 IMPROVEMENTS - ALLEY EAST OF ALAMO RD. NEAR MEADOWDALE
23	DRAINAGE SITE 20 IMPROVEMENTS - HEATH ST. WEST OF PARKS AVE.
24	DRAINAGE SITE 21 IMPROVEMENTS - ALLEY EAST OF LAKVIEW & NORTH OF LAKEDALE

LEGEND



DRAINAGE IMPROVEMENT SITE

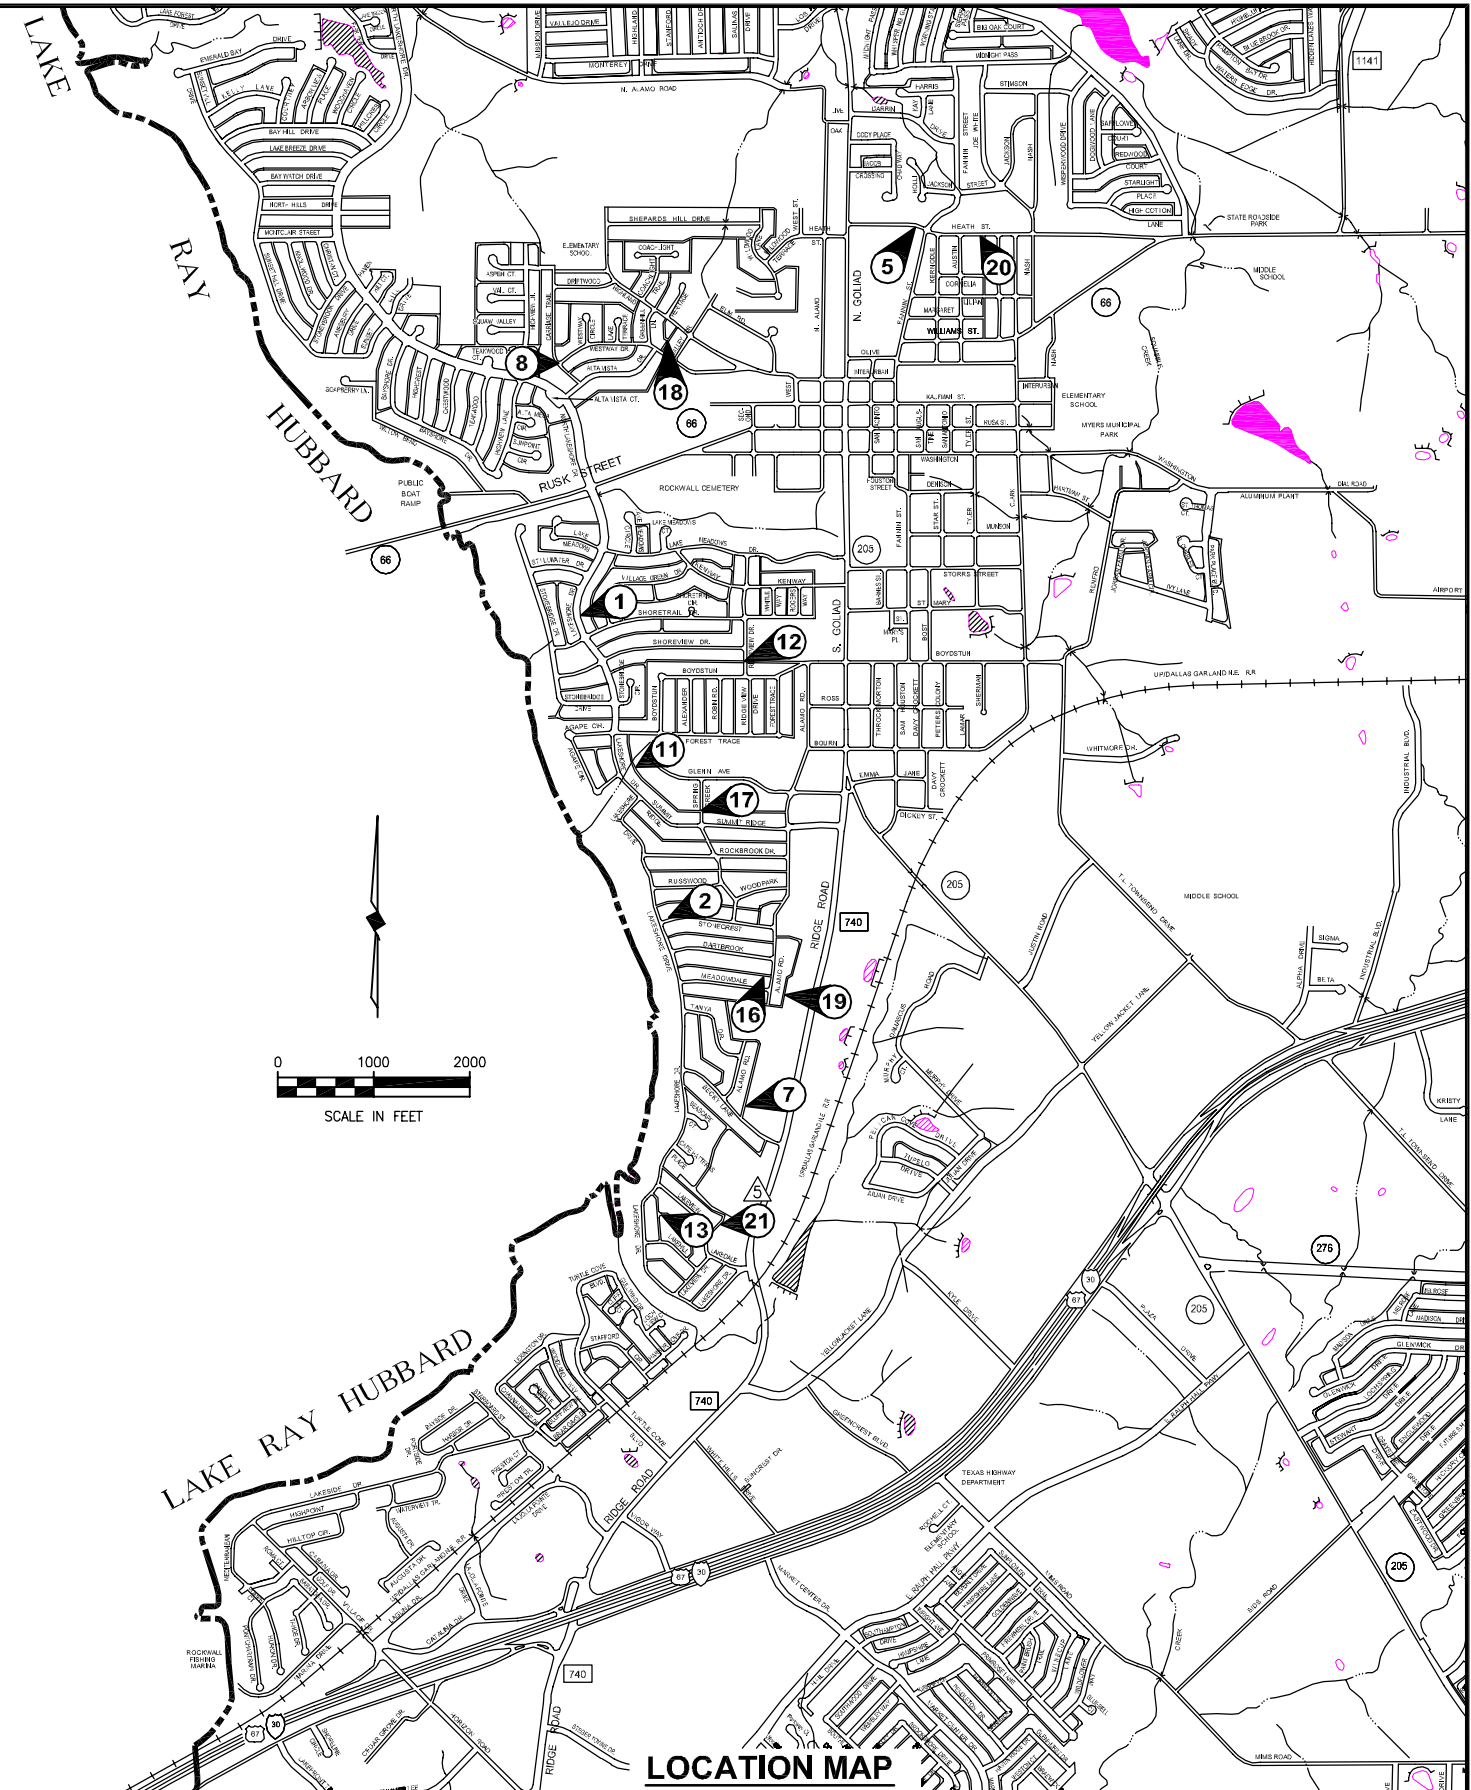

This record drawing is a compilation of the sealed engineering drawing for this project, modified by addenda, change orders and information furnished by the contractor. The information shown on the record drawings that was provided by the contractor or others not associated with the design engineer cannot be verified for accuracy or completeness. This original sealed drawings are on file at the offices of Birkhoff, Hendricks & Conway, L.L.P.
 BY RVC DATE 5/12/09

LOCATION MAP

FIELD CHANGE NO. 5 AUGUST 14, 2007	BIRKHOFF, HENDRICKS & CONWAY, L.L.P. CONSULTING ENGINEERS 7502 Greenville Ave., Suite 220 Dallas, Texas (214) 361-7900	 <i>Ronald Conway</i> 8/13/07	CITY OF ROCKWALL, TEXAS NEIGHBORHOOD DRAINAGE IMPROVEMENTS	BHC PROJECT NO. 2006-182	SHEET NO. 2
			LOCATION MAP & SHEET INDEX	JANUARY, 2007	