

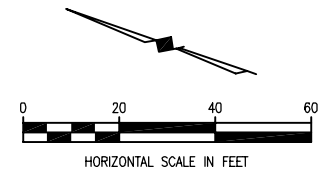


These plans and related specifications were prepared for construction of this specific project only. Reuse of these documents is not permitted without written authorization of Birkhoff, Hendricks, & Conway, L.L.P.

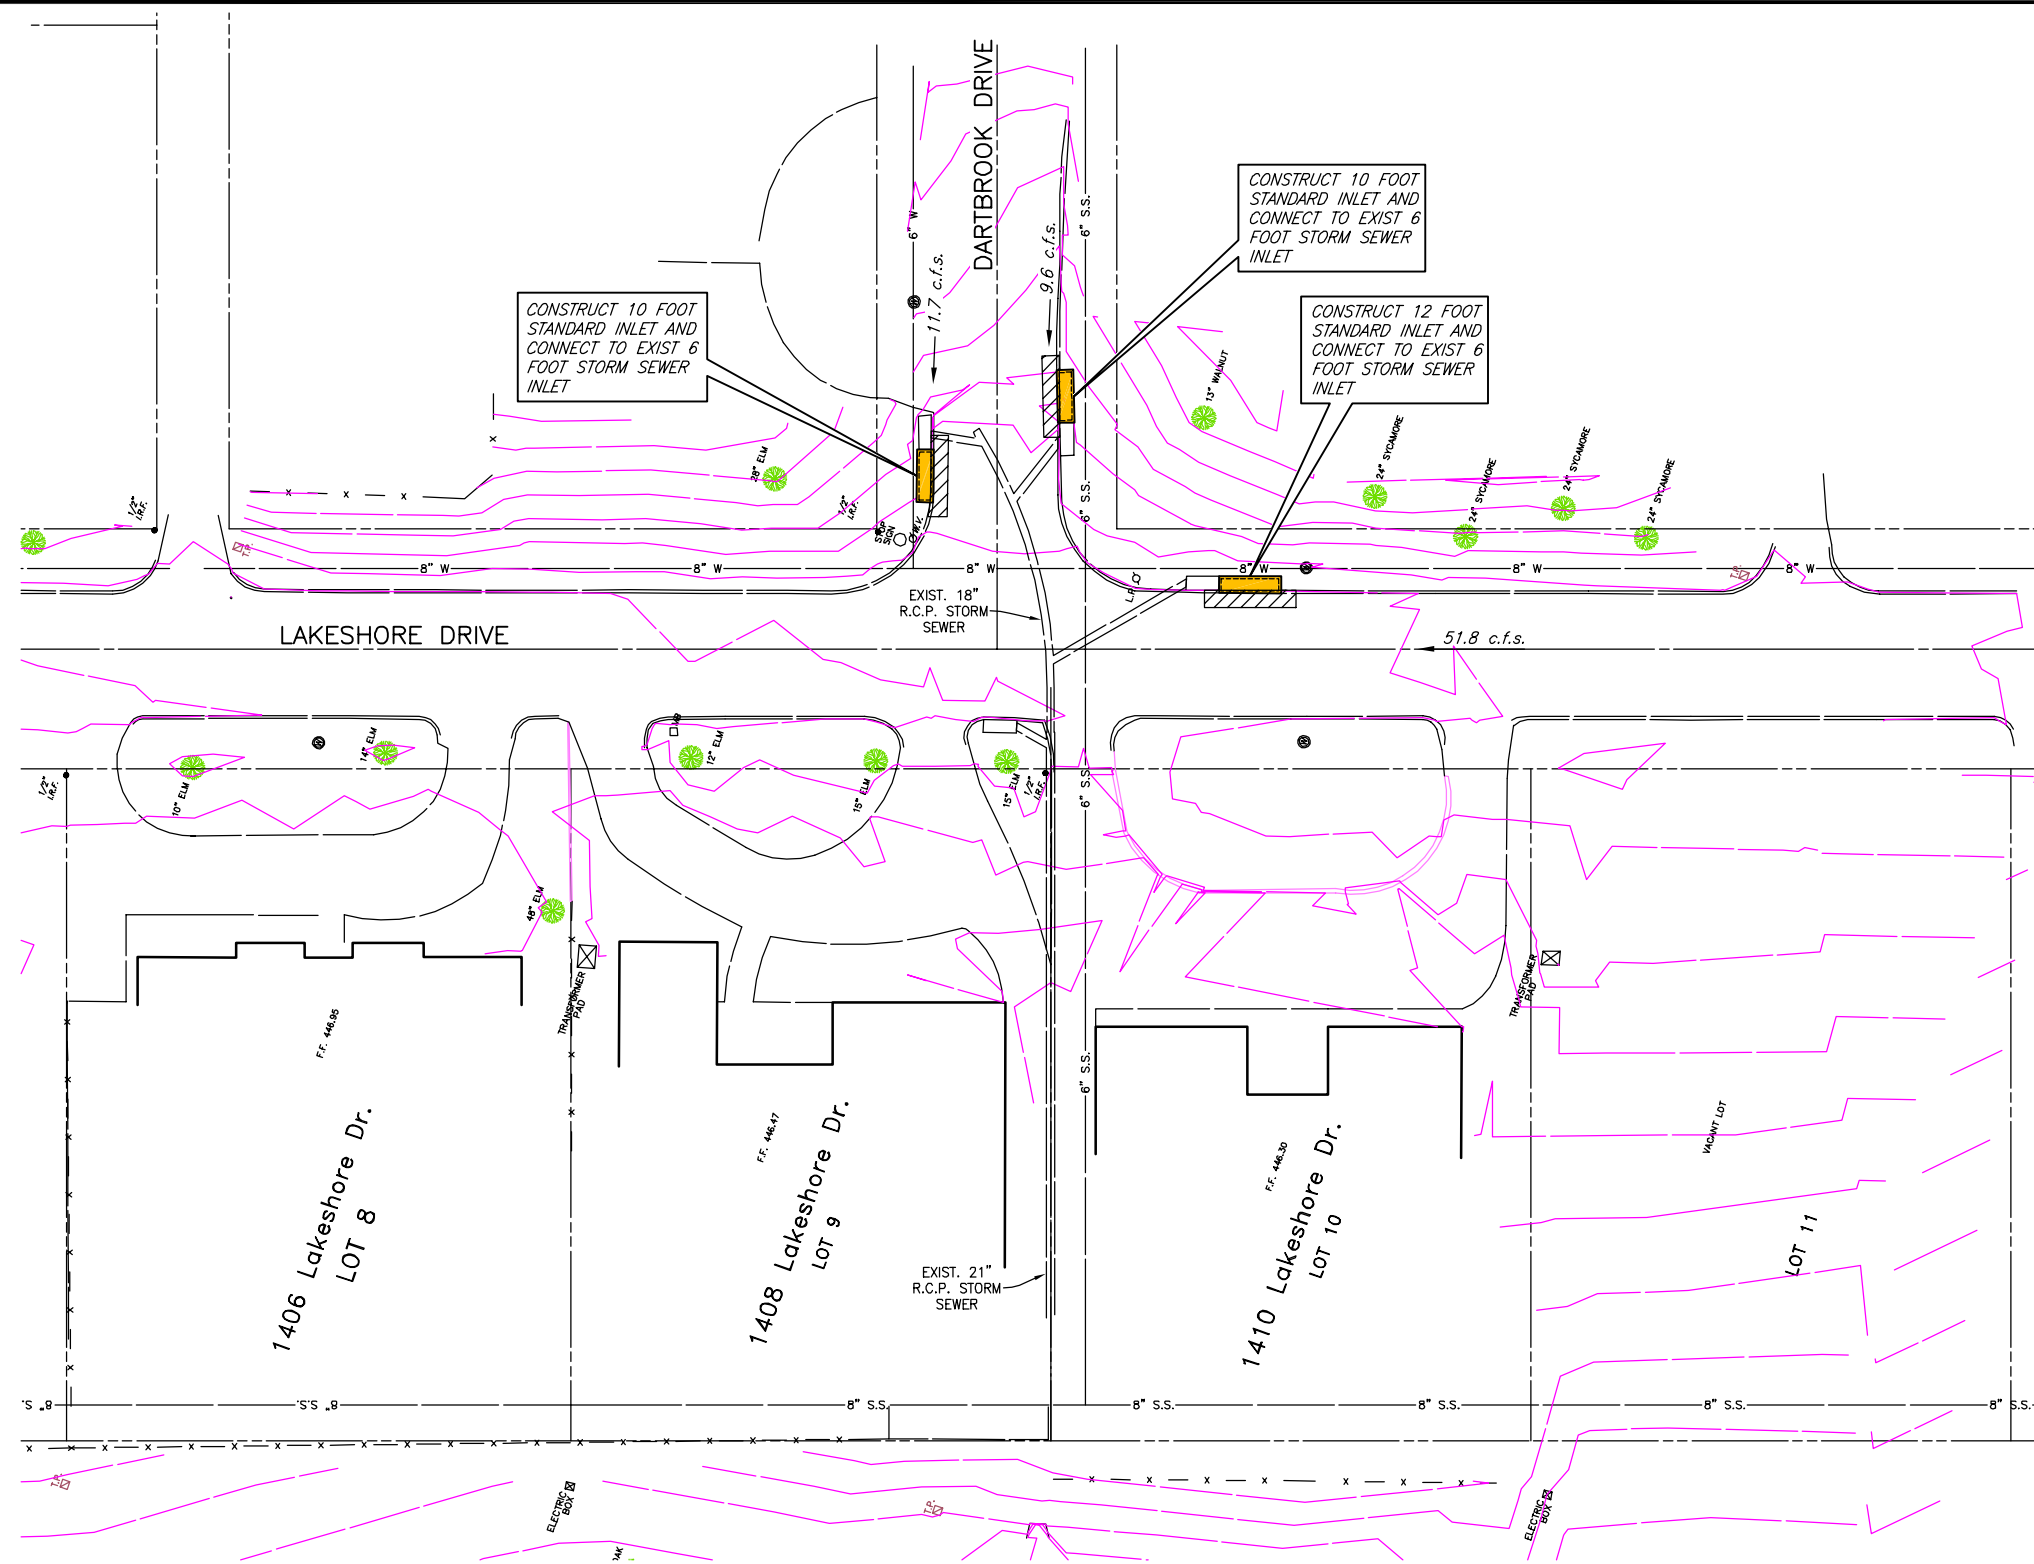

This record drawing is a compilation of the sealed engineering drawing for this project; modified by addenda, change orders and information furnished by the contractor. The information shown on the record drawings that was provided by the contractor or others not associated with the design engineer cannot be verified for accuracy or completeness. This original sealed drawings are on file at the offices of Birkhoff, Hendricks & Conway, L.L.P.
 BY RVC DATE 5/12/09

BIRKHOFF, HENDRICKS & CONWAY, L.L.P.
 CONSULTING ENGINEERS
 7502 Greenville Ave., Suite 220
 Dallas, Texas
 (214) 361-7900

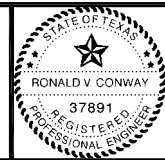

Ronald V. Conway
 1/31/07

CITY OF ROCKWALL, TEXAS
 NEIGHBORHOOD DRAINAGE IMPROVEMENTS
DRAINAGE SITE 2 IMPROVEMENTS
LAKESHORE DRIVE NEAR STONECREST DRIVE

BHC
 PROJECT NO.
 2006-182
 JANUARY, 2007

SHEET NO.
11