


T.B.M.:  
NORTHEAST CORNER OF TRANSFORMER  
PAD WEST OF THE ALLEY INTERSECTION  
EAST OF LAKESHORE DR. NEAR  
LAKEVIEW DR  
ELEV. 100.94

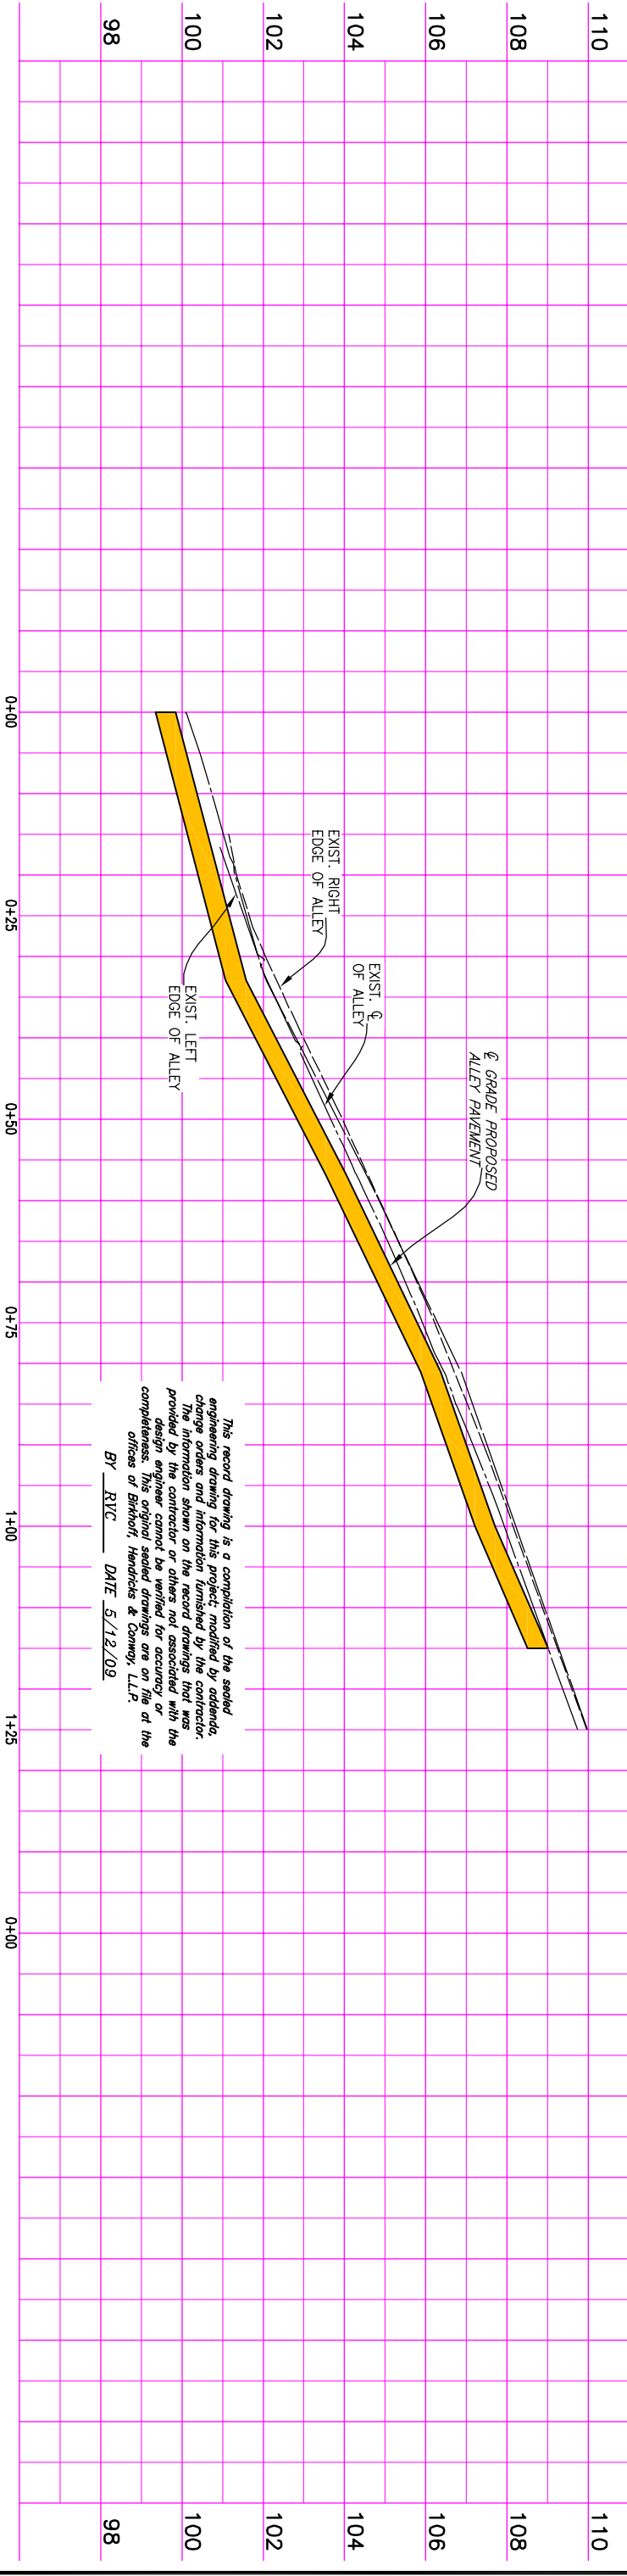

This record drawing is a compilation of the sealed engineering drawing for this project, modified by addenda, change orders and information furnished by the contractor. The information shown on the record drawings that was provided by the contractor or others not associated with the design engineer cannot be verified for accuracy or completeness. This original sealed drawings are on file at the offices of Birkhoff, Hendricks & Conway, L.L.P.  
BY RYC DATE 5/12/09

**BIRKHOFF, HENDRICKS & CONWAY, L.L.P.**  
CONSULTING ENGINEERS  
7502 Greenville Ave., Suite 220  
Dallas, Texas  
(214) 361-7900



*Ronald V. Conway*  
1/31/07

**CITY OF ROCKWALL, TEXAS**  
NEIGHBORHOOD DRAINAGE IMPROVEMENTS  
DRAINAGE SITE 13 IMPROVEMENTS  
ALLEY EAST OF LAKESHORE DRIVE NEAR LAKEVIEW DRIVE

BHC PROJECT NO. 2006-182  
JANUARY, 2007  
SHEET NO. **18**