
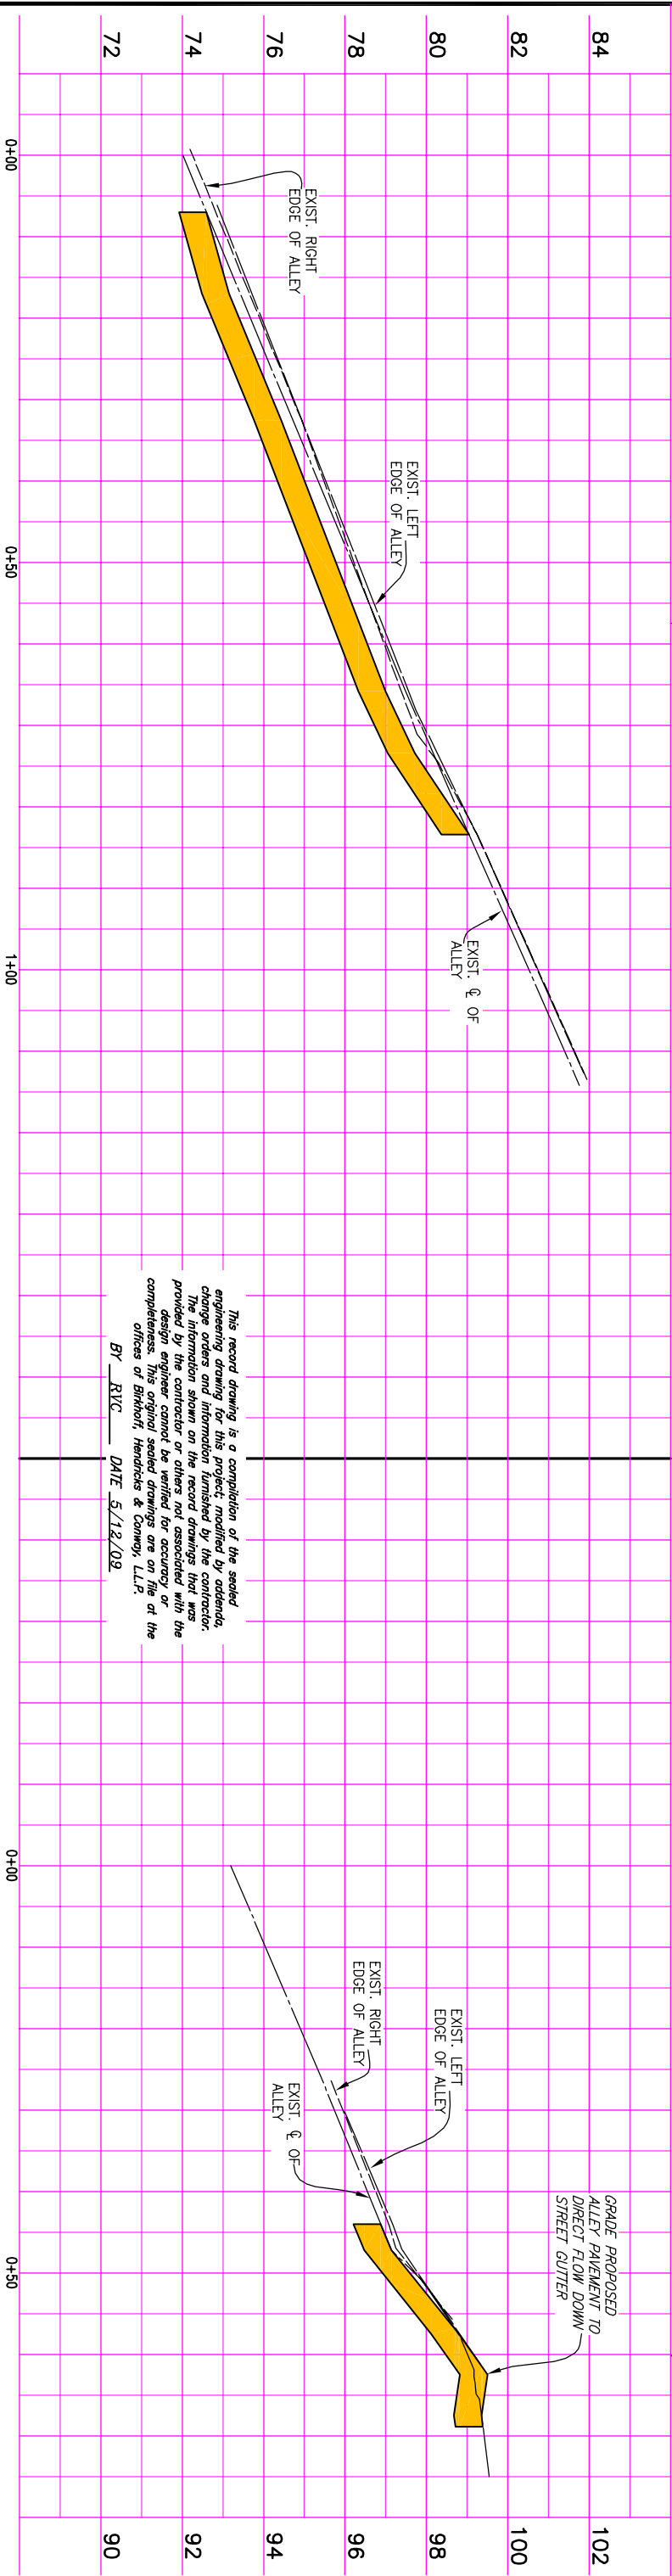


T.B.M.:
TOP OF RIM OF MANHOLE LOCATED
IN THE ϕ OF THE ALLEY NORTH
OF MEADOWDALE AT ALAMO ROAD.
ELEV. 79.53

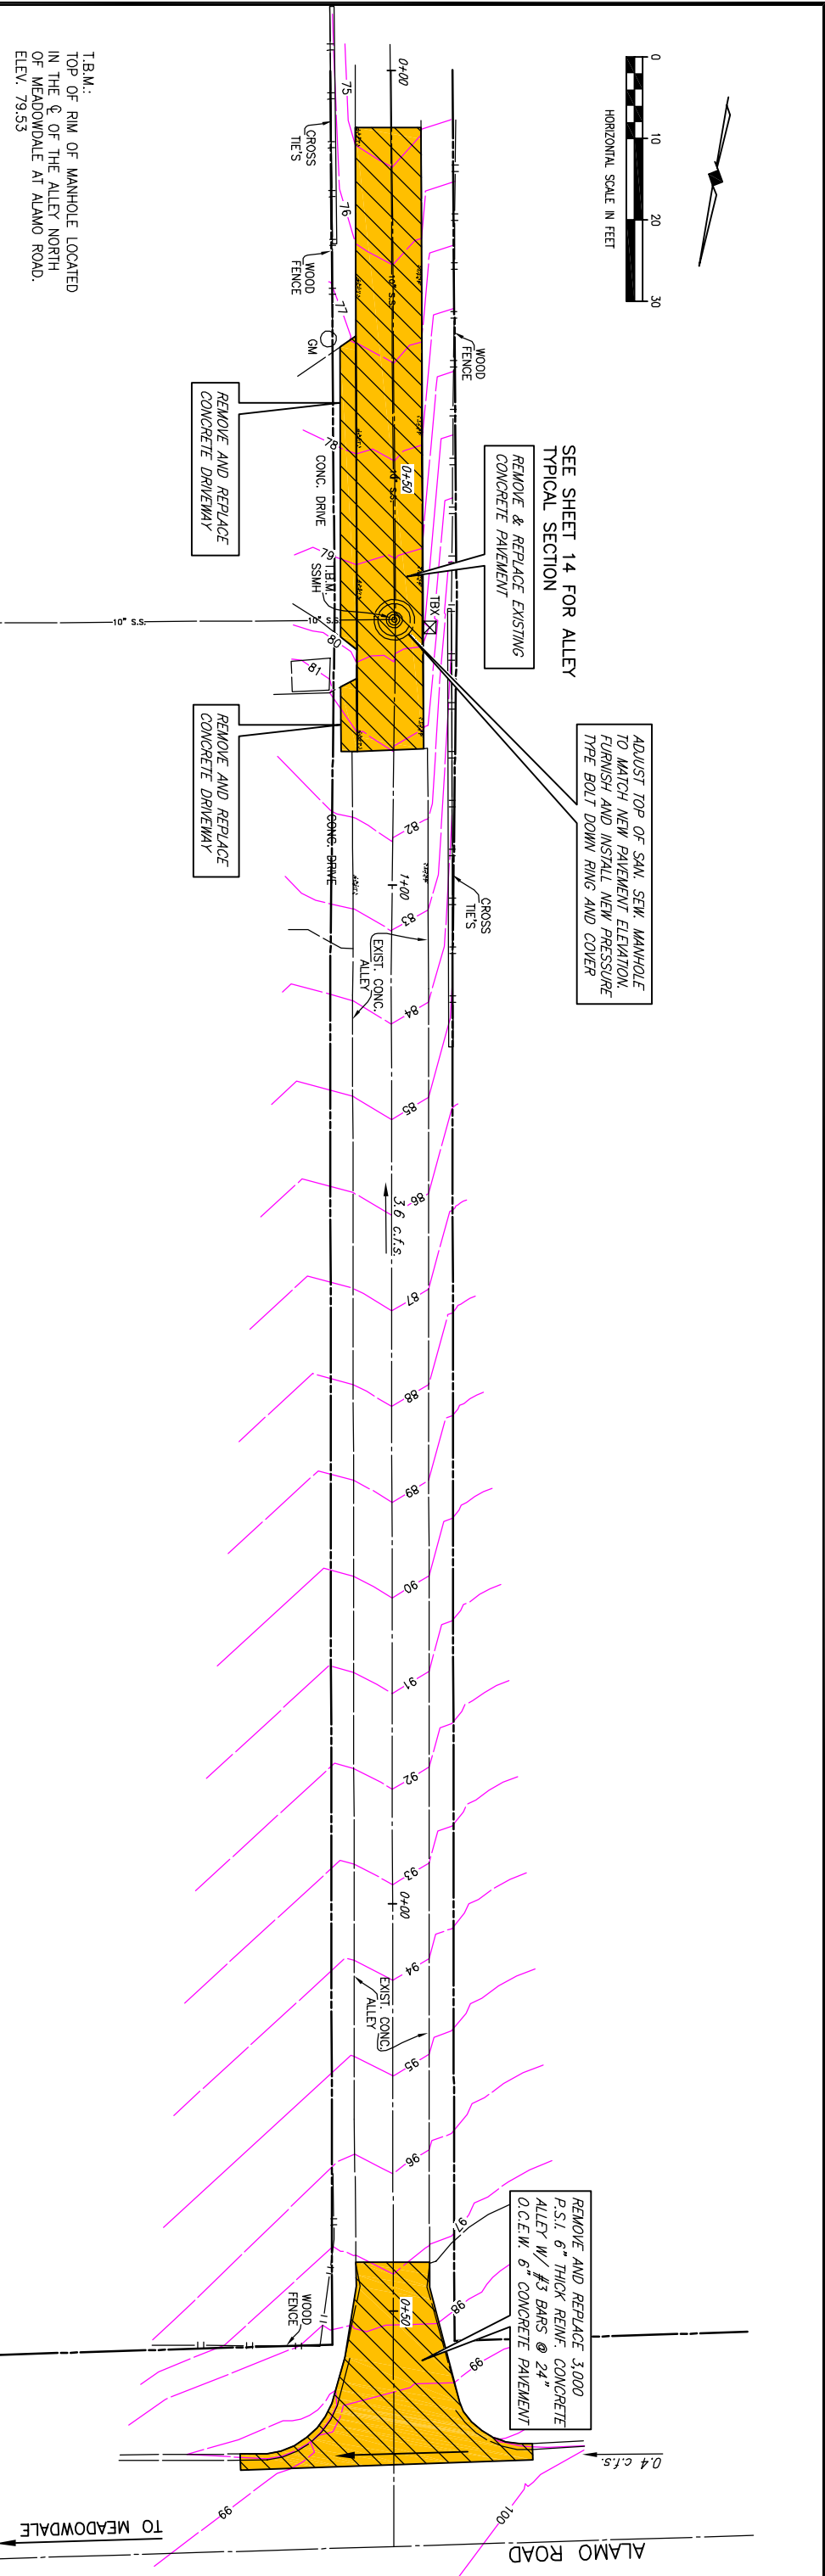

This record drawing is a compilation of the sealed engineering drawing for this project, modified by addenda, change orders and information furnished by the contractor. The information shown on the record drawings that was provided by the contractor is not associated with the engineer's professional seal and is not to be relied upon for completeness. This original sealed drawing is on file at the offices of Birkhoff, Hendricks & Conway, L.L.P.
BY RVC DATE 5/12/09

BIRKHOFF, HENDRICKS & CONWAY, L.L.P. CONSULTING ENGINEERS 7502 Greenville Ave., Suite 220 Dallas, Texas (214) 361-7900				CITY OF ROCKWALL, TEXAS NEIGHBORHOOD DRAINAGE IMPROVEMENTS	BHC PROJECT NO. 2006-182
DRAINAGE SITE 16 IMPROVEMENTS ALLEY NORTH OF MEADOWDALE AT ALAMO ROAD				JANUARY, 2007	SHEET NO. 19