



REMOVE AND REPLACE EXIST. ASPHALT PAVEMENT WITH CONC. CURB AND GUTTER

REMOVE EXISTING GRATE INLET CONSTRUCT 2x2 DROP INLET WITH 24" WIDE 4" THICK CONC. APRON AROUND OPENINGS 45 L.F. 18" R.C.P. CONNECT TO EXIST. 27" R.C.P. STORM SEWER

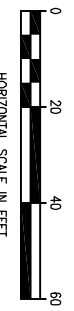

T.B.M.: TOP SANITARY SEWER MANHOLE AT THE INTERSECTION OF HEATH DRIVE AND PARKS AVENUE. ELEV. 103.01

102	EXIST. 6" WATER WATER F.L. 96.1± (CONFIRM DEPTH PRIOR TO STM. SEW. INSTALLATION)	EXIST. 8" SAN. SEW. F.L. 96.09	EXIST. GAS DEPTH UNKNOWN	102
100	EXIST. 18" R.C.P. ON -30.64±	EXIST. 21" WATER TOP PIPE 95.8± (CONFIRM DEPTH PRIOR TO STM. SEW. INSTALLATION)	EXIST. 12" WATER TOP PIPE 96.1± (CONFIRM DEPTH PRIOR TO STM. SEW. INSTALLATION)	100
98	EXIST. 27" R.C.P. STORM SEWER	EXIST. 18" R.C.P. ON -0.50±	EXIST. 12" WATER TOP PIPE 96.1± (CONFIRM DEPTH PRIOR TO STM. SEW. INSTALLATION)	98
96	EXIST. 27" R.C.P. STORM SEWER	EXIST. 18" R.C.P. ON -30.64±	EXIST. 12" WATER TOP PIPE 96.1± (CONFIRM DEPTH PRIOR TO STM. SEW. INSTALLATION)	96
94	EXIST. 27" R.C.P. STORM SEWER	EXIST. 18" R.C.P. ON -30.64±	EXIST. 12" WATER TOP PIPE 96.1± (CONFIRM DEPTH PRIOR TO STM. SEW. INSTALLATION)	94
92	EXIST. 27" R.C.P. STORM SEWER	EXIST. 18" R.C.P. ON -30.64±	EXIST. 12" WATER TOP PIPE 96.1± (CONFIRM DEPTH PRIOR TO STM. SEW. INSTALLATION)	92
90	EXIST. 27" R.C.P. STORM SEWER	EXIST. 18" R.C.P. ON -30.64±	EXIST. 12" WATER TOP PIPE 96.1± (CONFIRM DEPTH PRIOR TO STM. SEW. INSTALLATION)	90
88	EXIST. 27" R.C.P. STORM SEWER	EXIST. 18" R.C.P. ON -30.64±	EXIST. 12" WATER TOP PIPE 96.1± (CONFIRM DEPTH PRIOR TO STM. SEW. INSTALLATION)	88

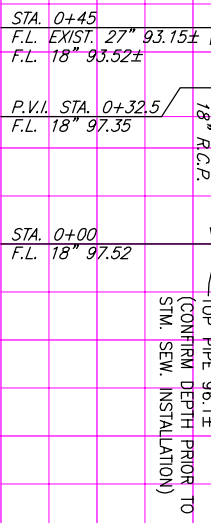

This record drawing is a compilation of the sealed engineering drawing for this project, modified by addenda, change orders and information furnished by the contractor. The information shown on the record drawings that was provided by the contractor or others not associated with the design engineer cannot be verified for accuracy or completeness. This original sealed drawings are on file at the offices of Birkhoff, Hendricks & Conway, L.L.P.  
 BY RYC DATE 5/12/09

**BIRKHOFF, HENDRICKS & CONWAY, L.L.P.**  
 CONSULTING ENGINEERS  
 7502 Greenville Ave., Suite 220  
 Dallas, Texas  
 (214) 361-7900



**CITY OF ROCKWALL, TEXAS**  
 NEIGHBORHOOD DRAINAGE IMPROVEMENTS  
**HEATH STREET WEST OF PARKS AVENUE**

BHC PROJECT NO. 2006-182 SHEET NO. **23**  
 JANUARY, 2007