

NOTE: ALL PROPOSED DRIVE APPROACHES SHALL BE 12' WIDE & EXTENDED TO R.O.W. LINE EXCEPT AS NOTED ON PLANS. DRIVES SHALL BE CONSTR. OF 6" 3600 P.S.I. CONCRETE REINFORCED W/ #5 BARS 24" C.C. BOTHWAYS

NOTE: ALL R.O.W. ON DRIVES WILL BE 5' EXCEPT AS NOTED ON PLANS

NOTE: ALL UNDERGROUND UTILITIES TO BE RELOCATED OR ADJUSTED TO NEW PAVEMENT OR PARKWAY GRADE PRIOR TO ANY PAVEMENT CONSTRUCTION

NOTE: ALL EXISTING DRAINAGE PIPES TO BE REMOVED & SALVAGED EXCEPT AS NOTED ON THE STORM SEWER DESIGN PLANS.

NOTE: POWER POLES & TELEPHONE BOXES TO BE RELOCATED BY OTHERS PRIOR TO CONSTRUCTION

NOTE: ALL CONSTRUCTION SHALL MEET CITY OF ROCKWALL SPECIFICATIONS

NOTE: CONTRACTOR SHALL HAVE ONE LANE REMAINED OPEN FOR TRAFFIC AT ALL TIMES

NOTE: STREET CONSTRUCTION - 6" 3600 P.S.I. CONCRETE W/ #3 BARS 24" C.C. EA. W/IN 5' 6" STABILIZED LIME SUBGRADE W/ A MIN. OF 7% LIME

SAW-CUT & CONNECT TO EXIST. CONCRETE DRIVE


RECONSTRUCT EXIST. SIDEWALK TO PROPOSED CURB

SAW-CUT & CONNECT TO EXIST. CONCRETE DRIVE

RECONSTRUCT SIDEWALK TO PROPOSED CURB

CONSTRUCT SIDEWALK FROM PROPOSED CURB TO EXIST. SIDEWALK

SAW-CUT & CONNECT TO EXIST. CONCRETE DRIVE

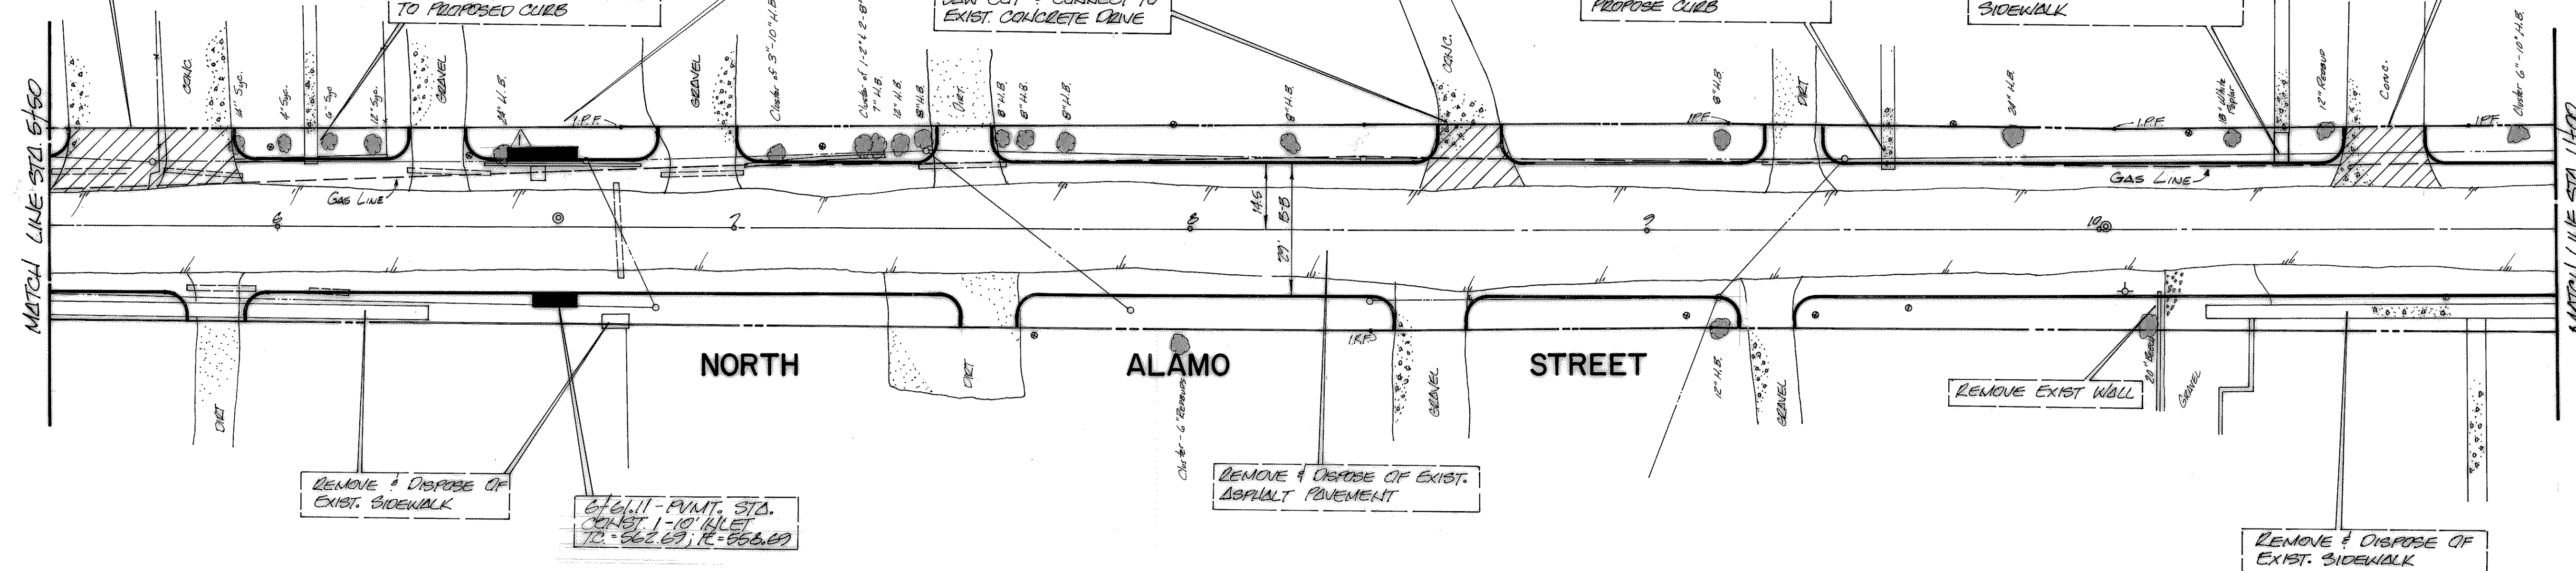


LEGEND

POWER POLE
TELEPHONE BOX
TELEPHONE M.H.
GAS METER
FIRE HYDRANT
WATER METER
WATER VALVE
STORM SEWER M.H.



B.M. - BOLT ON FIRE HYDRANT @ SW CORNER OF HEATH ST. & N. ALAMO ST. ELEV. = 570.77

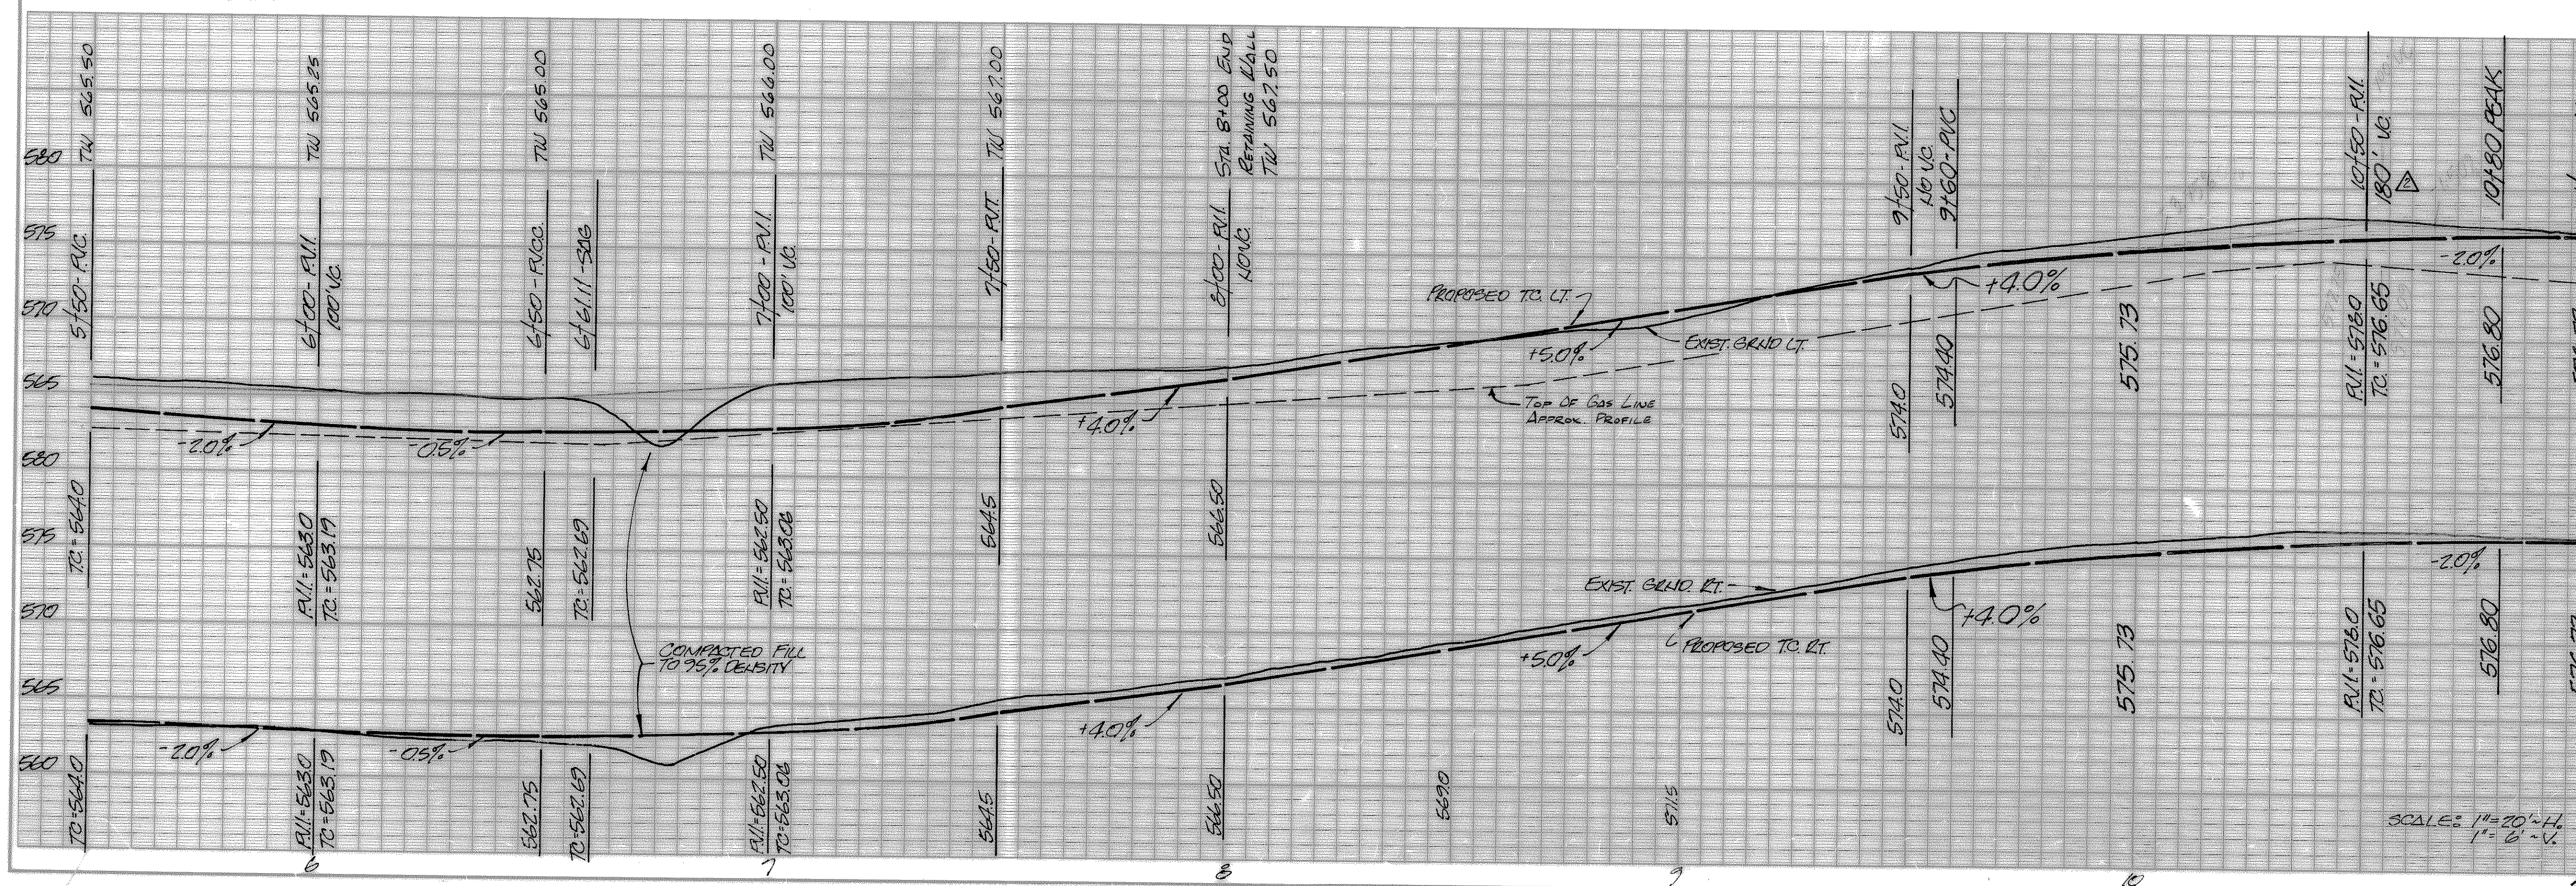

Changed Vertical Curve from 100' to 130' for proper sighting 7/25/89

REVISION NO.	REMARKS	DATE
1	Changed 10' Inlet @ Sta. 6761.11 to 15' Inlet (Erad. Data Only)	7/5/89
PAVING IMPROVEMENTS		
NORTH ALAMO STREET		
CITY OF ROCKWALL, TEXAS 205 W. RUSK STREET 214-722-1111		
DESIGNED: W.L.D.	SCALE: NOTED	
DRAWN: W.L.D.	APPROVED: W.L. Dougherty	
JOB NO. 87008	DATE: 7-87	
	SHEET NO. 9	