



SEE SHEET 29

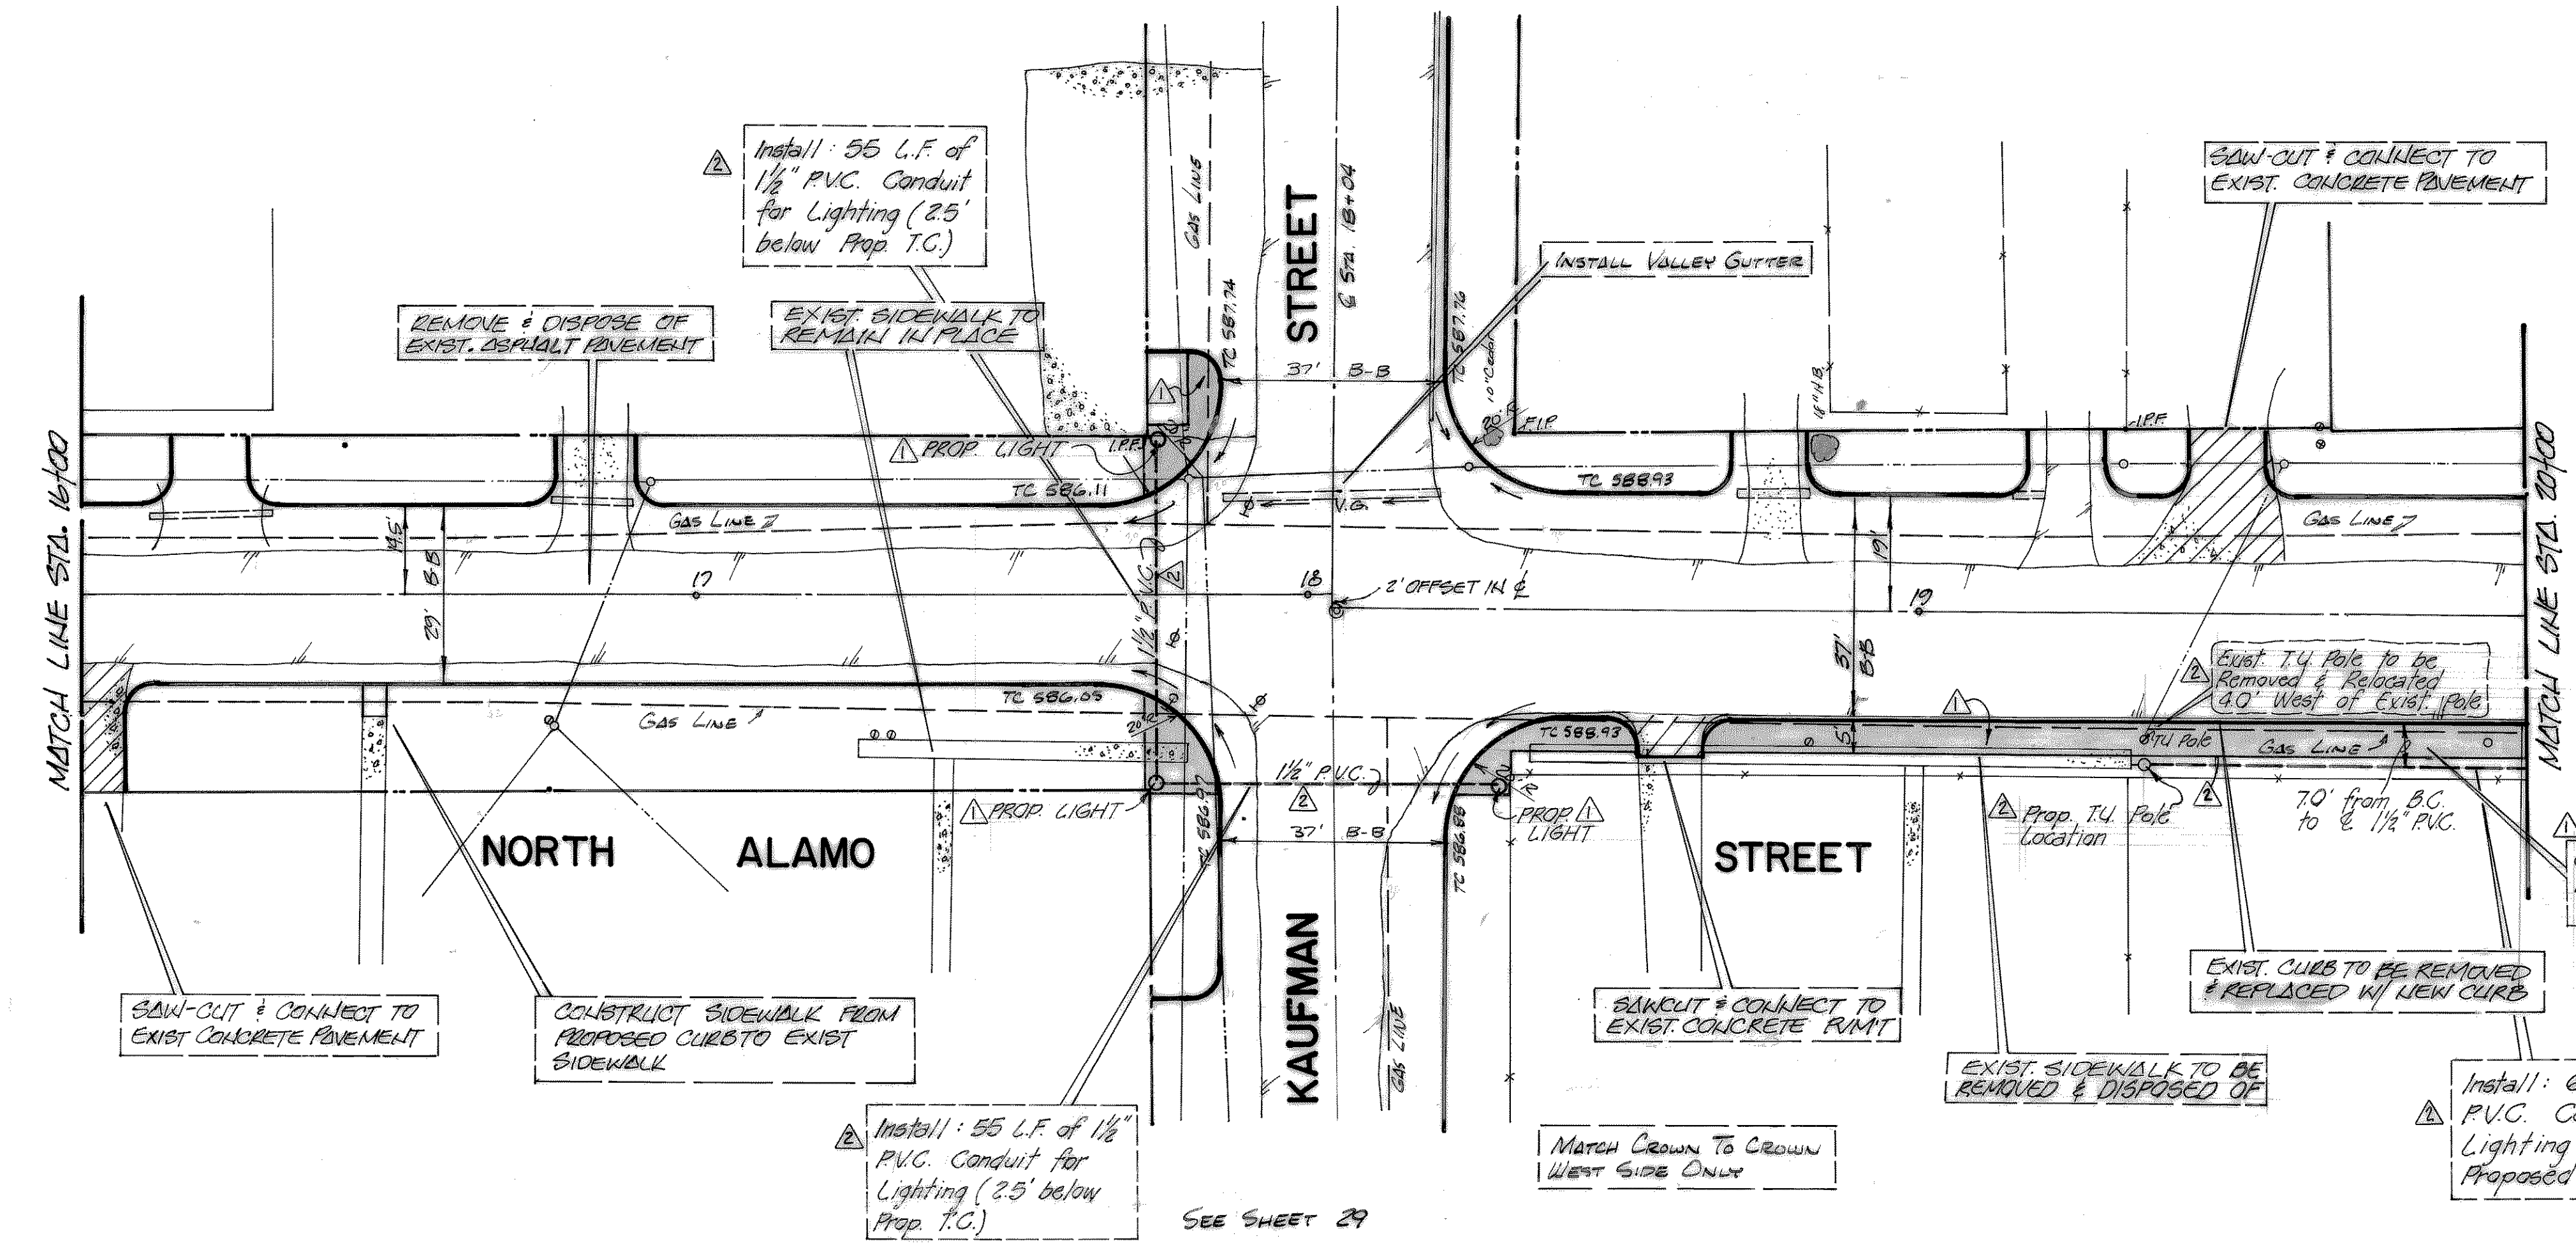


- NOTE: ALL PROPOSED CURB APPROACHES SHALL BE 12" WIDE & EXTENDED TO ROW LINE EXCEPT AS NOTED ON PLANS. CURBS SHALL BE CONSTRUCTED ON 6" 3500 P.S.I. CONCRETE REINFORCED W/ #5 BARS 24" O.C. BOTHWAYS
- NOTE: ALL RADII ON DRIVES WILL BE 5' EXCEPT AS NOTED ON PLANS
- NOTE: ALL UNDERGROUND UTILITIES TO BE RELOCATED OR ADJUSTED TO NEW PAVEMENT OR FINISH GRADE PRIOR TO ANY PAVEMENT CONSTRUCTION
- NOTE: ALL EXISTING DRAINAGE PIPES TO BE REMOVED & SALVAGED EXCEPT AS NOTED ON THE STORM SEWER DESIGN PLANS
- NOTE: POWER POLES & TELEPHONE BOXES TO BE RELOCATED BY OTHERS PRIOR TO CONSTRUCTION
- NOTE: ALL CONSTRUCTION SHALL MEET CITY OF ROCKWALL SPECIFICATIONS
- NOTE: CONTRACTOR SHALL HAVE ONE LANE REMAINED OPEN FOR TRAFFIC AT ALL TIMES
- NOTE: STREET CONSTRUCTION - 6" 3500 P.S.I. CONCRETE W/ #5 BARS 24" O.C. EA. WAY ON 6" STABILIZED LIME SUBGRADE W/ A MIN. OF 7% LIME

LEGEND:

- POWER POLE
- TELEPHONE BOX
- TELEPHONE M.H.
- GAS METER
- FIRE HYDRANT
- WATER METER
- WATER VALVE
- SANIT. SEWER M.H.

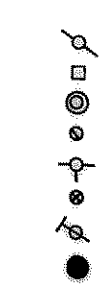

B.M. - BOLT ON FIRE HYDRANT @ SW. CORNER OF HEATH ST. N. ALAMO ST. ELEV. = 570.77

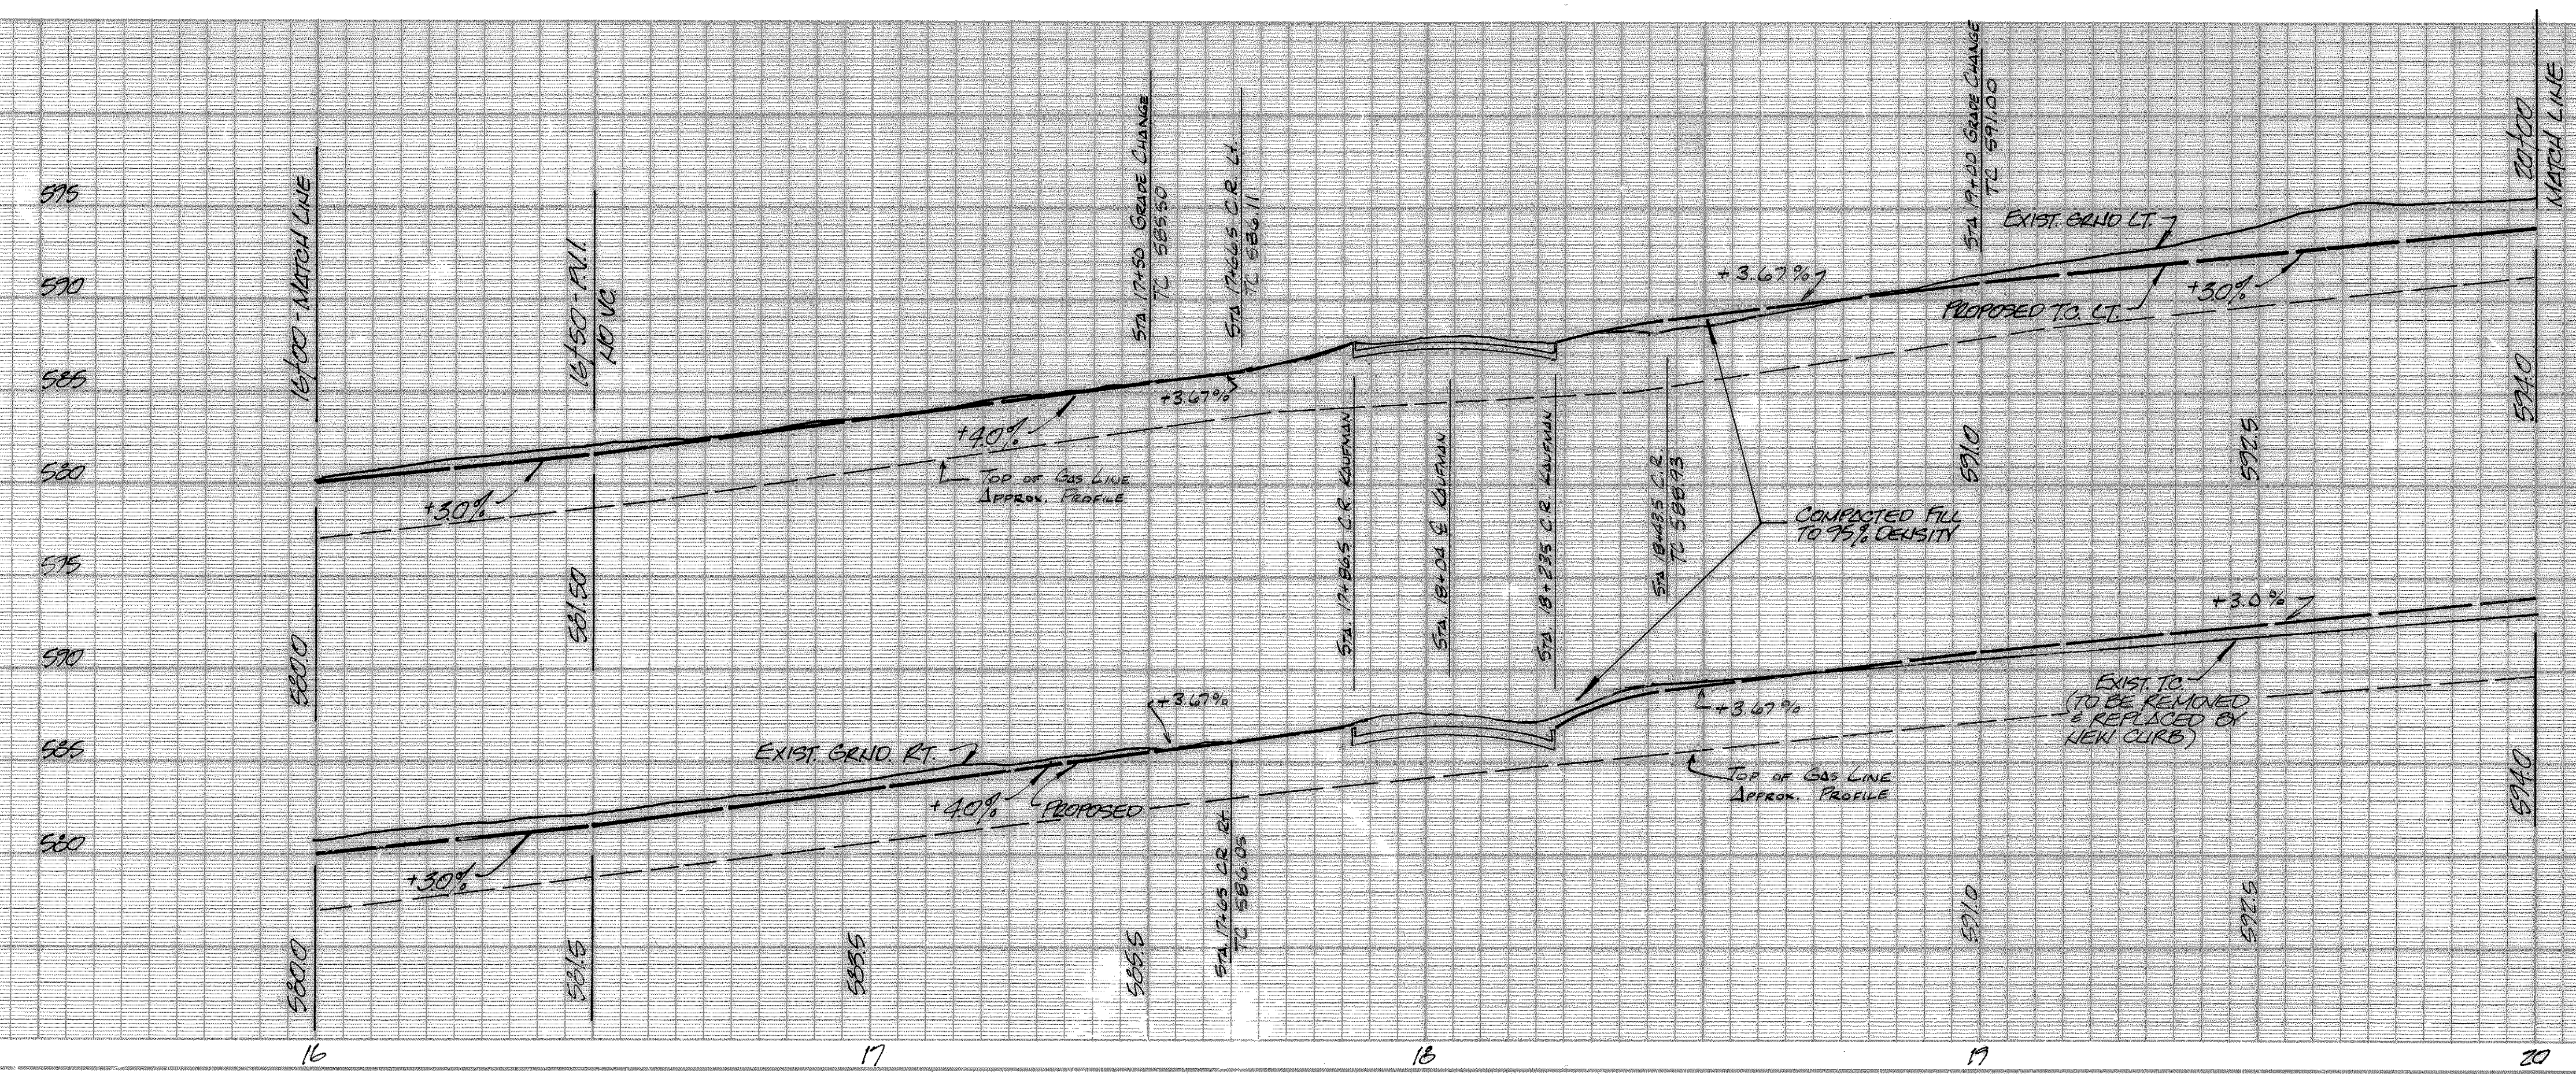

Remove & Relocate Exist. T&U Pole
Added 1 1/2" P.V.C. for Lighting
& Construction notes

REVISION NO.	REMARKS	DATE
1	Added 50' Wide Sidewalk & Prop. Lights	8/10/89
PAVING IMPROVEMENTS		
NORTH ALAMO STREET		
CITY OF ROCKWALL, TEXAS 205 W. RUSK STREET 214-722-1111		
DESIGNED: W.L.D.	SCALE: NOTED	
DRAWN: W.L.D.	DATE: 7-87	
JOB NO. 87008	SHEET NO. 11	