

NOTE: ALL PROPOSED DRIVE APPROACHES SHALL BE 12' WIDE & EXTENDED TO R.O.W. LINE EXCEPT AS NOTED ON PLANS. DRIVES SHALL BE CONSTRUCTED OF 6" - 3000 P.S.I. CONCRETE REINFORCED W/ #3 BARS @ 24" O.C. EACH WAY.

NOTE: ALL RADIUS ON DRIVES WILL BE 5' EXCEPT AS NOTED ON PLANS.

NOTE: ALL UNDERGROUND UTILITIES TO BE RELOCATED OR ADJUSTED TO NEW PAVEMENT OR PARKWAY GRADE PRIOR TO ANY PAVEMENT CONSTRUCTION.

NOTE: ALL EXISTING DRAINAGE PIPES TO BE REMOVED & SALVAGED EXCEPT AS NOTED ON THE STORM SEWER DESIGN PLANS.


NOTE: POWER POLES & TELEPHONE BOXES TO BE RELOCATED BY OTHERS PRIOR TO CONSTRUCTION.

NOTE: ALL CONSTRUCTION SHALL MEET CITY OF ROCKWALL SPECIFICATIONS.

NOTE: CONTRACTOR TO HAVE ONE LANE REMAINED OPEN FOR TRAFFIC AT ALL TIMES.

NOTE: STREET CONSTRUCTION - 6" 3500 P.S.I. CONCRETE W/ #3 BARS 24" C.C. EACH WAY ON 6" LIME STABILIZED SUBGRADE W/ 1 MIN. OF 7% LIME.

Q CURVE DATA
 $\Delta = 1^\circ 54' 29''$
 $R = 1804.08'$
 $T = 30.0'$
 $L = 59.98'$

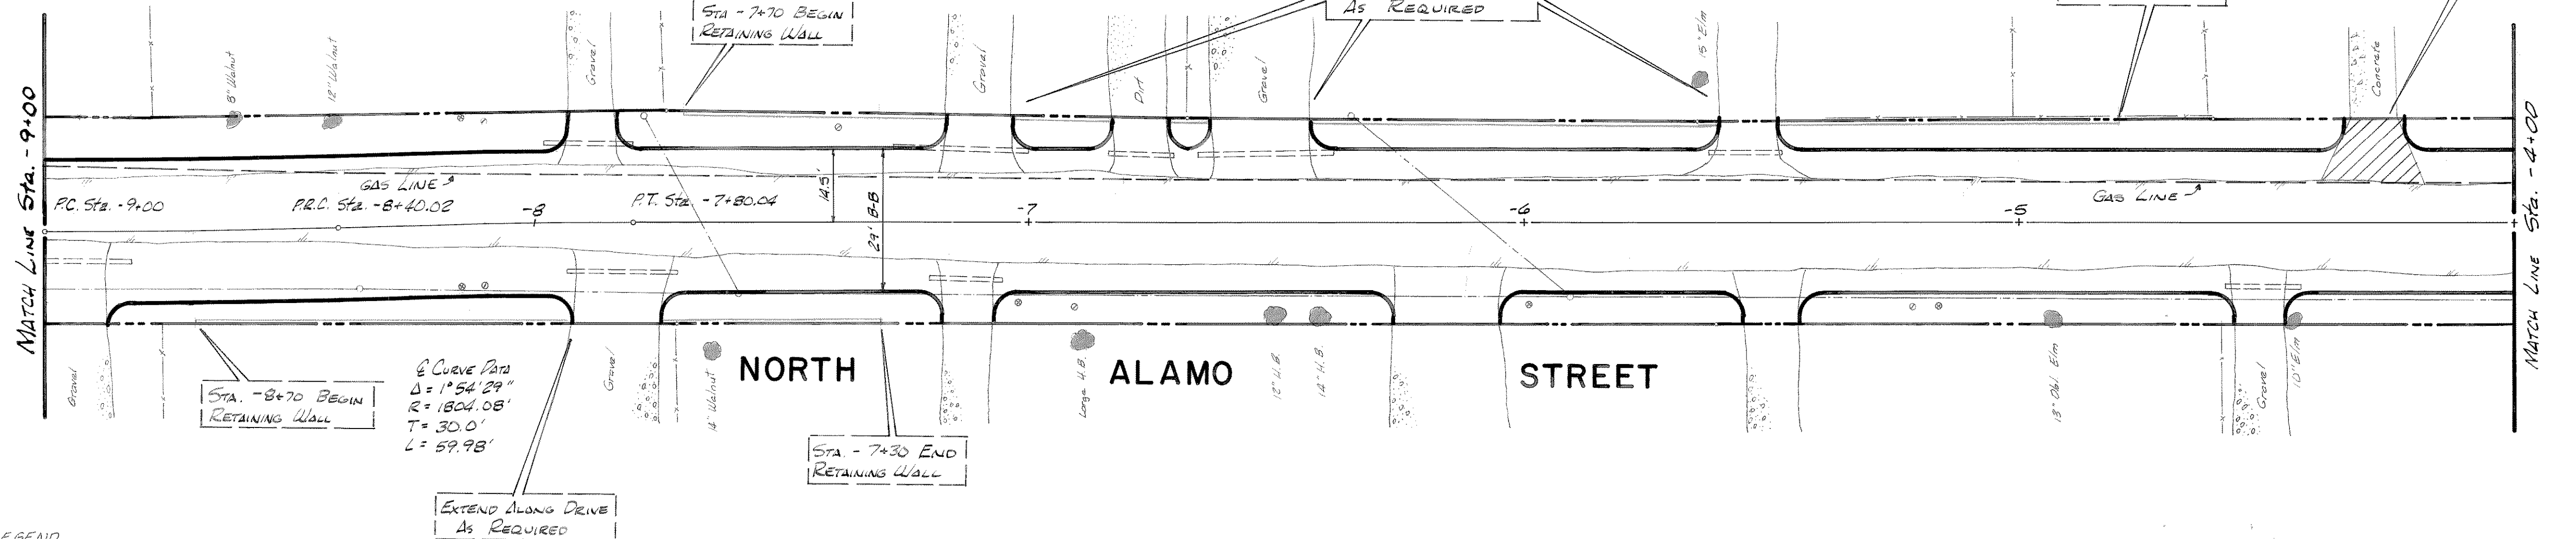


LEGEND

Power Pole
Telephone Box
Telephone M.H.
Gas Meter
Fire Hydrant
Water Meter
Water Valve
Sewer M.H.

SCALE 1" = 20' H.
1" = 5' V.

B.M. - Bolt on Fire Hydrant @
S.W. Corner of Heath Street @
N. Alamo St. Elev. = 570.77

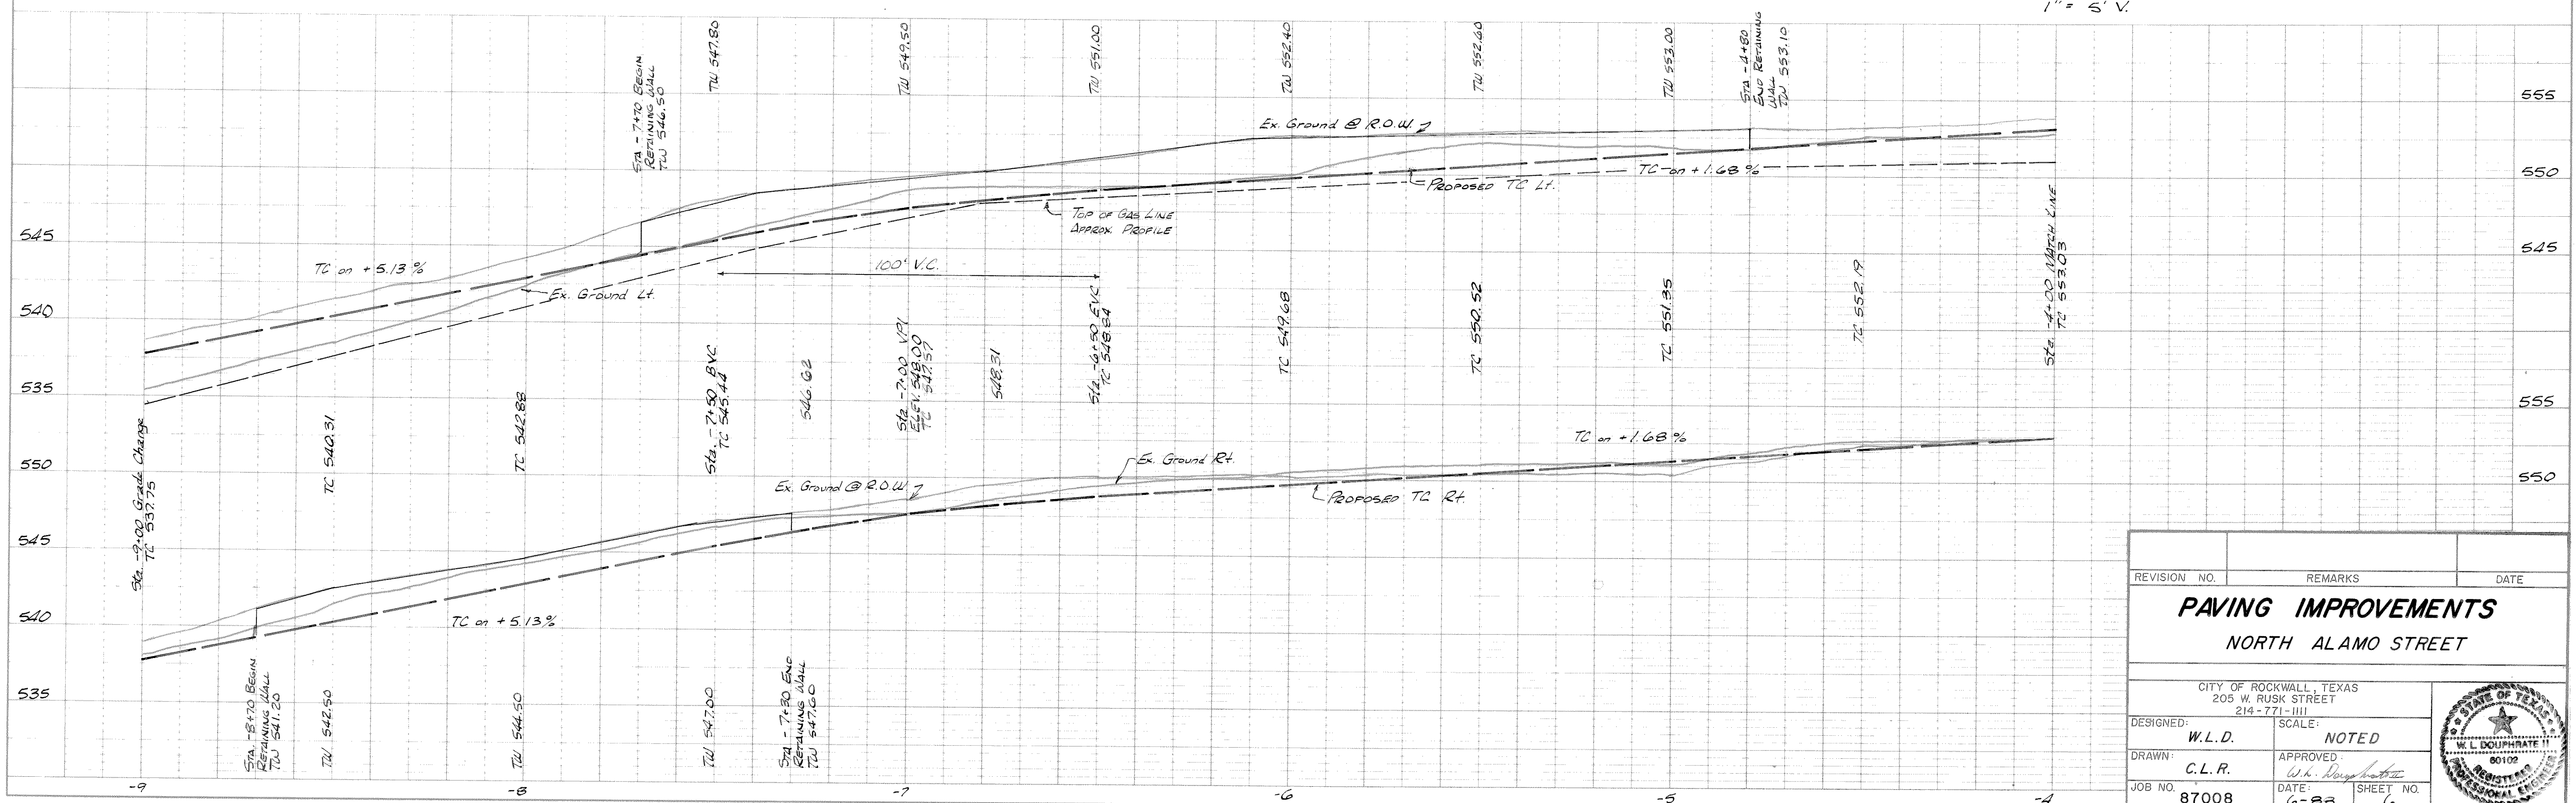

REVISION NO.	REMARKS	DATE
PAVING IMPROVEMENTS NORTH ALAMO STREET		
CITY OF ROCKWALL, TEXAS 205 W. RUSK STREET 214-771-1111		
DESIGNED:	W.L.D.	SCALE: NOTED
DRAWN:	C.L.R.	APPROVED: W.L. Dougherty
JOB NO.	87008	DATE: 6-88
		SHEET NO. 6