


PLAN	DATE	
	BY	
	REVISION	
	NO.	

PROFILE	DATE	
	BY	
	REVISION	
	NO.	

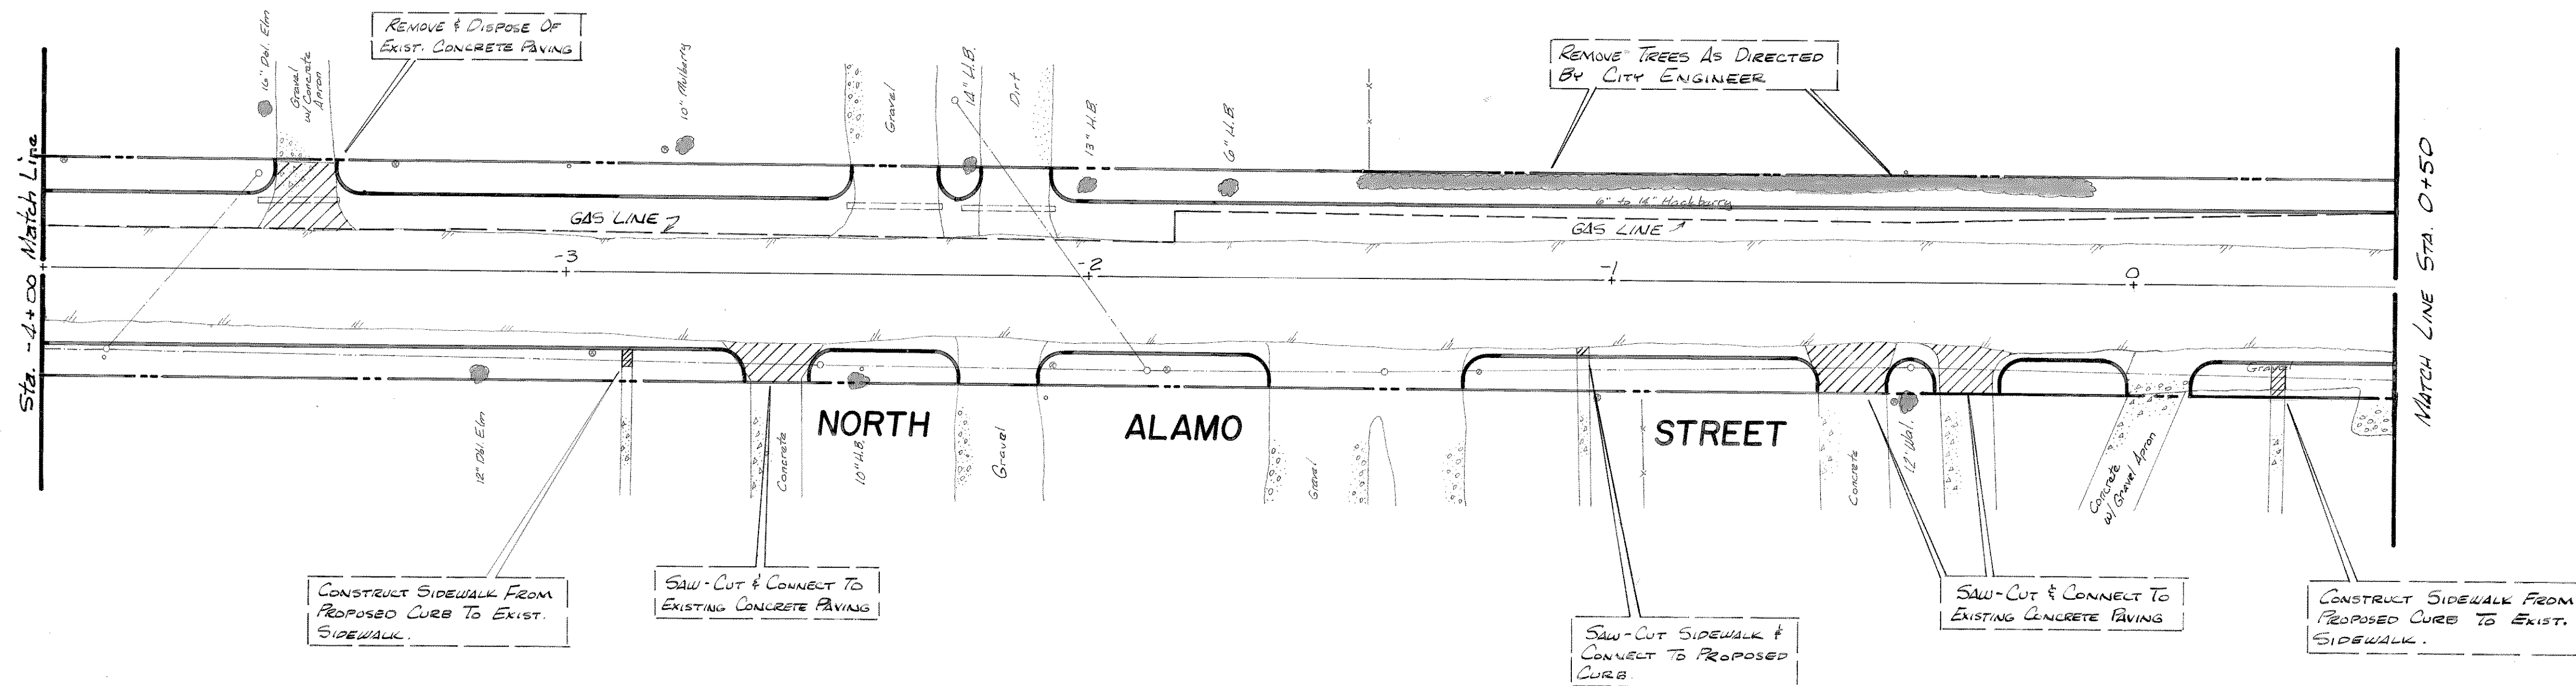

NOTE: ALL PROPOSED DRIVE APPROACHES SHALL BE 12' WIDE & EXTENDED TO R.O.W. LINE EXCEPT AS NOTED ON PLANS. DRIVES SHALL BE CONSTRUCTED OF 6" - 3500 P.S.I. CONCRETE REINFORCED W/ #3 BARS ON 24" O.C. EACH WAY.

NOTE: ALL RADII ON DRIVES WILL BE 5' EXCEPT AS NOTED ON PLANS.

NOTE: ALL UNDERGROUND UTILITIES TO BE RELOCATED OR ADJUSTED TO NEW PAVEMENT OR PARKWAY GRADE PRIOR TO ANY PAVEMENT CONSTRUCTION.

NOTE: ALL EXISTING DRAINAGE PIPES TO BE REMOVED & SALVAGED EXCEPT AS NOTED ON THE STORM SEWER DESIGN PLANS.

NOTE: POWER POLES & TELEPHONE BOXES TO BE RELOCATED BY OTHERS PRIOR TO CONSTRUCTION.

NOTE: ALL CONSTRUCTION SHALL MEET CITY OF ROCKWALL SPECIFICATIONS.

NOTE: CONTRACTOR SHALL HAVE ONE LANE REMAINED OPEN FOR TRAFFIC AT ALL TIMES.

NOTE: STREET CONSTRUCTION - 6" 3500 P.S.I. CONCRETE W/ #3 BARS ON 24" C-C EACH WAY ON 6" LIME STABILIZED SUBGRADE W/ A MINIMUM OF 7% LIME.


NOTE: EXISTING ASPHALT PAVEMENT TO BE REMOVED & DISPOSED OF OFF-SITE.

LEGEND

- Power Pole
- Telephone Box
- Telephone M.H.
- Gas Meter
- Fire Hydrant
- Water Meter
- Water Valve
- San. Sewer M.H.

SCALE 1" = 20' H.
1" = 5' V.

B.M. - Bolt on Fire Hydrant @ S.W. Corner of Heath Street @ N. Alamo St. Elev. = 570.77

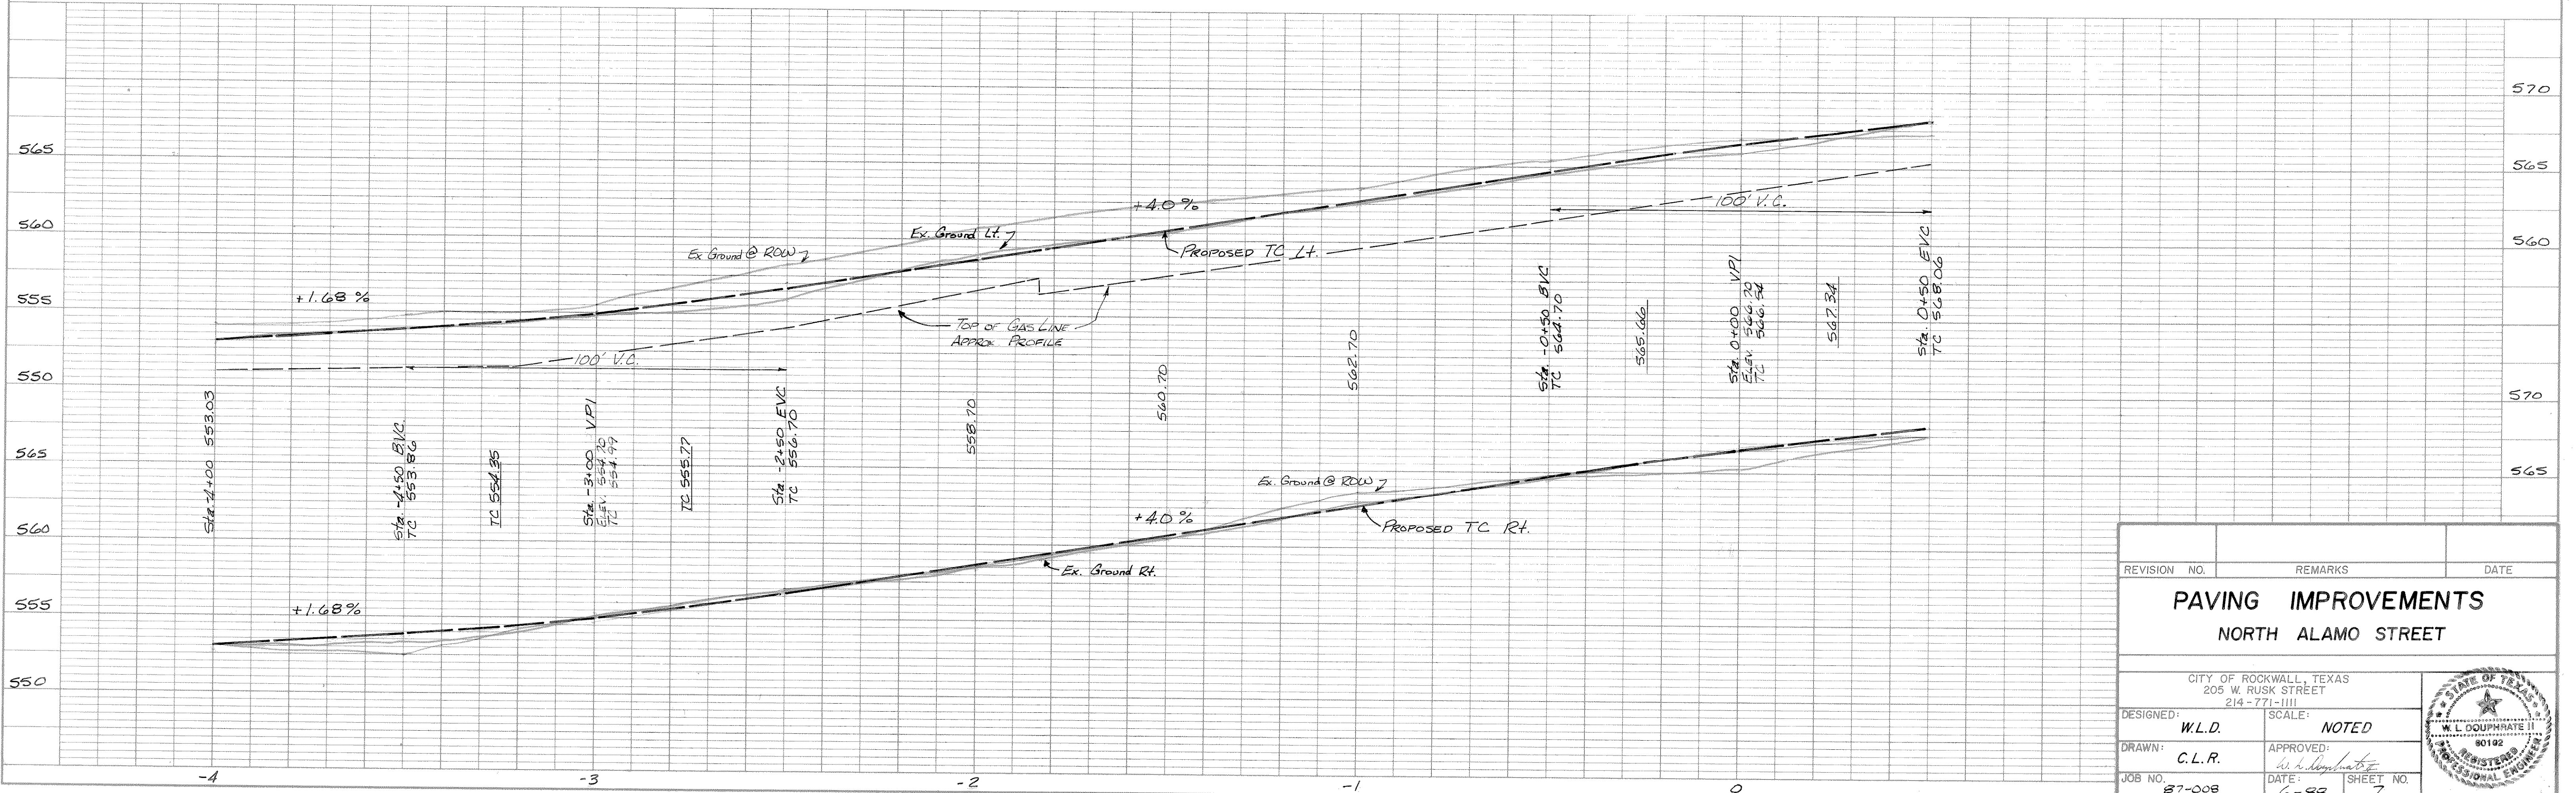

REVISION NO.	REMARKS	DATE
PAVING IMPROVEMENTS NORTH ALAMO STREET		
CITY OF ROCKWALL, TEXAS 205 W. RUSK STREET 214-771-1111		
DESIGNED: W.L.D.	NOTED	
DRAWN: C.L.R.	APPROVED: <i>[Signature]</i>	
JOB NO. 87-008	DATE 6-88	SHEET NO. 7