
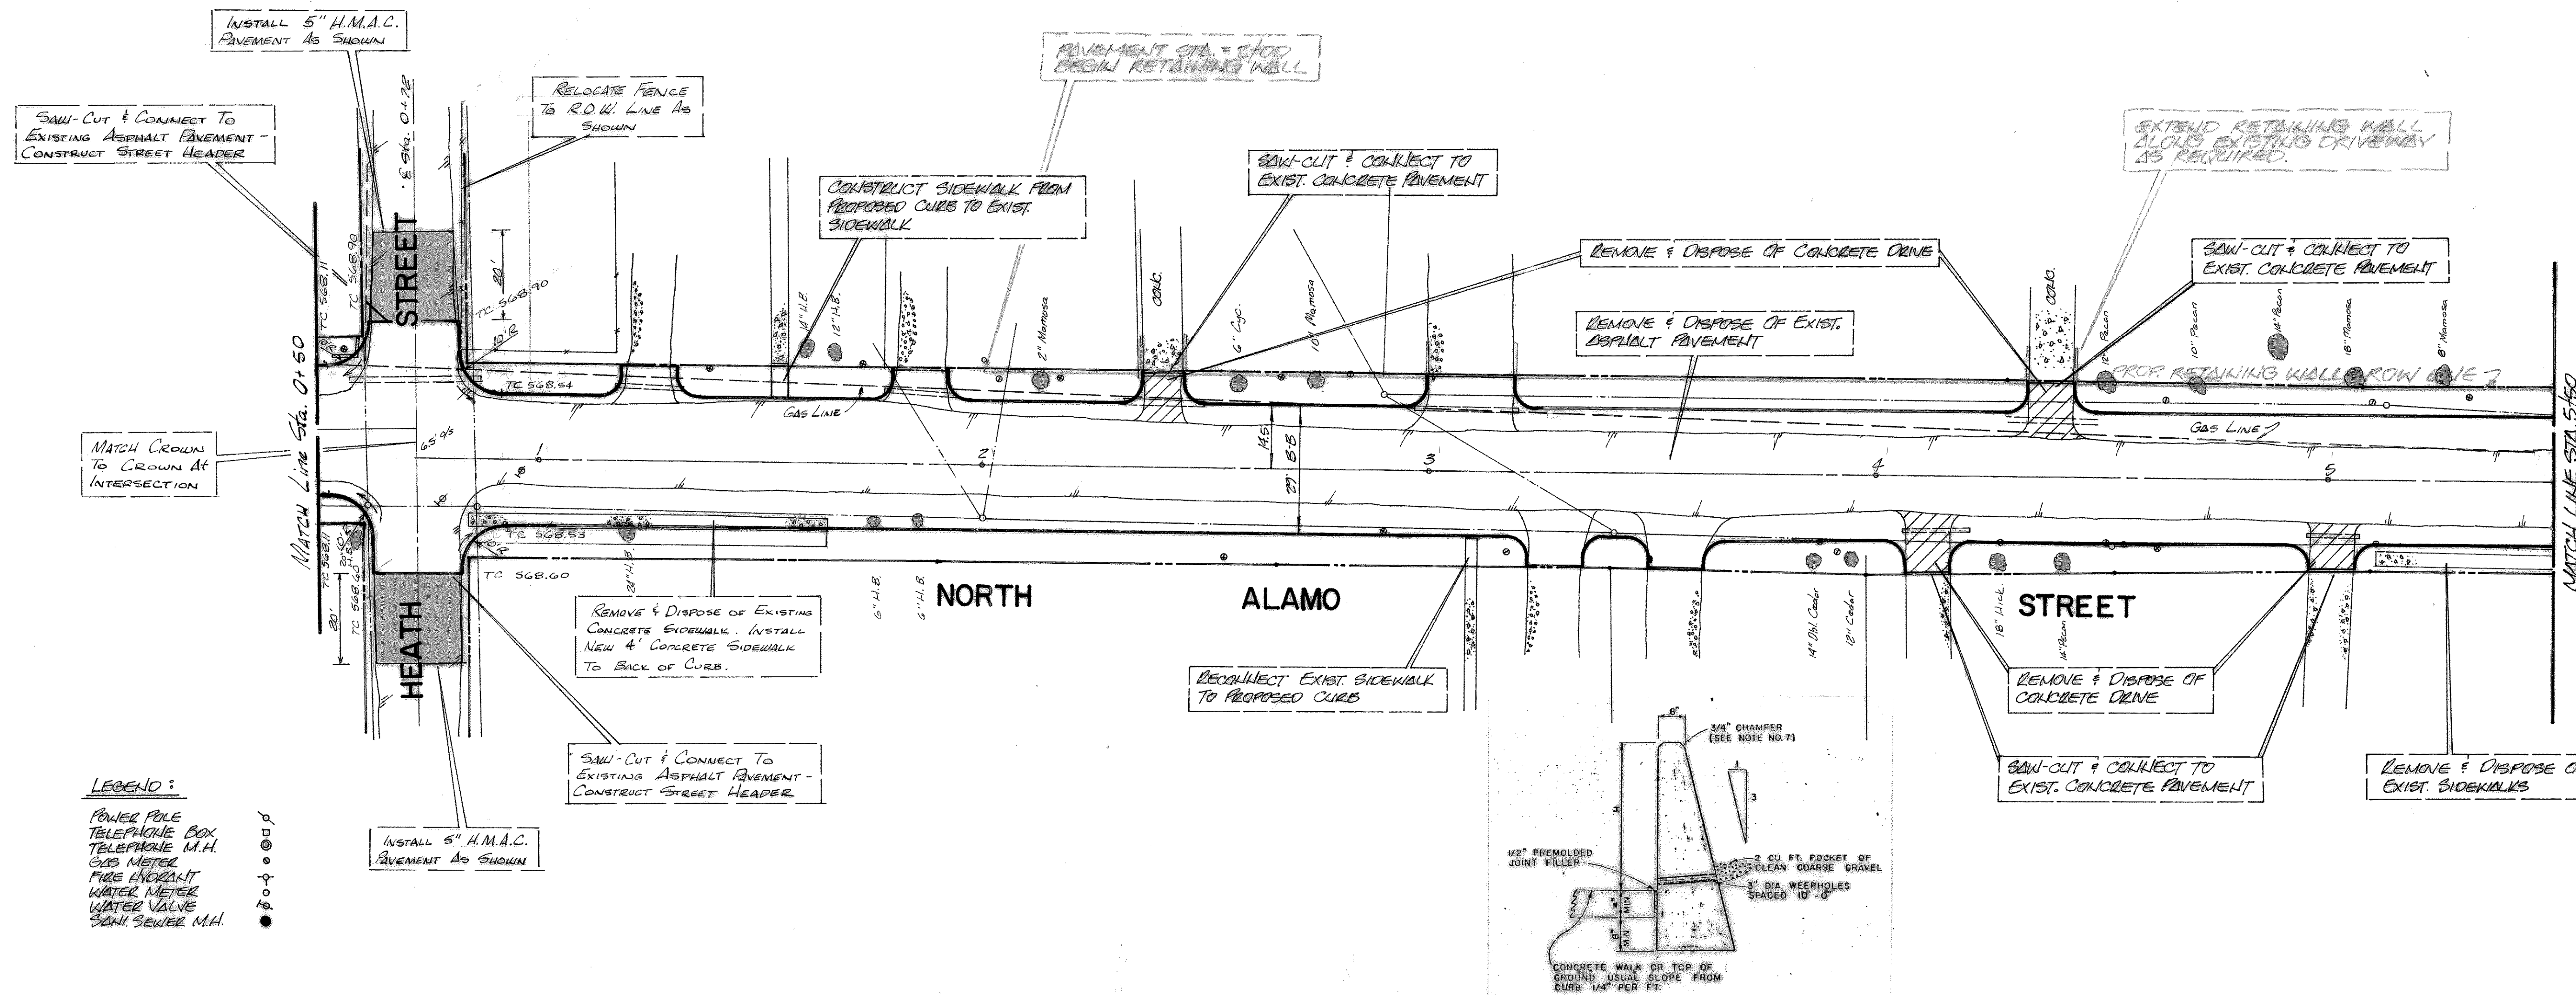


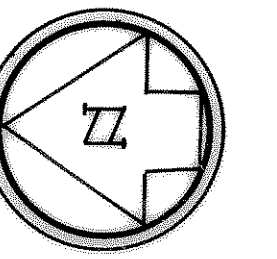

NOTE: ALL PROPOSED DRIVE APPROACHES SHALL BE 12' WIDE & EXTENDED TO ROW LINE EXCEPT AS NOTED ON PLANS. DRIVES SHALL BE CONST. OF 8" 5000 P.S.I. CONCRETE REINFORCED W/ #5 BARS 24" O.C. BOTHWAYS.

NOTE: ALL 2000 CU. DRIVES WILL BE 5' EXCEPT AS NOTED ON PLANS.

NOTE: ALL UNDERGROUND UTILITIES TO BE RELOCATED OR ADJUSTED TO NEW PAVEMENT OR ROADWAY GRADE PRIOR TO ANY PAVEMENT CONSTRUCTION.

NOTE: ALL EXISTING DRAINAGE PIPES TO BE REMOVED & SALVAGED EXCEPT AS NOTED ON THE STORM SEWER DESIGN PLANS.

NOTE: POWER POLES & TELEPHONE BOXES TO BE RELOCATED BY OTHERS PRIOR TO CONSTRUCTION.

NOTE: ALL CONSTRUCTION SHALL MEET CITY OF ROCKWALL SPECIFICATIONS.

NOTE: CONTRACTOR SHALL HAVE ONE LANE REMAINED OPEN FOR TRAFFIC AT ALL TIMES.


NOTE: STREET CONSTRUCTION - 6" 5000 P.S.I. CONCRETE W/ #5 BARS 24" O.C. ED. WAY ON 6" STABILIZED LINE SUBGRADE W/ A MIN. OF 7% LINE.

NOTE: ALL PROP. DRIVEWAY WIDTHS ON NORTH ALAMO SHALL MATCH THE WIDTH OF THE EXISTING DRIVEWAYS W/ A MINIMUM WIDTH OF 12'.

NOTE: EXIST. ASPHALT PAV'T TO BE REMOVED & DISPOSED OF OFF-SITE.

LEGEND:

POWER POLE
TELEPHONE BOX
TELEPHONE M.H.
GAS METER
FIRE HYDRANT
WATER METER
WATER VALVE
SEWER M.H.

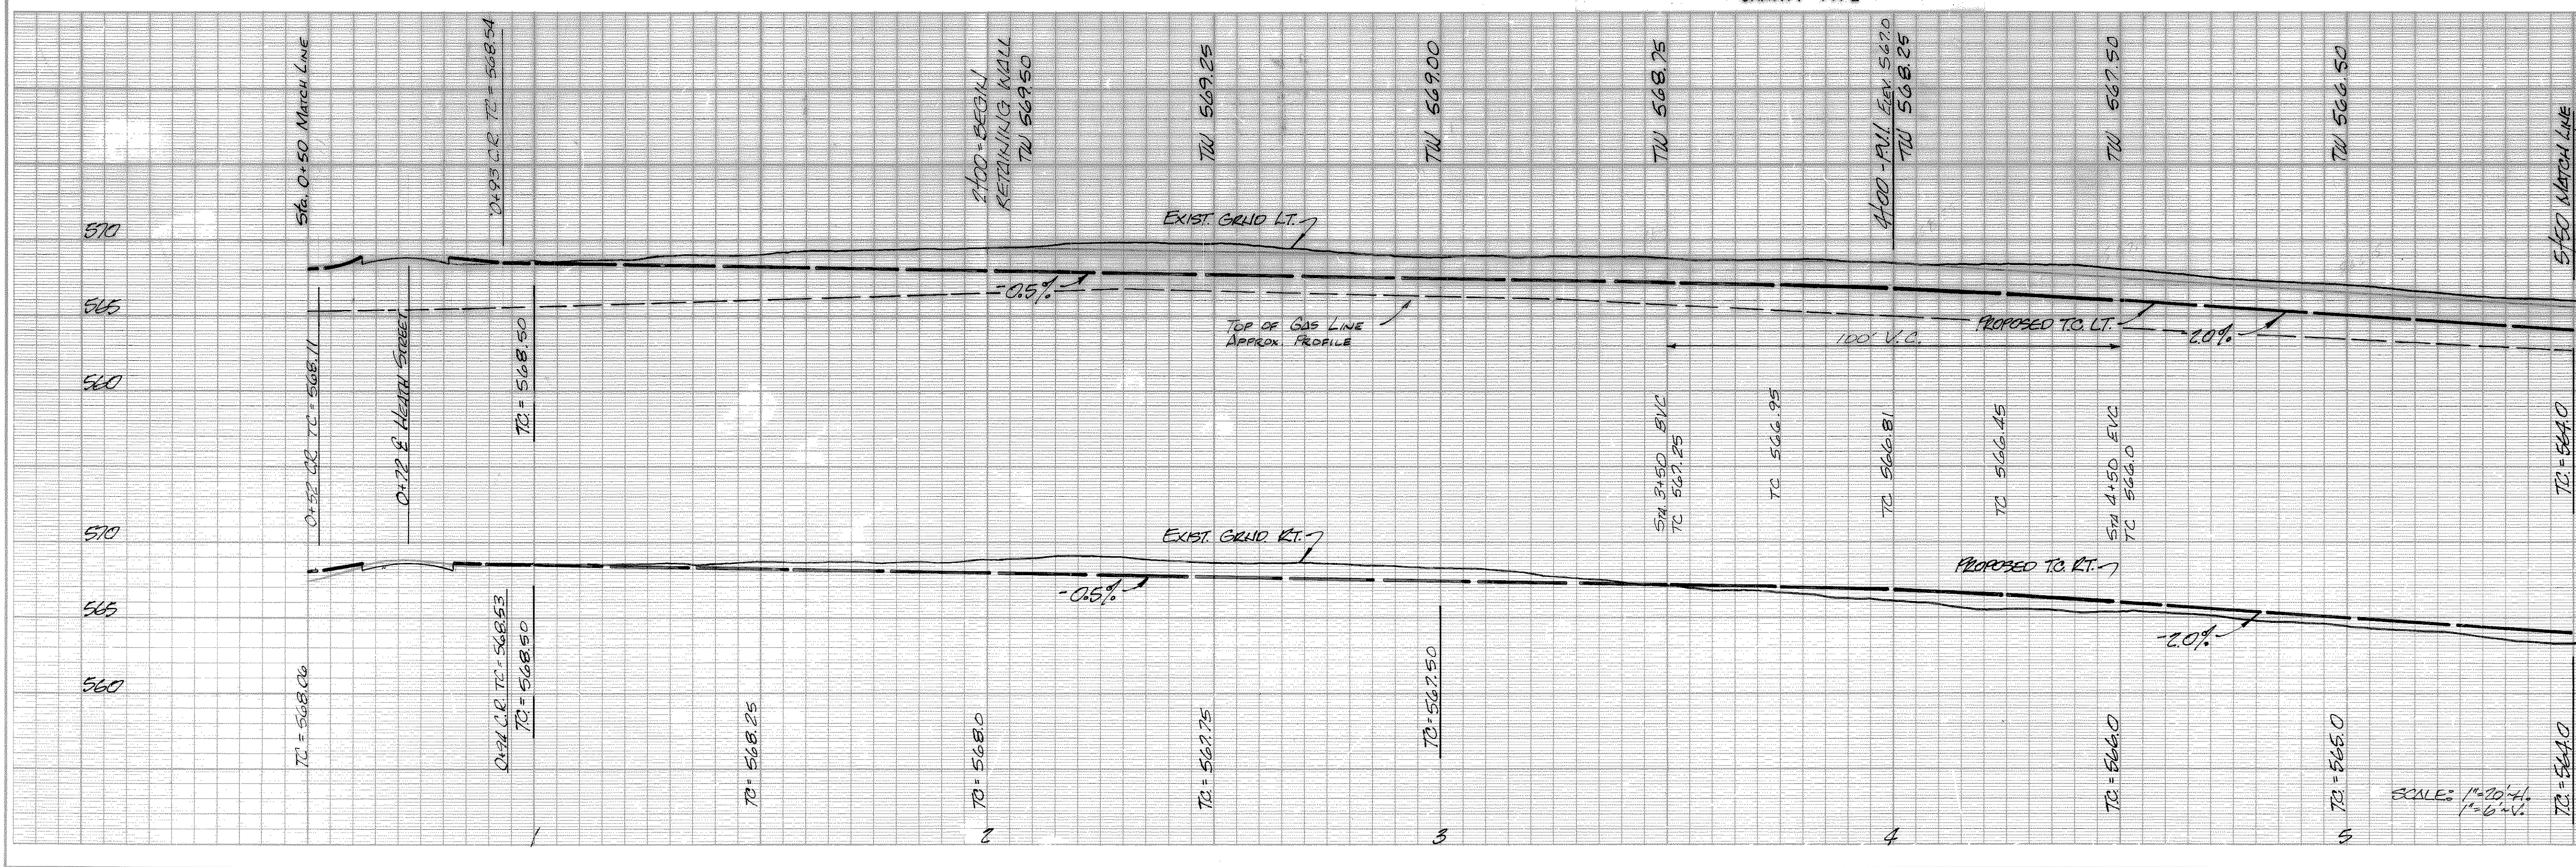

Add N. Alamo North to Live Oak		6-88
REVISION NO.	REMARKS	DATE
PAVING IMPROVEMENTS		
NORTH ALAMO STREET		
CITY OF ROCKWALL, TEXAS 205 W. RUSK STREET 214-722-1111		
DESIGNED:	W. L. D.	NOTED
DRAWN:	W. L. D.	APPROVED
JOB NO.	87008	DATE: 7-87
		SHEET NO. 3

SCALE: 1"=20'-H, 1"=6'-V

STATE OF TEXAS
W. L. DOLPHREY
REGISTERED PROFESSIONAL ENGINEER
90102